


Area shown stopped
by 13/4/82

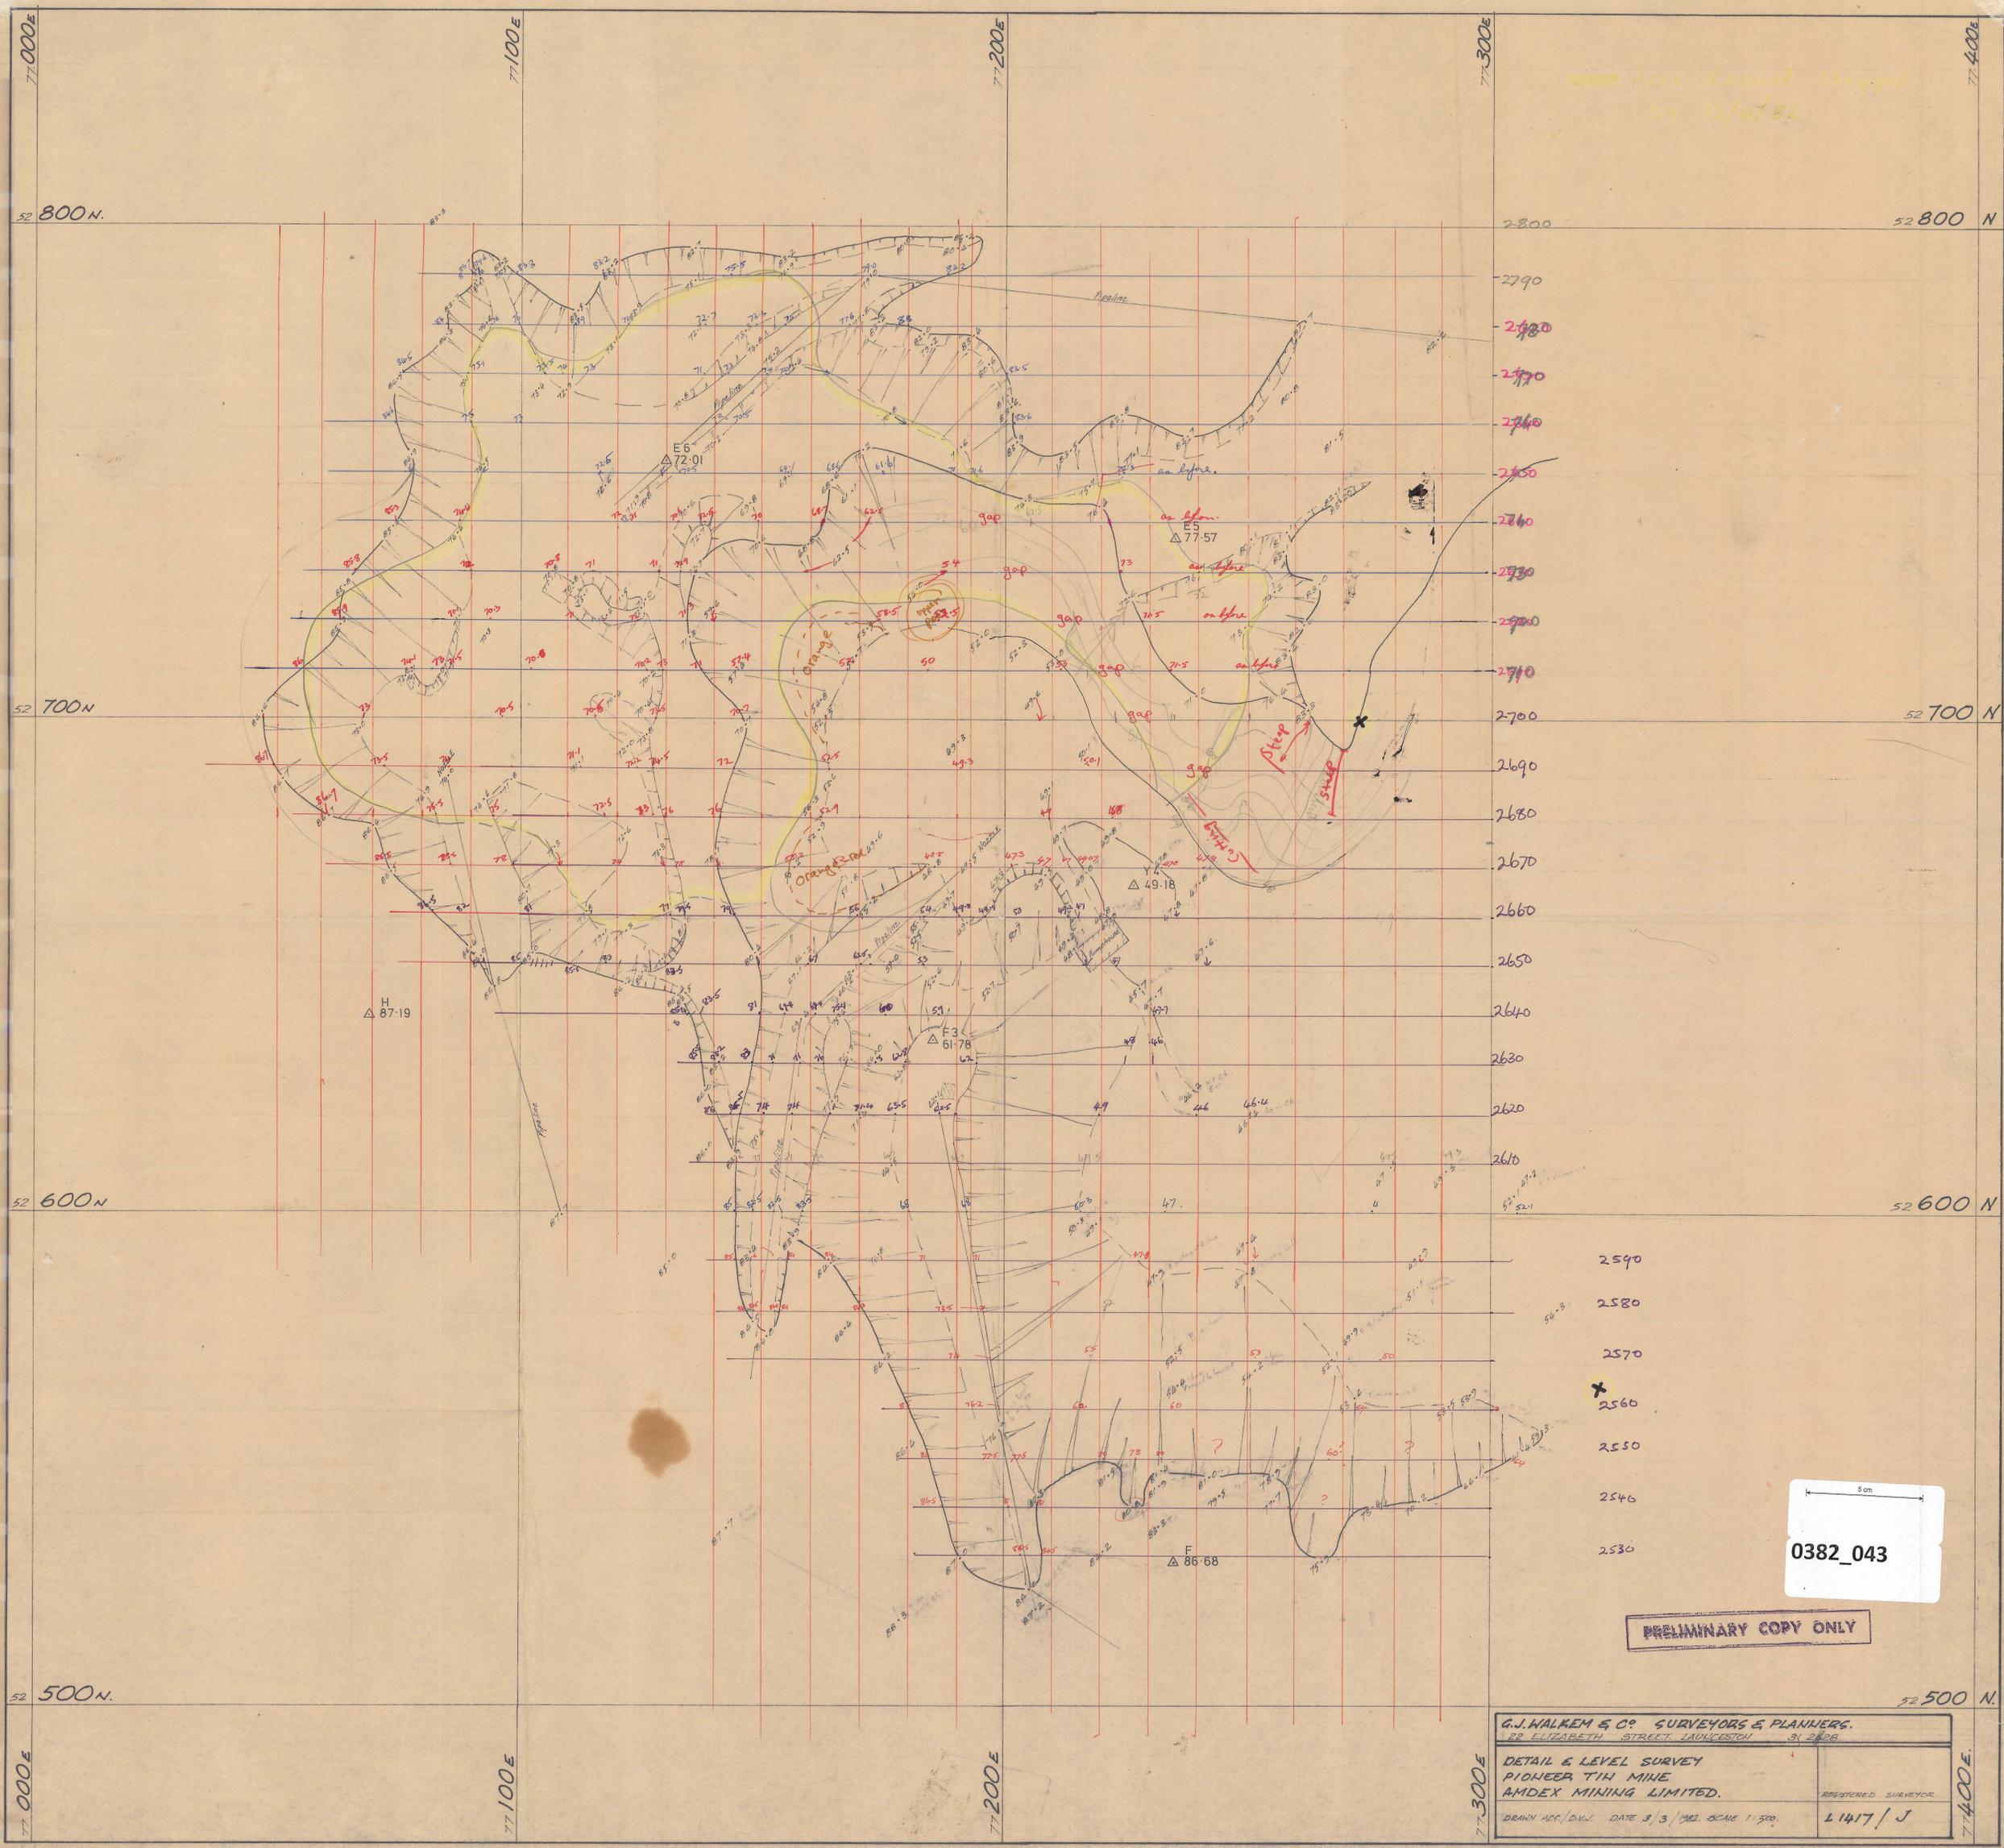

0382_043

5 cm
0382_043

PRELIMINARY COPY ONLY

G.J. WALKER & CO. SURVEYORS & PLANNERS.
22 ELIZABETH STREET LAUNCESTON 31 2400
REGISTERED SURVEYOR
L1417/J
DRAWN ACC. DWG. DATE 3/3/82. SCALE 1:500.