

52 800 N.

52 800 N

52 700 N

52 700 N

52 600 N

52 600 N

52 500 N.

52 500 N.


77 000 E

77 100 E

77 200 E

77 300 E

77 400 E

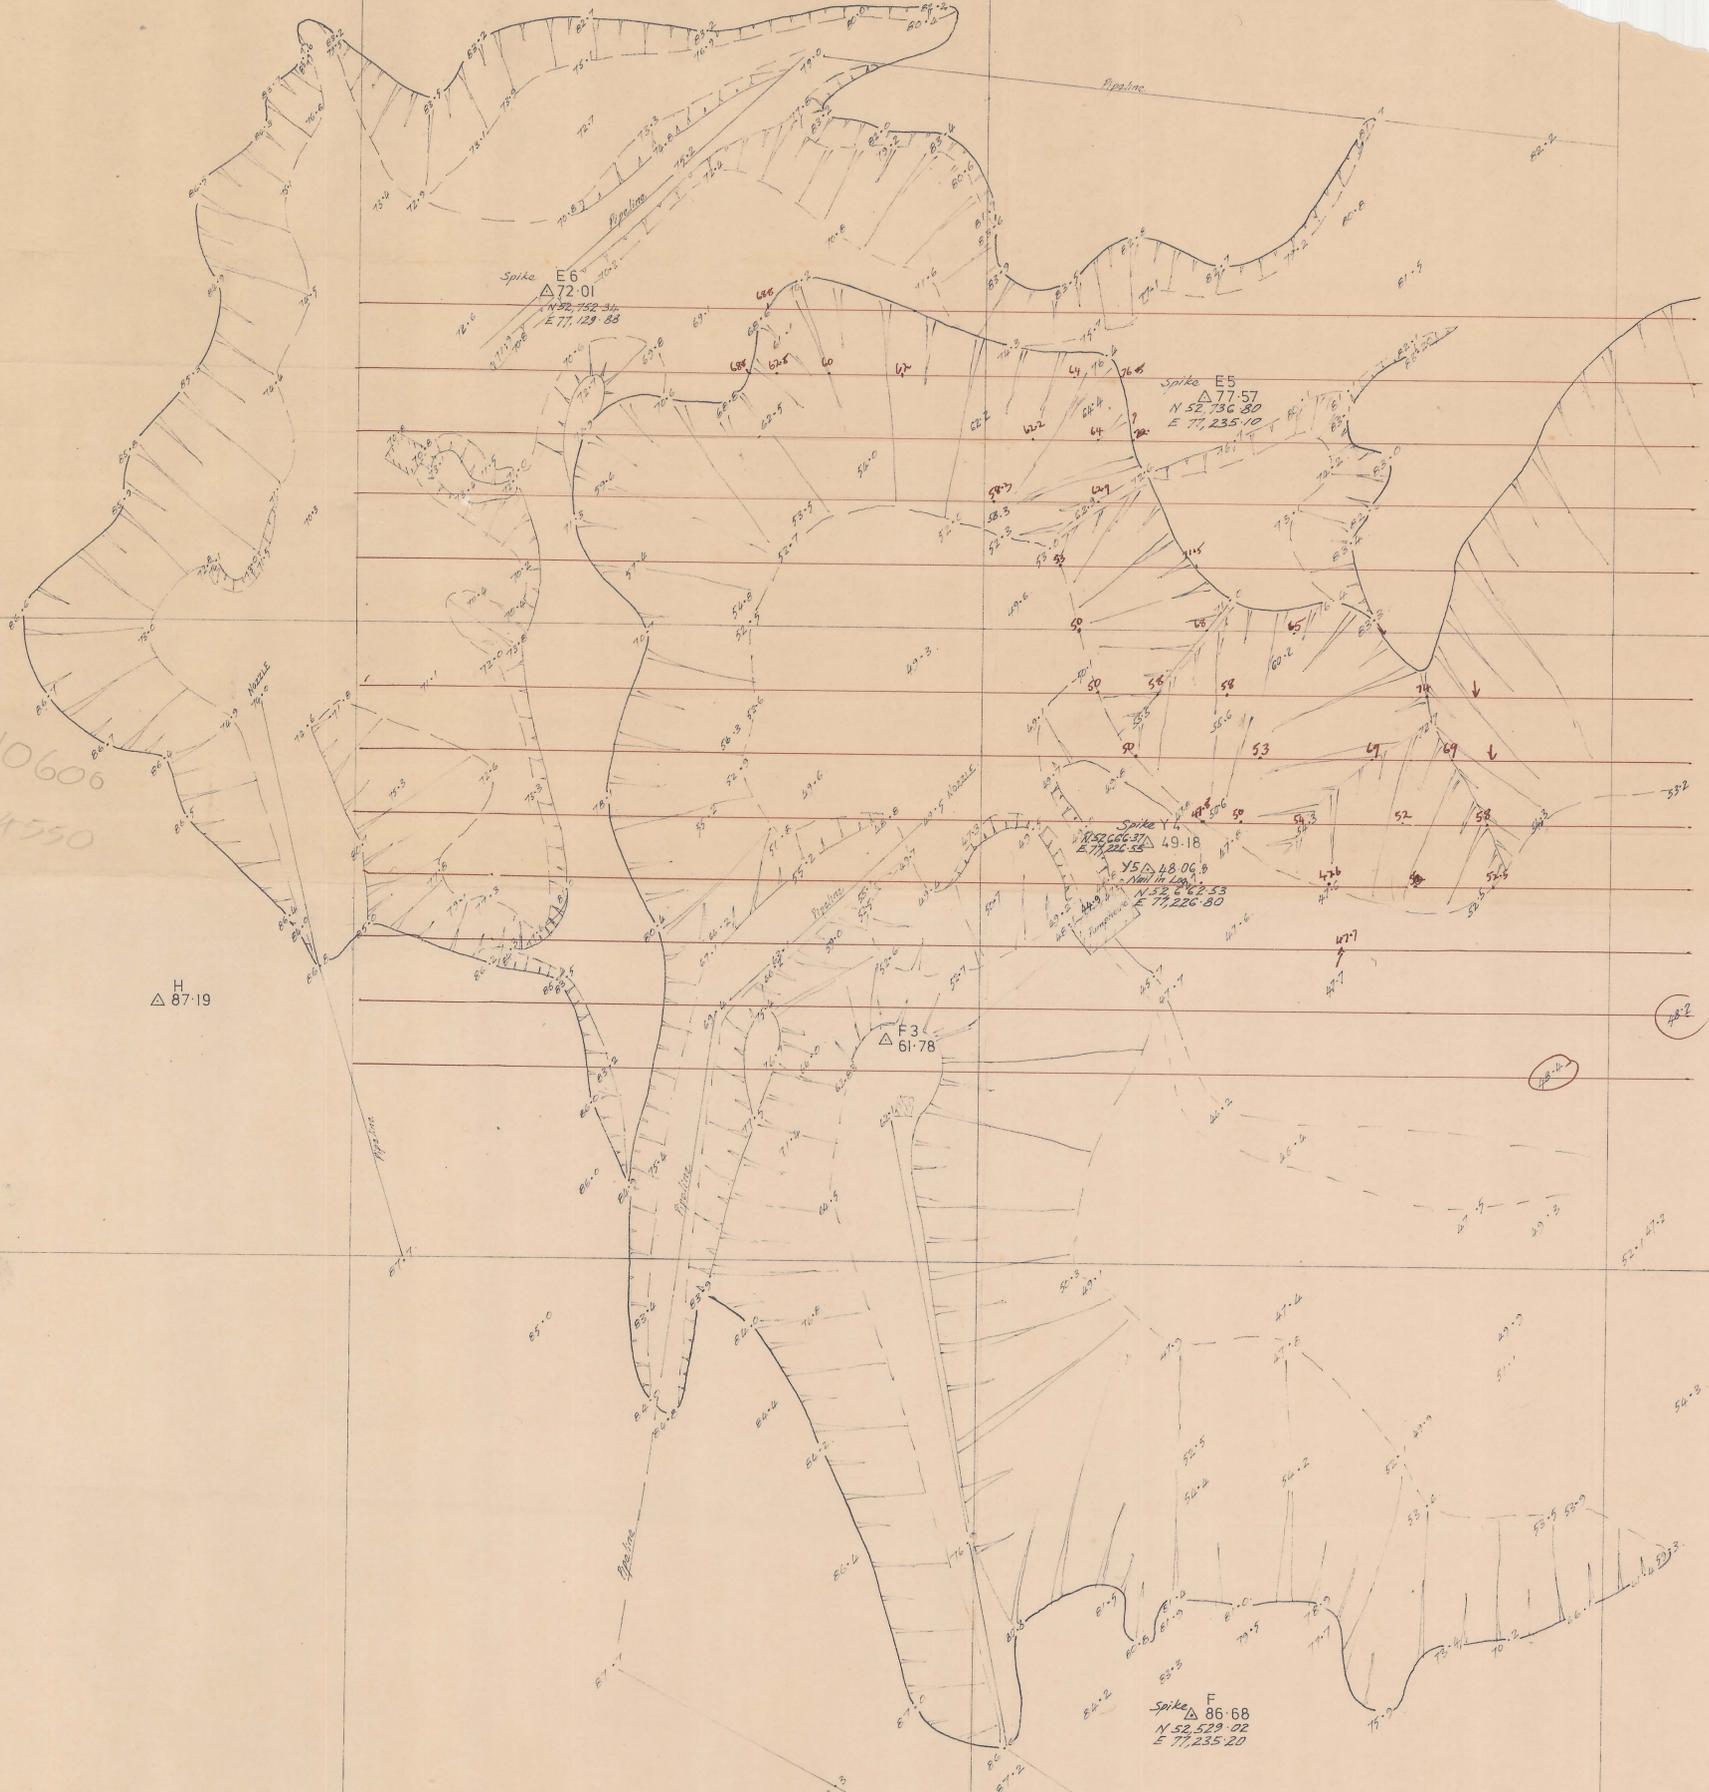

10
9999
34
100 00
34 05
73 400
10606
4550

Spike E6
Δ 72.01
N 92, 752.34
E 77, 129.85

Spike E5
Δ 77.57
N 52, 730.80
E 77, 235.10


Spike Y4
Δ 49.18
N 52, 606.37
E 77, 225.55
N 55, 48.06
E 77, 226.80

F3
Δ 61.78

Spike F
Δ 86.68
N 52, 529.22
E 77, 235.20

H
Δ 87.19

0382_045

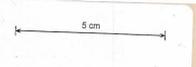

G.J. WALKER & CO SURVEYORS & PLANNERS.
82 ELIZABETH STREET LAUNCESTON 31 205.
DETAIL & LEVEL SURVEY
PIONEER TIN MINE
AMDIX MINING LIMITED.
DRAWN ACC. DWG. DATE 9/3/62 SCALE 1:500
L 1417 / J

0382_045