


0382_057



K20 ○ 115, 29 Kibuka drill hole, 115' deep,
 .29 lb SnO₂ (70% Sn)/cu.yd. overall grade
 Intervals assaying > 0.1 lb SnO₂/cu.yd.

○ (5-15, 3)

K Kibuka drilling 1977
 S Storey's Ck. drilling 1961
 A Austral Malay drilling 1935
 P Pioneer Mines drilling, pre 1930
 + Yellow pegs marking stripping boundary

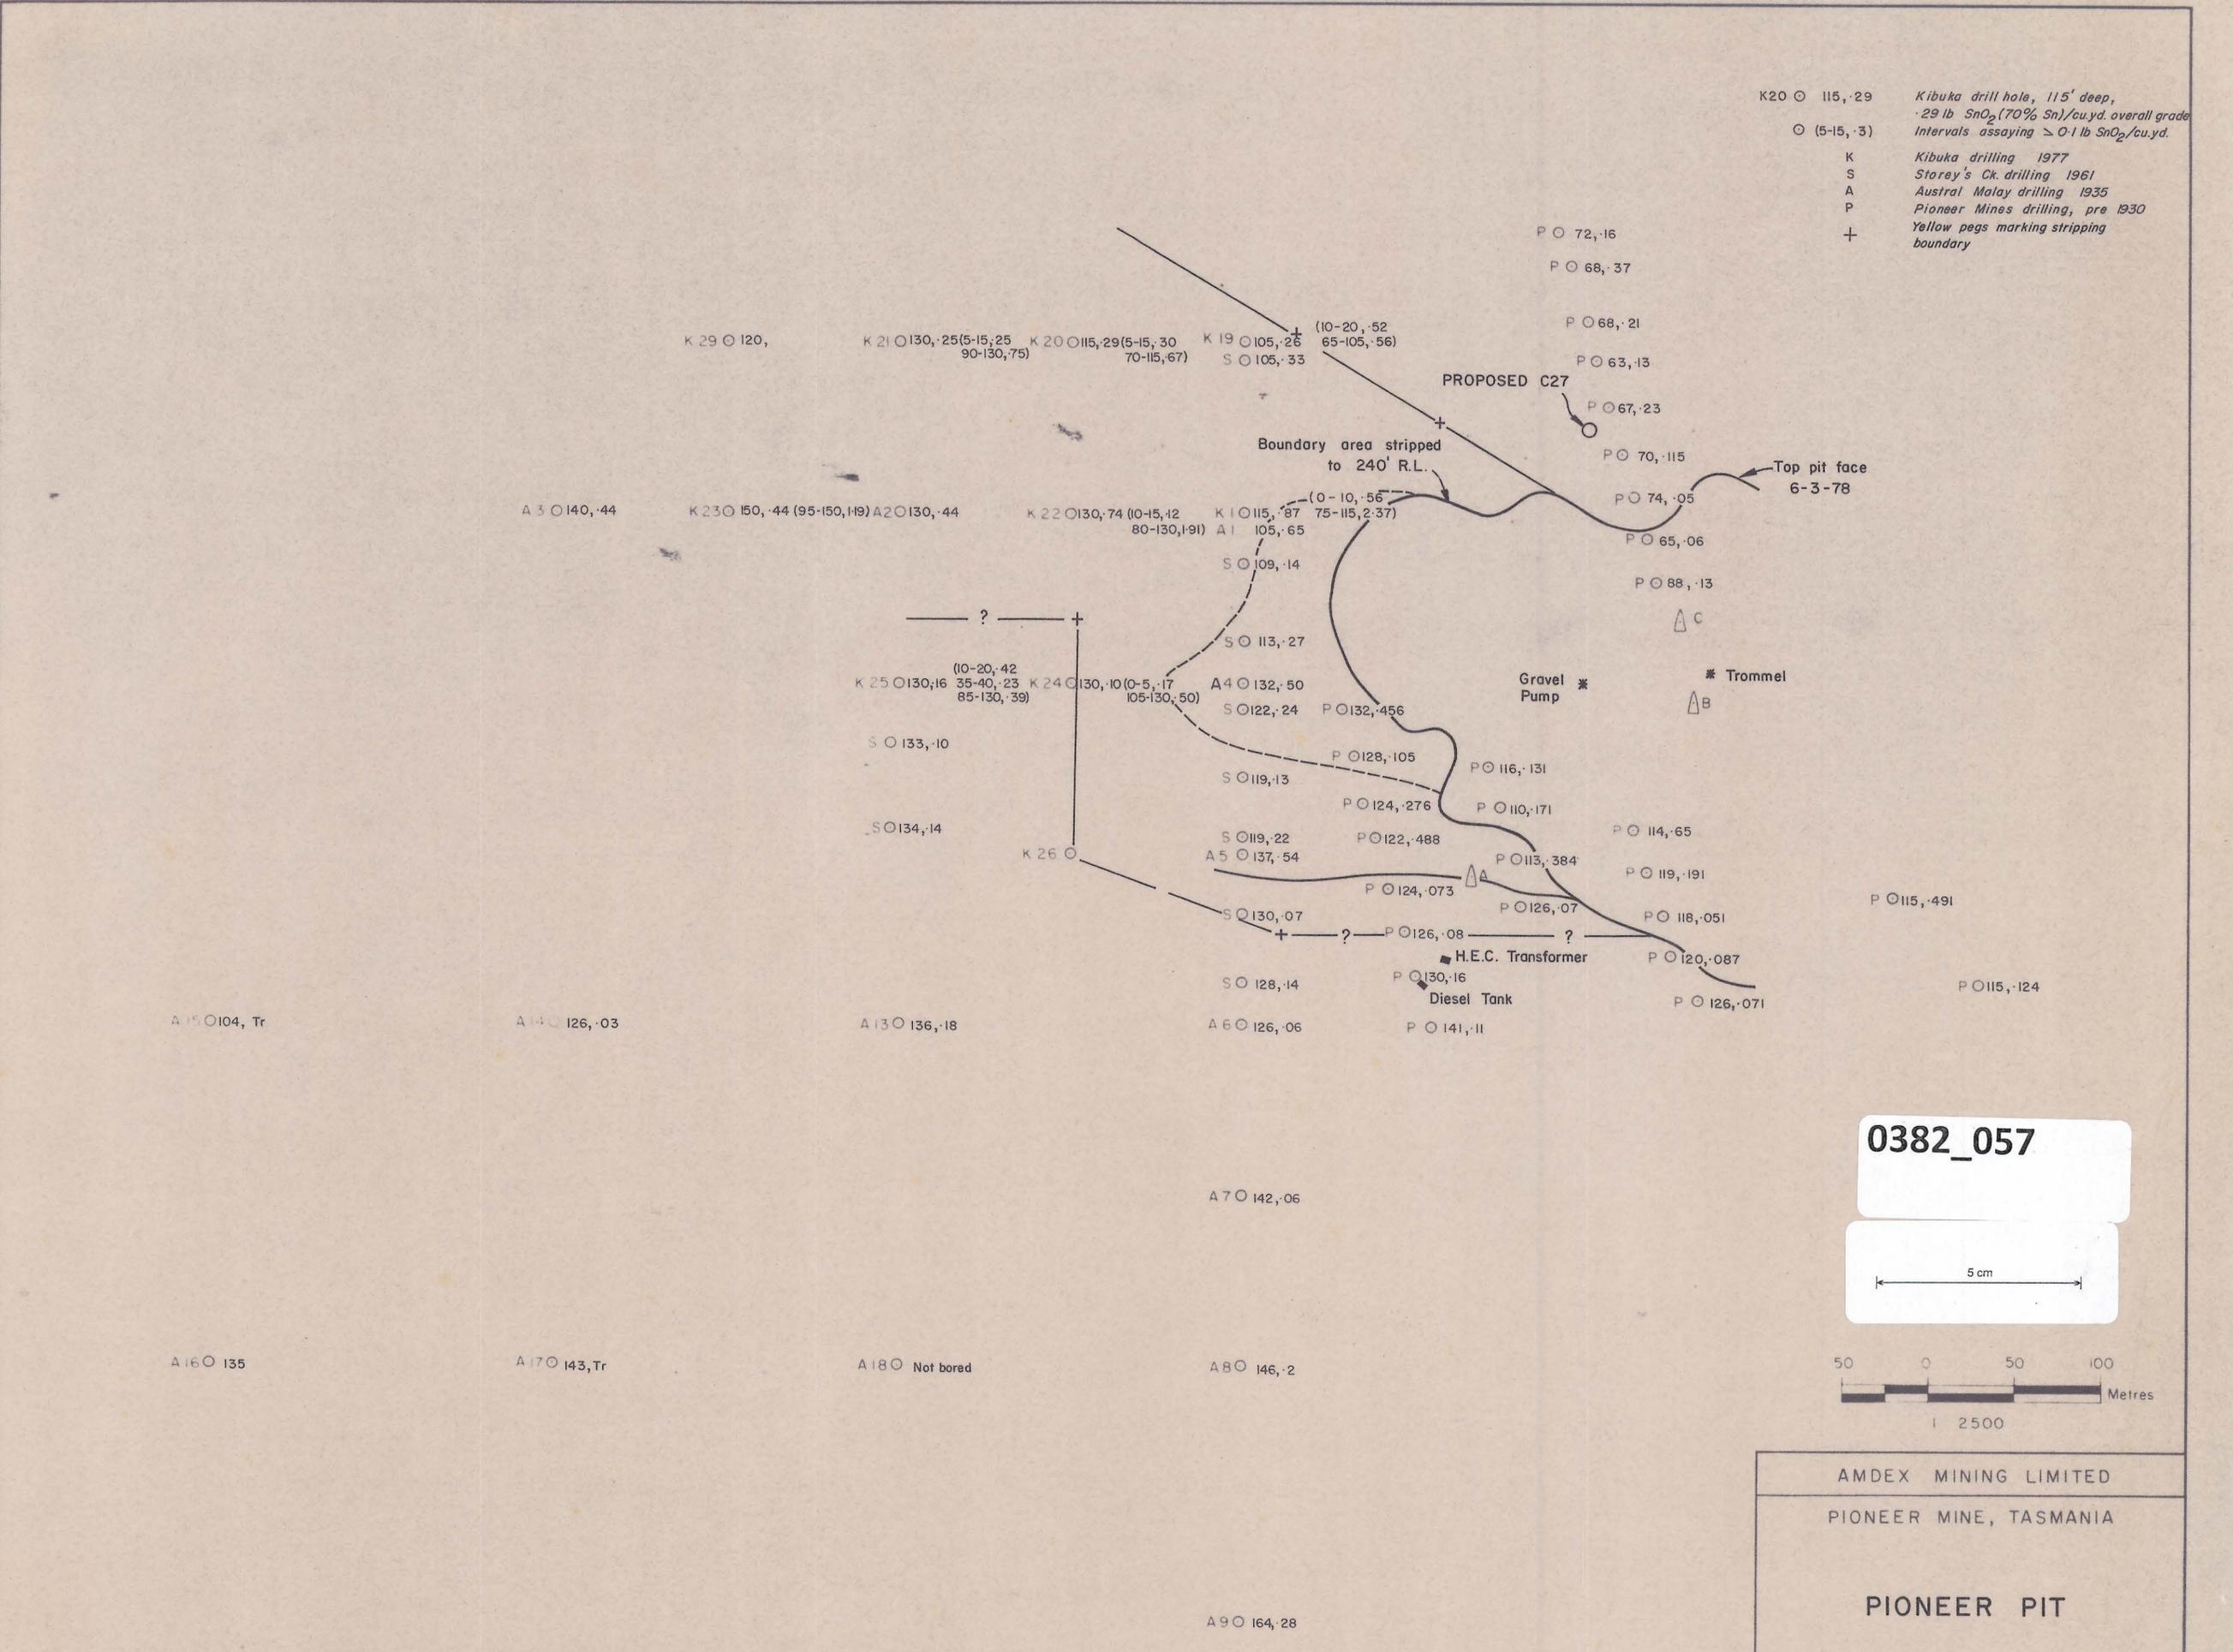

0382_057

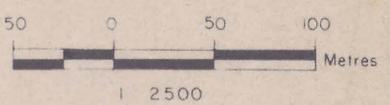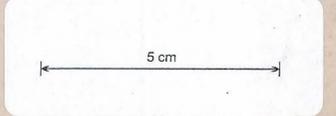

AMDEX MINING LIMITED	
PIONEER MINE, TASMANIA	
PIONEER PIT	
DATA BY A. FLEMING	DATE FEBRUARY, 1978
DRAWN BY C.C.	SCALE 1:2500