



0382\_063



- Road
- - - Track
- x 95.51 Reduced level in metres
- ⊕ Bush
- Power line
- ~ Creek
- ⊖ Swamp
- ▨ Embankment
- ▨ Limit of scraper stripping
- ▨ Pit surface
- ▨ Earth dump

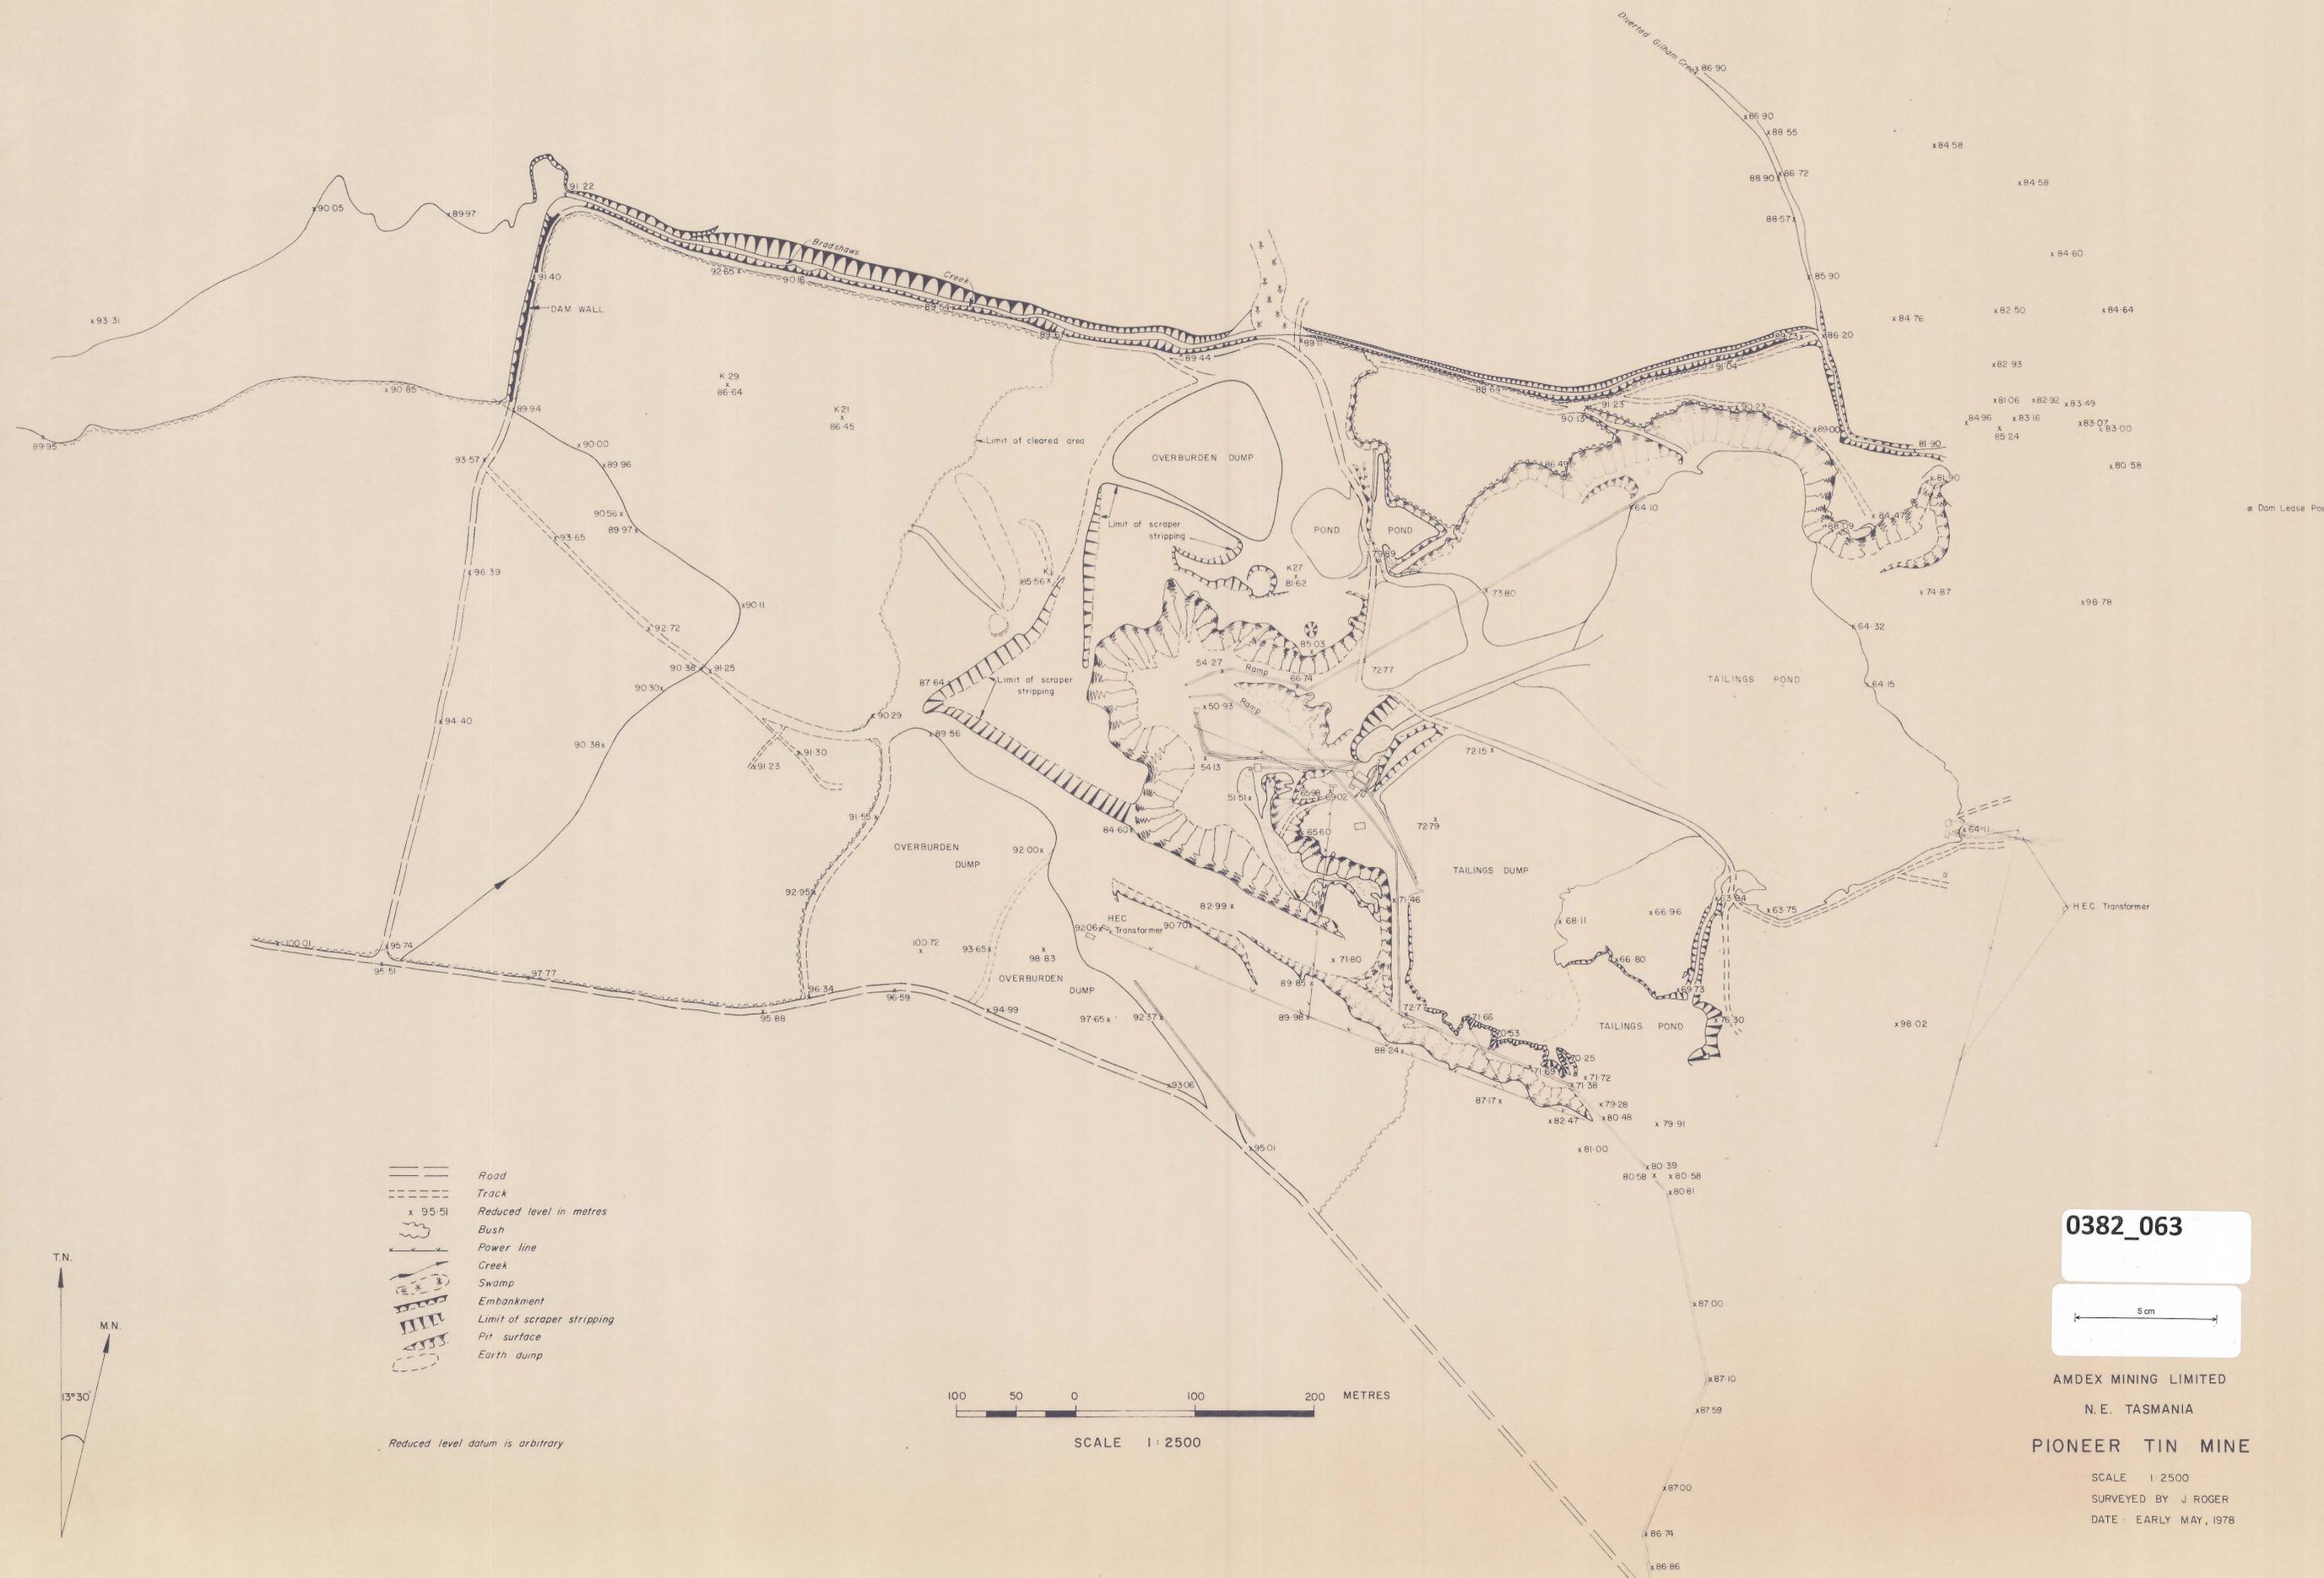


Reduced level datum is arbitrary

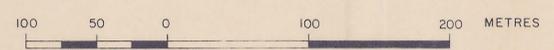

SCALE 1:2500

0382\_063

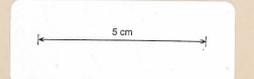

AMDEX MINING LIMITED  
 N.E. TASMANIA  
**PIONEER TIN MINE**  
 SCALE 1:2500  
 SURVEYED BY J. ROGER  
 DATE: EARLY MAY, 1978