


0382_090

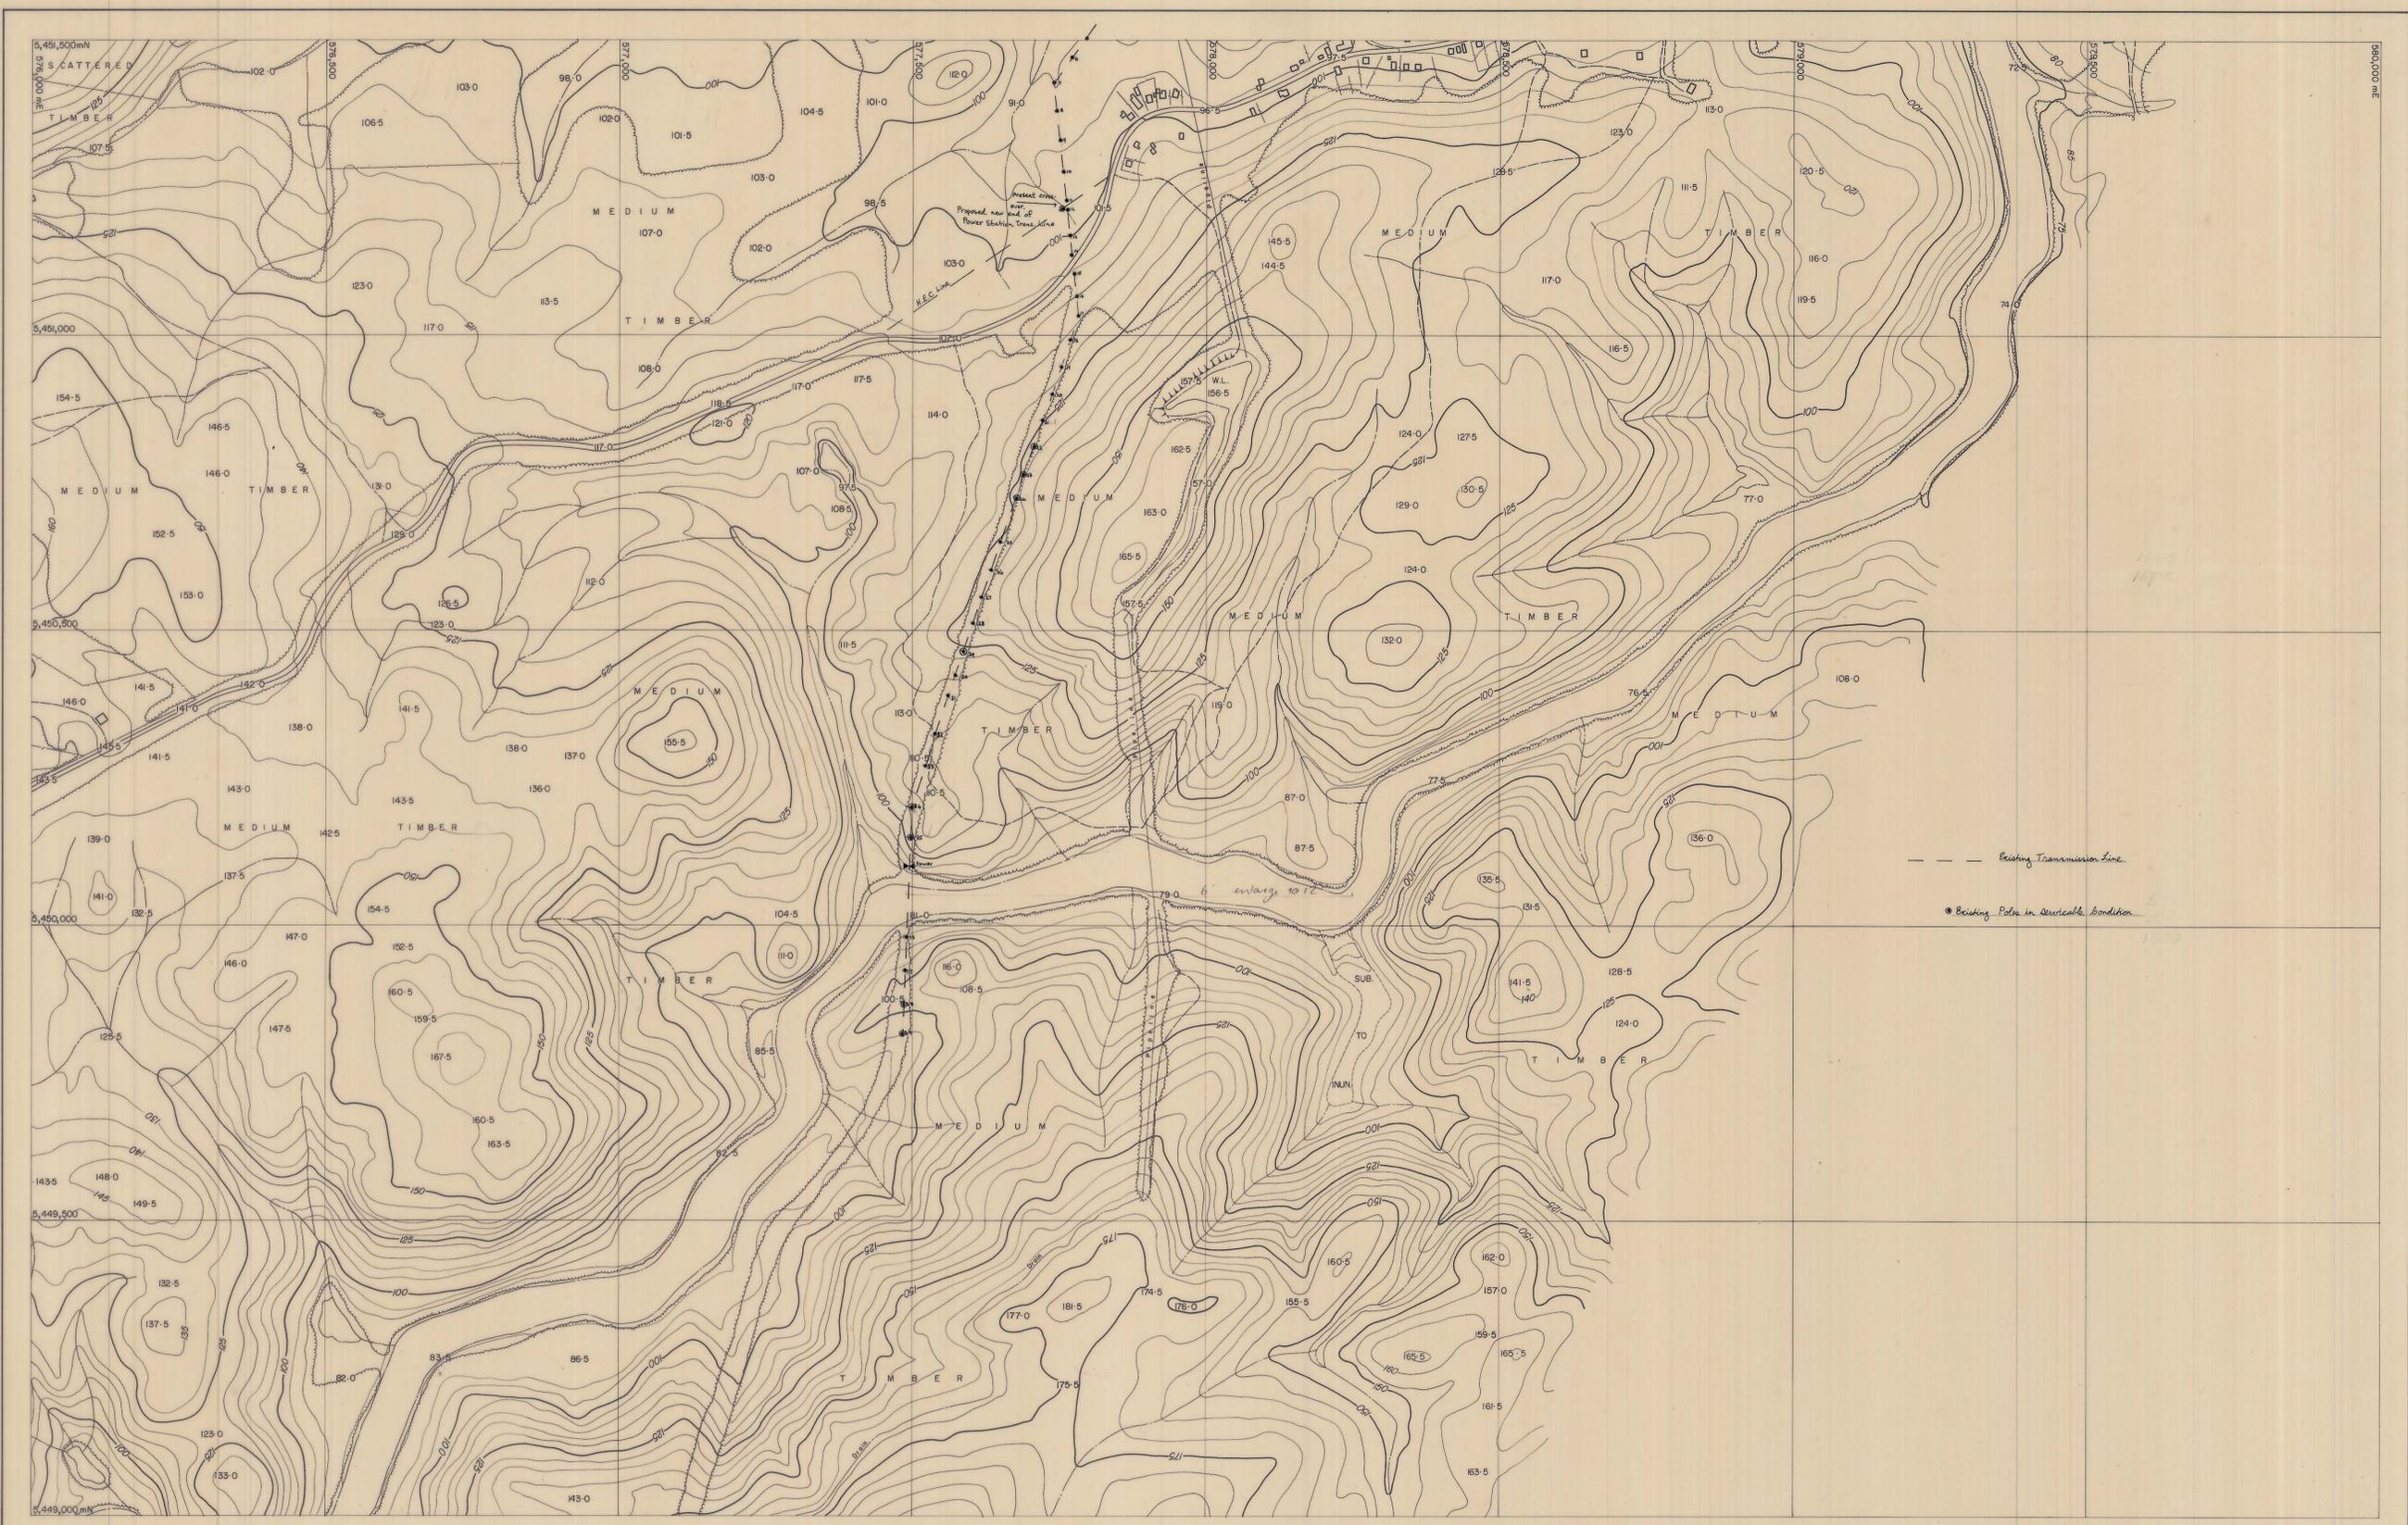


Prepared by AUSTRALIAN AERIAL MAPPING PTY. LTD. N.S.W.
REF. NO. 14081

SHEET INDEX

1	2
3	4

AMDEX MINING LTD
PIONEER TIN MINE
SCALE 1 : 5000

0382_090

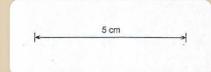

ANDREW SHIRLEY & ASSOCIATES PTY. LIMITED
CONSULTING GEOTECHNICAL ENGINEERS
Suite 3, 17-19 Florence Street,
Horsham, N.S.W. 2077
021 476 5177

GRID	DATUM
AMG	AHD