


0382\_094

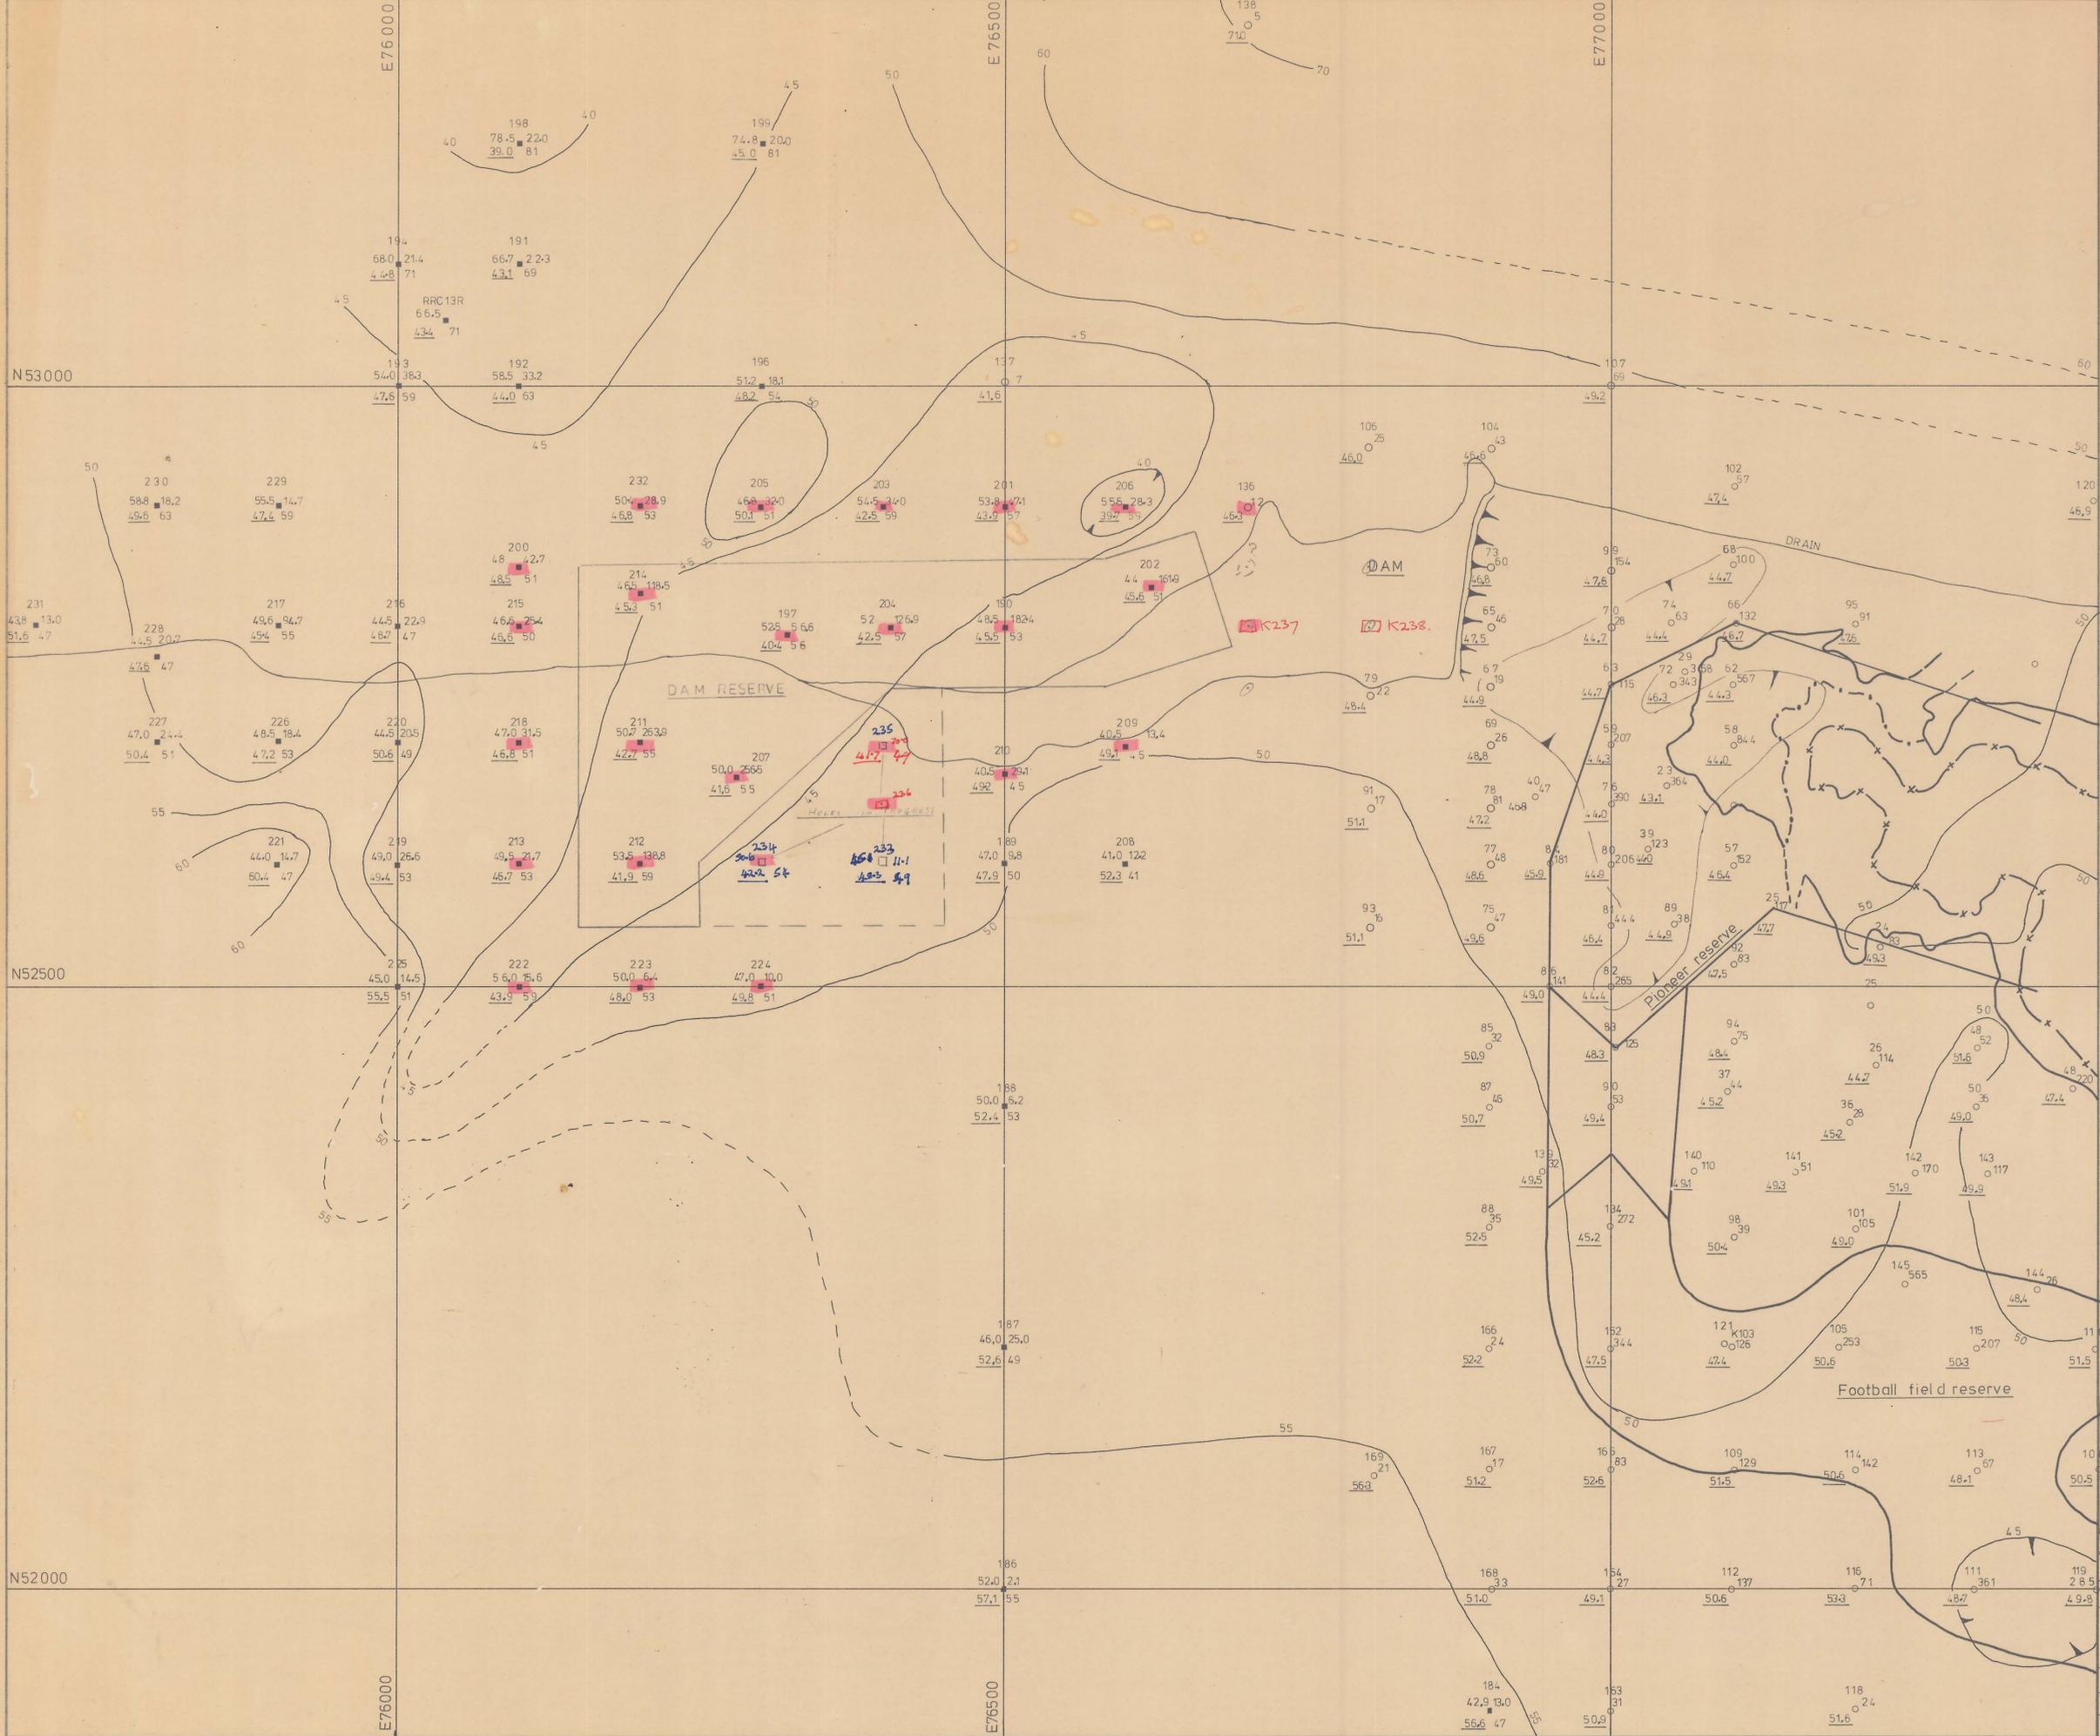

- 102  
57  
47.4 Percussion drill hole
- 199  
74.8 20.0  
5.0 81 Reverse circulation(RC) drill hole
- depth to basement (m)  
hole number-prefix "K"  
grade(g Sn O<sub>2</sub>/m<sup>3</sup>)  
depth of hole (m)  
RL basement (m.a.s.l.)
- Pioneer pit limit April 1982
- Prestripping limit
- Mined to basement
- Reserve outline
- Basement contours, RL in metres A.S.L.

0382\_094

AUSTRALIAN ANGLO AMERICAN LTD			
PROJECT	AAA TRIAKO RINGAROOMA J.V.		
AREA	PIONEER		
DATA	DRILL HOLES		
COMPILED		SCALE	1: 2500
DRAWN	<i>L.P.M.</i> 12-82	REF No	TAS-10-46
AMENDED			