

0382_107

G. J. WALKEM & CO.
SURVEYORS & PLANNERS

Our Ref: AC:PG

HOLYMAN HOUSE, 54 BRISBANE STREET, LAUNCESTON, TAS. 7250
TELEPHONE: 312428

Mr. S. Everett,
Amdex Mining,
Pioneer, Tas. 7254

21st December, 1979

Dear Sir,

Re:- Mine Survey - Pioneer


Enclosed is a plan to scale of 1 to 2500 showing the difference between the pit face as at the 30th November, 1979 compared to the 4th October, 1979.

From our survey the quantity mined during this period was 70,000 cubic metres.

A plan and this information has been sent to Adrian Fleming direct.

Yours faithfully,

A.C. Craig.

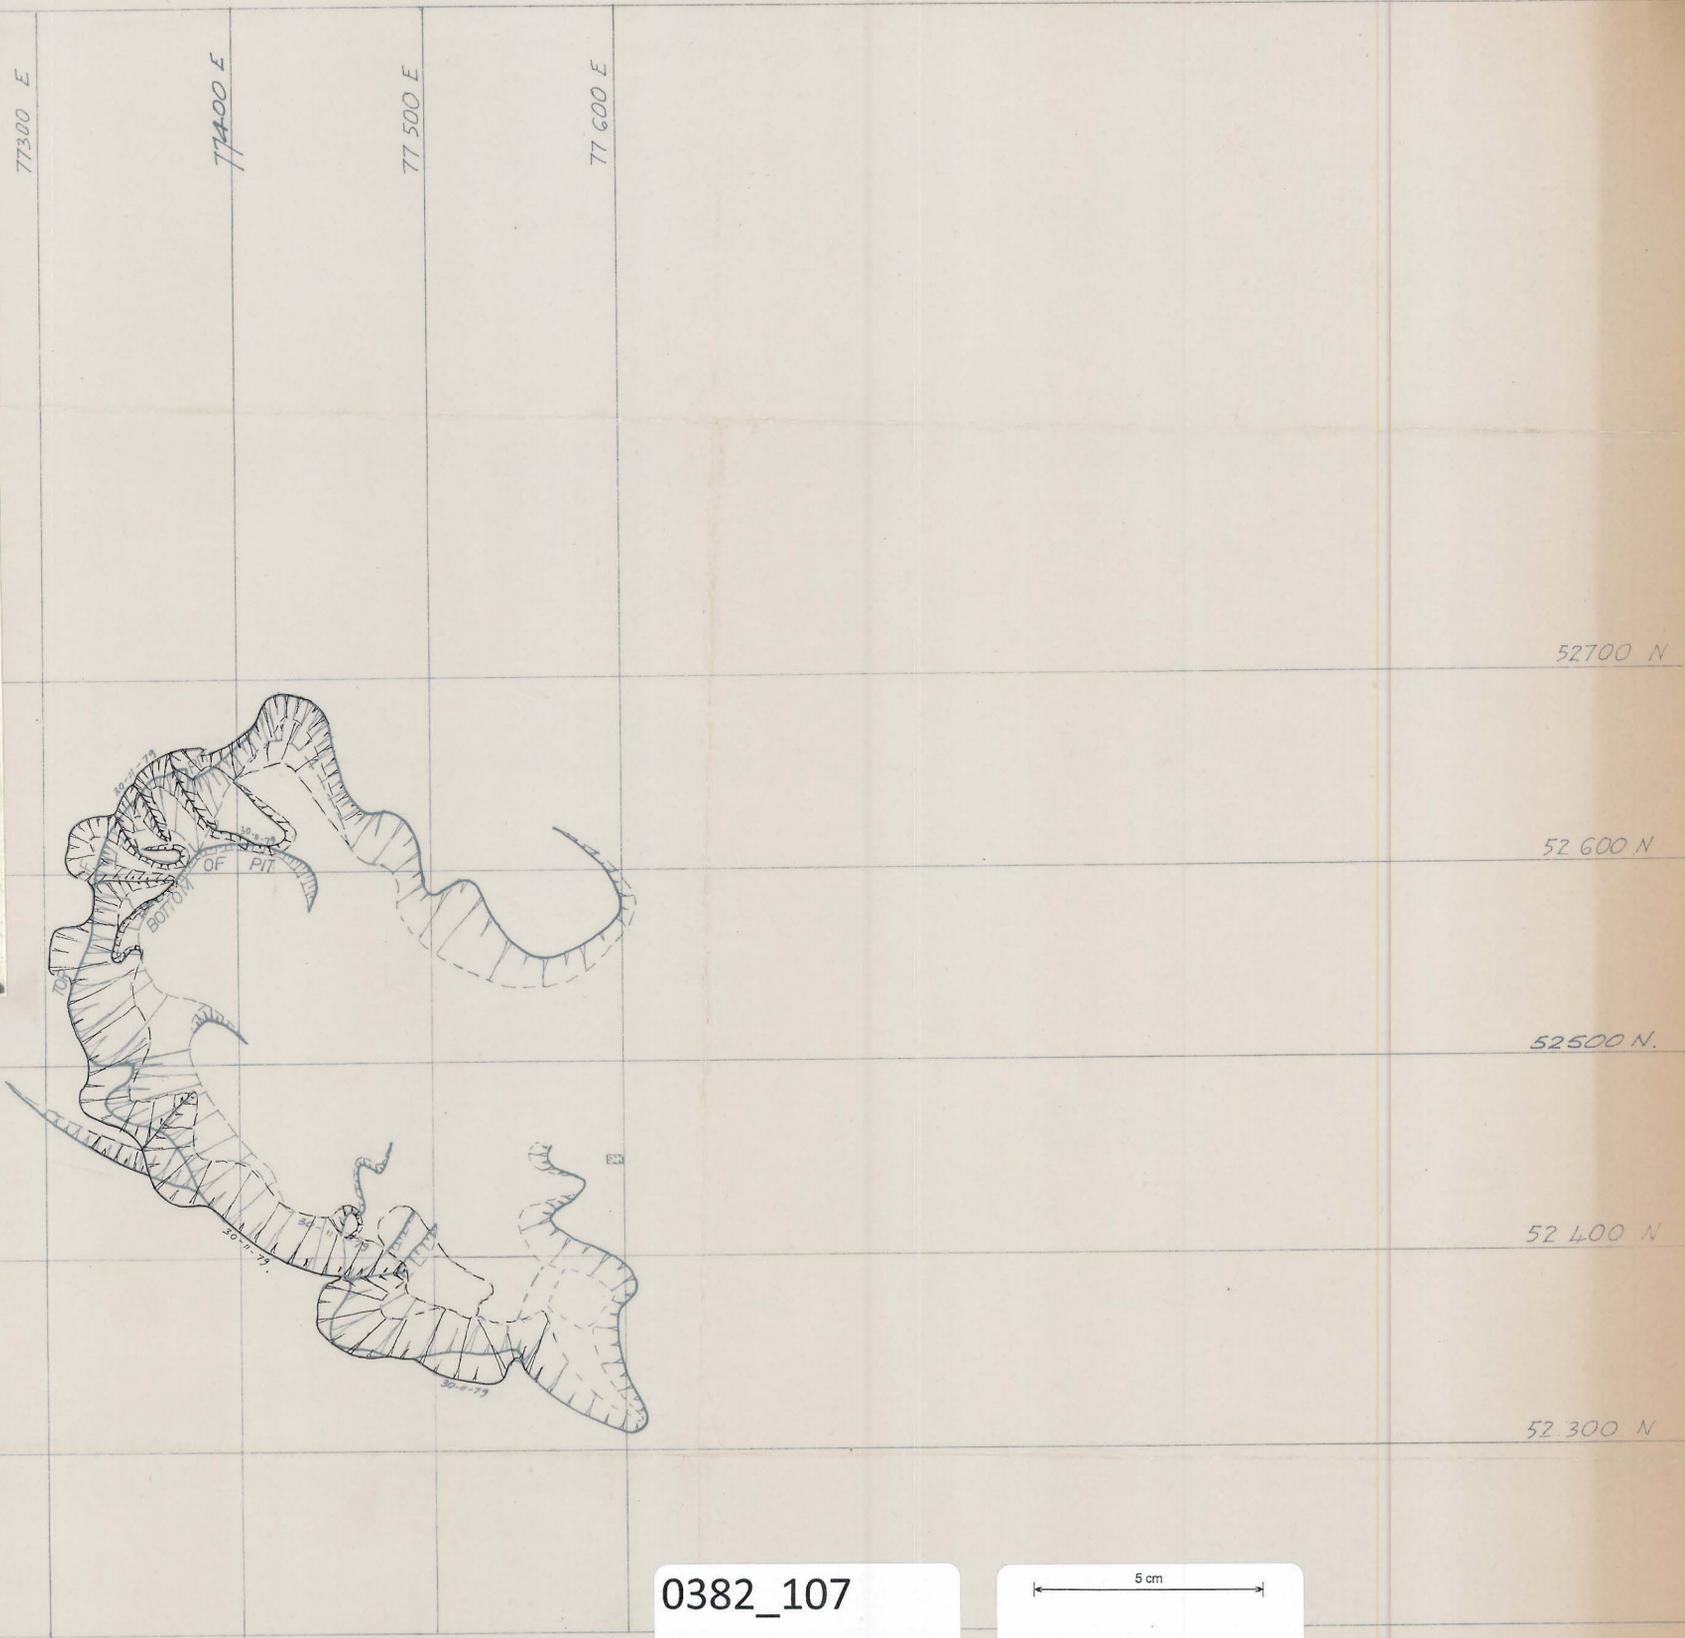

0382_107

5 cm

Additions 12-10-79 ACC

AMDEX MINING LTD
PIONEER TIN MINE 1 : 2.500

prepared by:-
G.J. WALKEM & Co.
LAUNCESTON 31 2428
drawn dvj. date 19 9 1979

No.
L 1417/3