

77300 E  
77400 E  
77500 E  
77600 E


52700 N

52600 N

52500 N

52400 N


52300 N

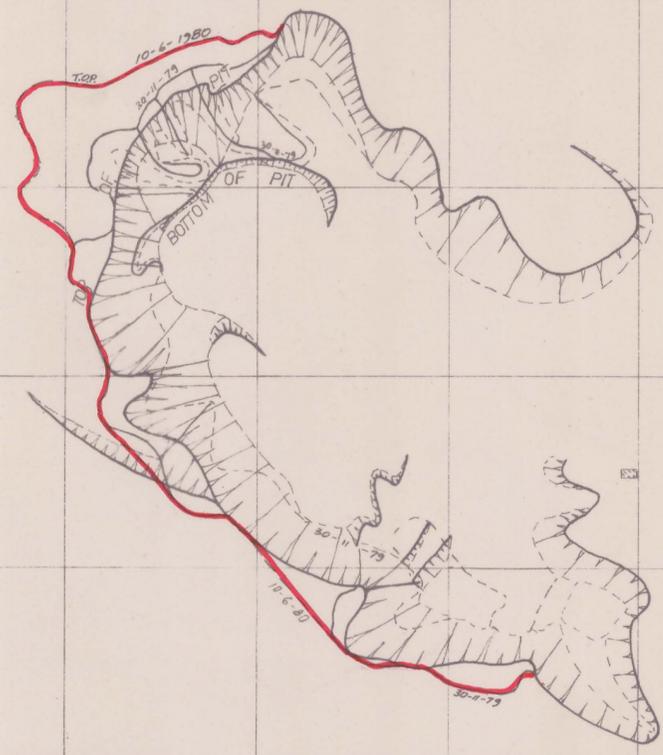

Additions 12-10-79 ACC

0382\_108

AMDEX MINING LTD  
PIONEER TIN MINE 1 : 2.500

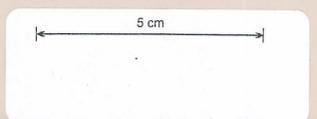

prepared by:—  
G.J.WALKEM & Co.  
LAUNCESTON 31 2428  
drawn dv.j. date 19 9 1979

No.  
L 1417/3