
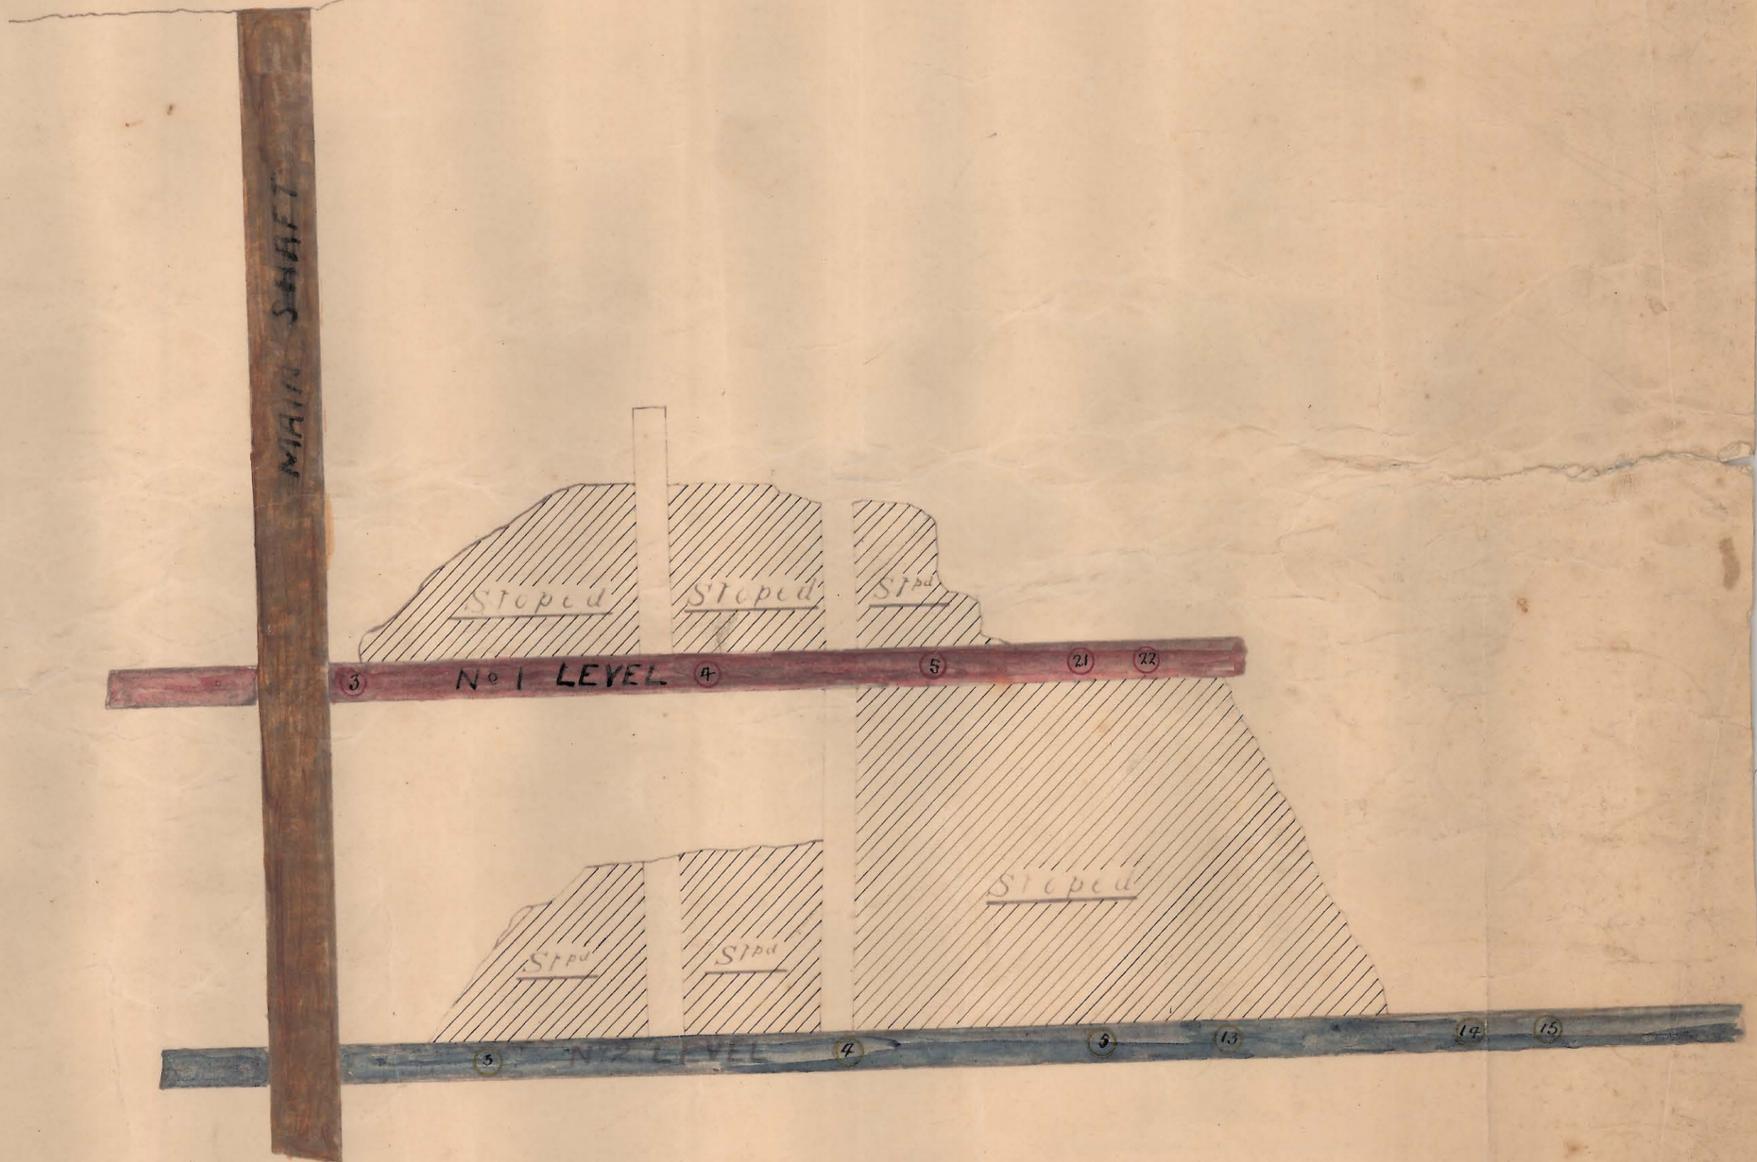


# ASTELL'S LODE

Scale - 25 Feet = 1 Inch

F

G

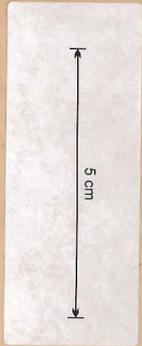

383  
-01