


10-582

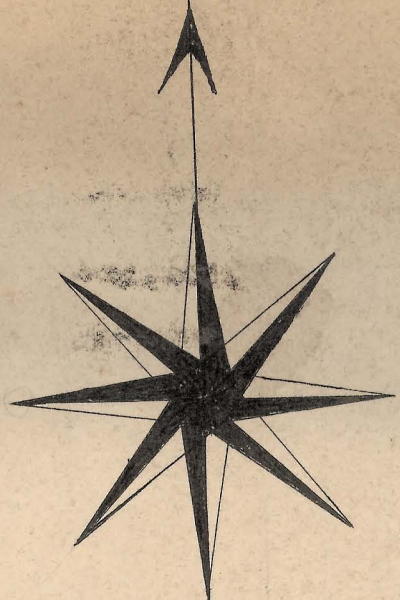

NEW MOON T.M. CO.

PLAN SHEWING WORKS

ON

DYKE FORMATION

Scale 50 Links to an Inch



900 Ton of alluvial tin & 72 tons from Excavation Taken From This Ground

NOTE
Trenches
New Works
Tin bearing
Ground worked for tin

10-582

50m