


101

387
101

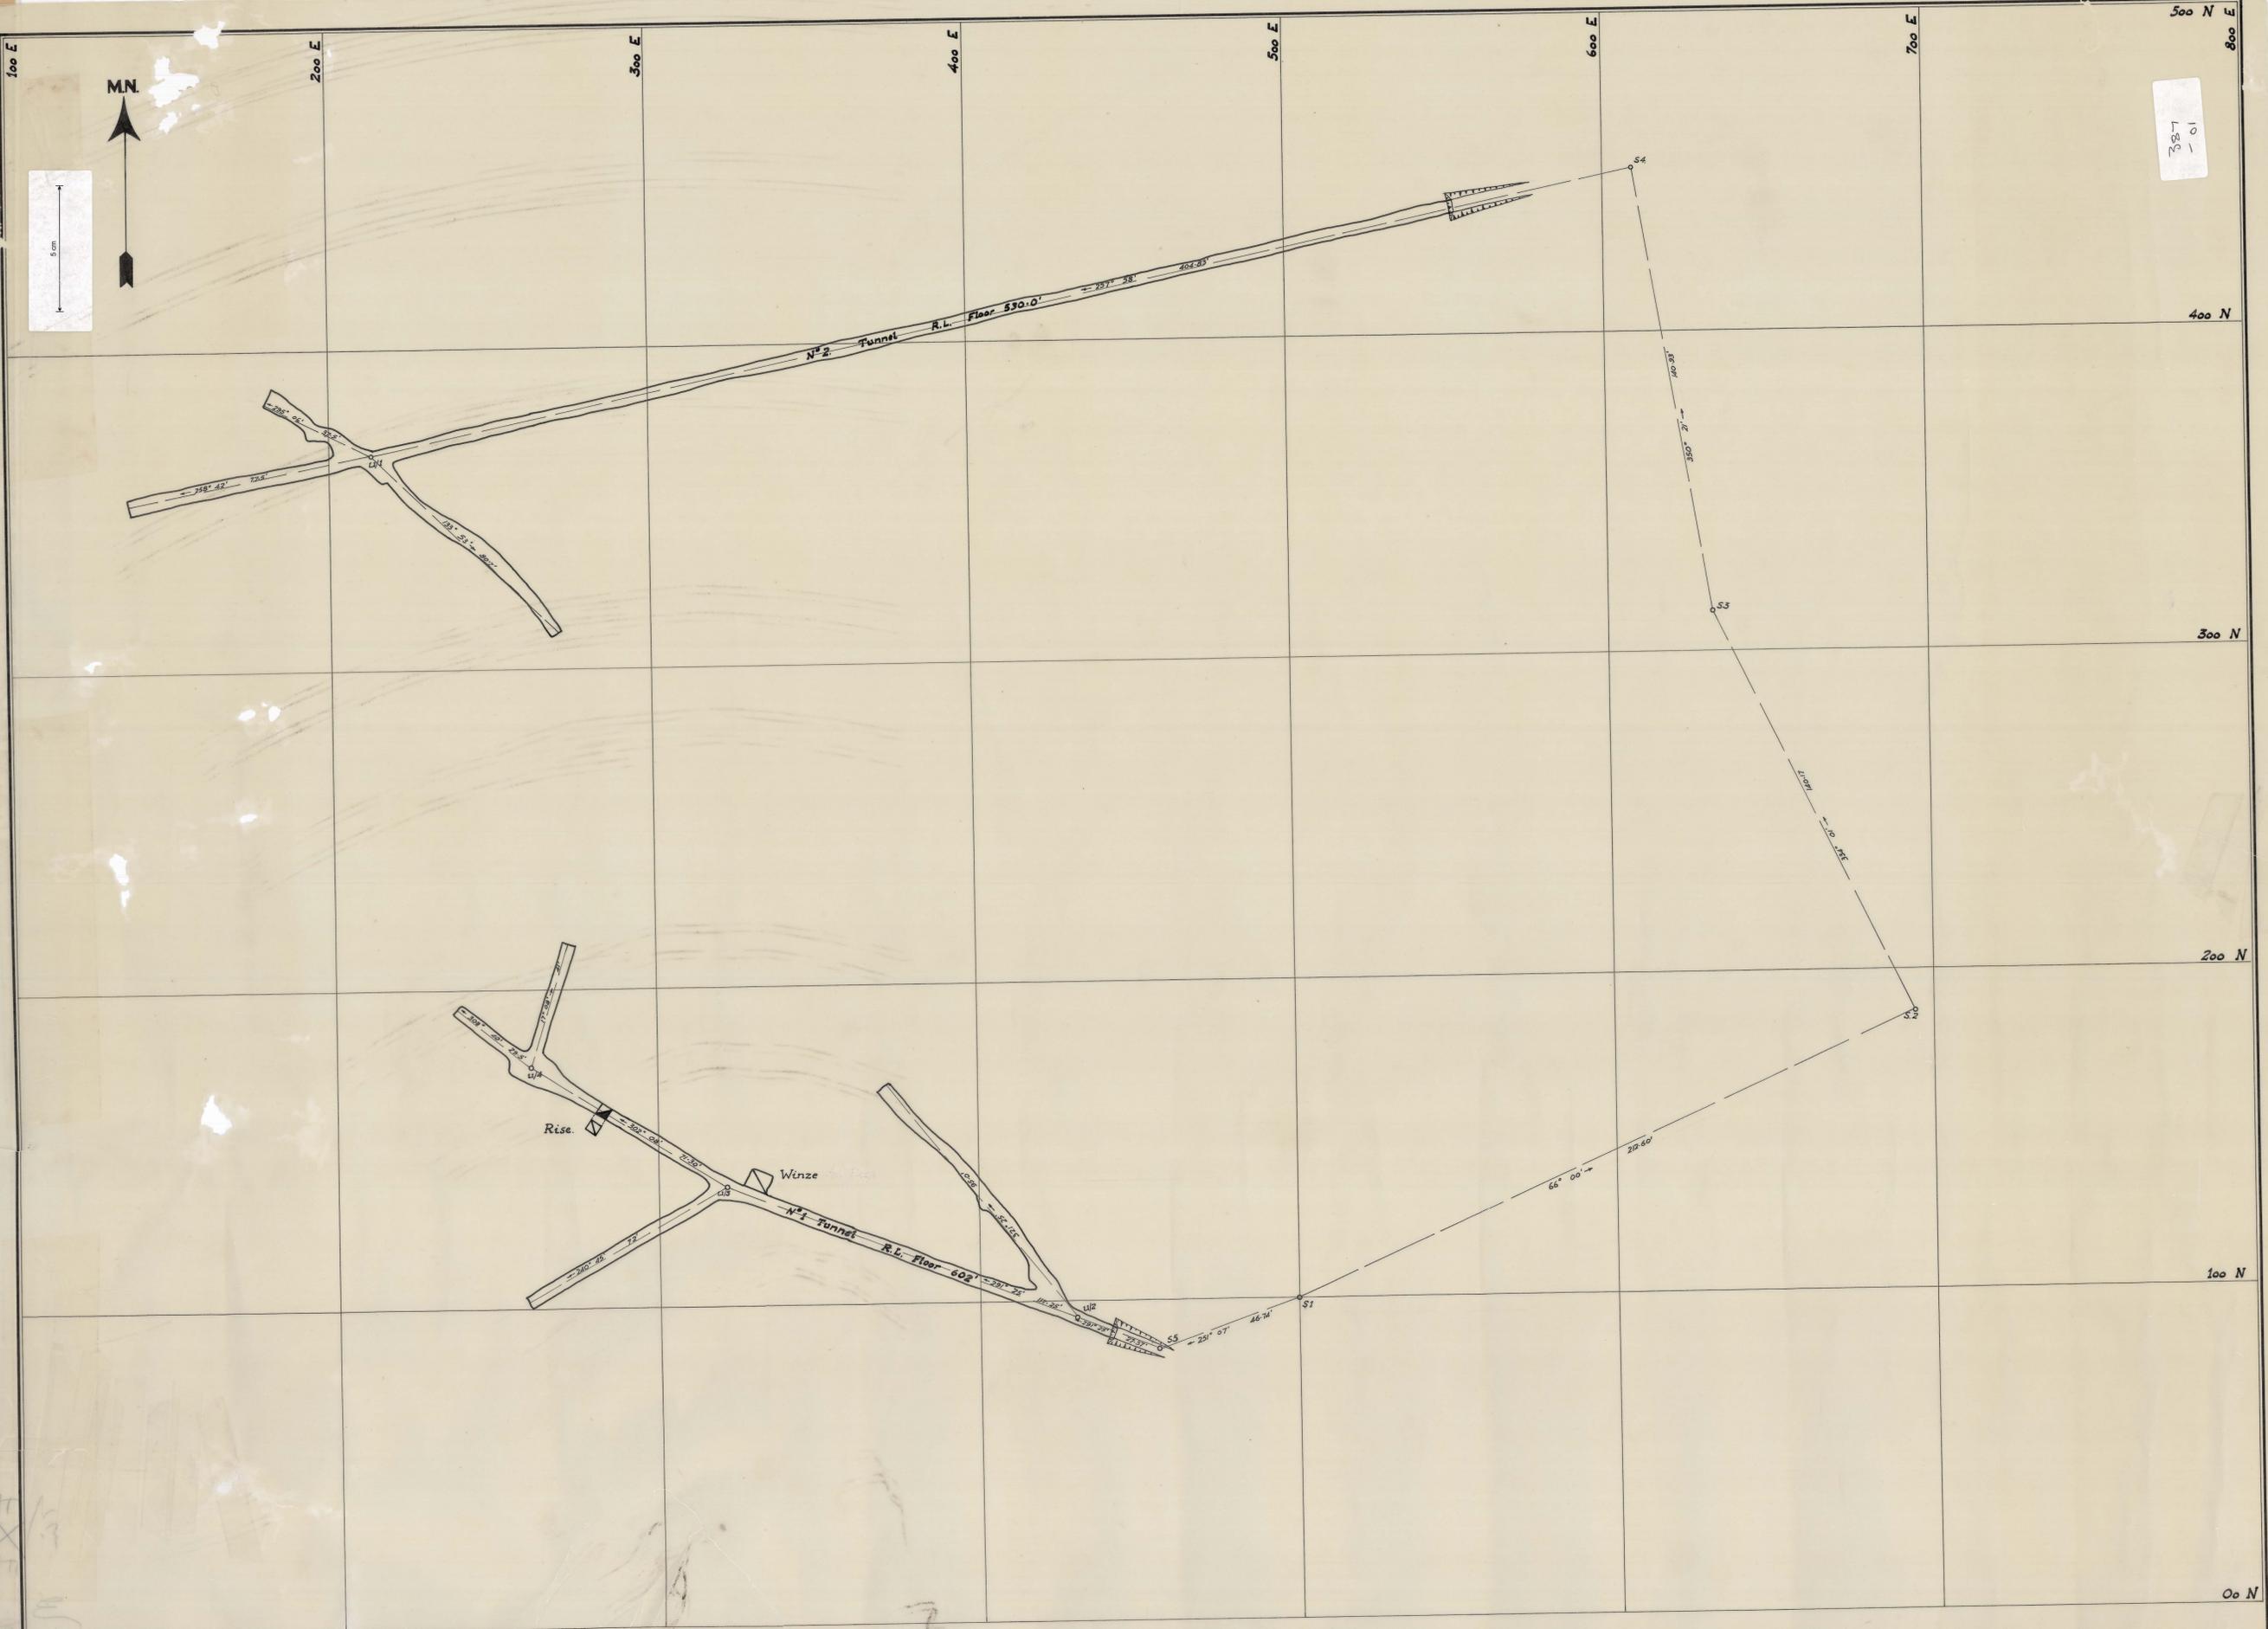

X RIVER TIN MINE
 Scale 1 inch = 20 feet