


0391-006

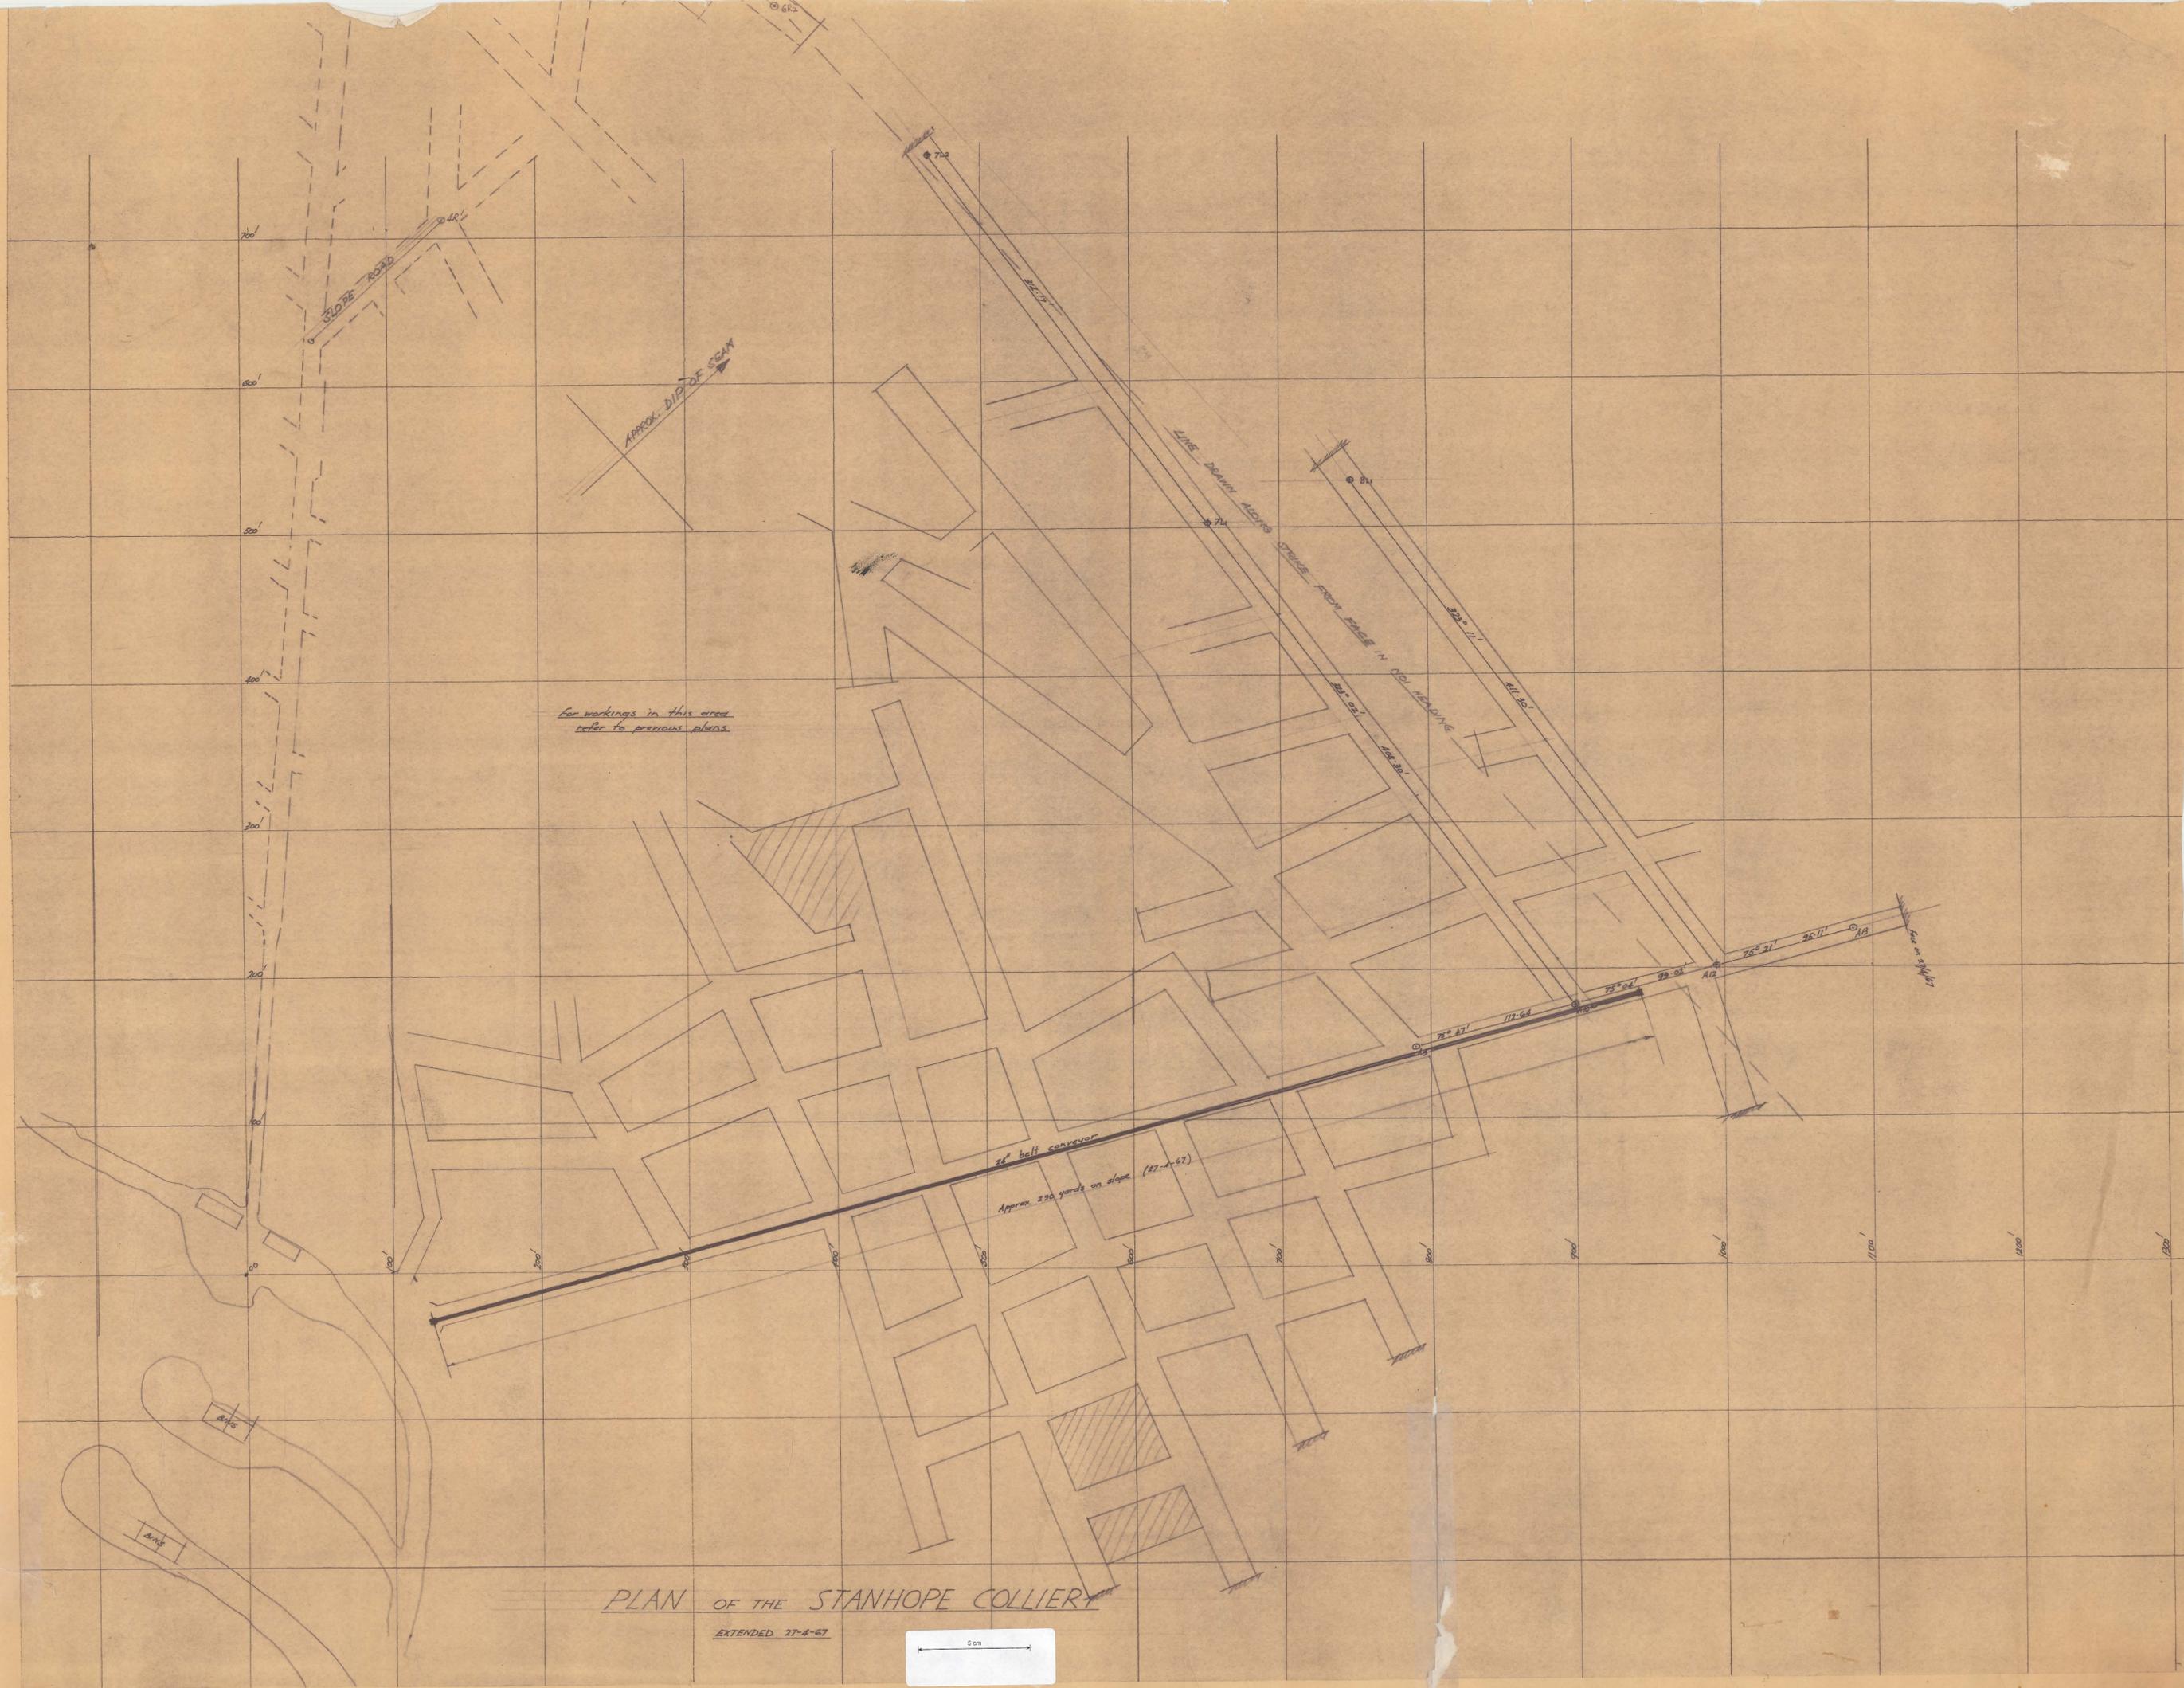

For workings in this area refer to previous plans.

# PLAN OF THE STANHOPE COLLIERY

EXTENDED 27-4-67

