


5 cm

SKETCH

SHOWING POSITION OF SILVER KING
MAIN SHAFT. ZEEHAN, TAS.
Scale: 100 Feet to an inch

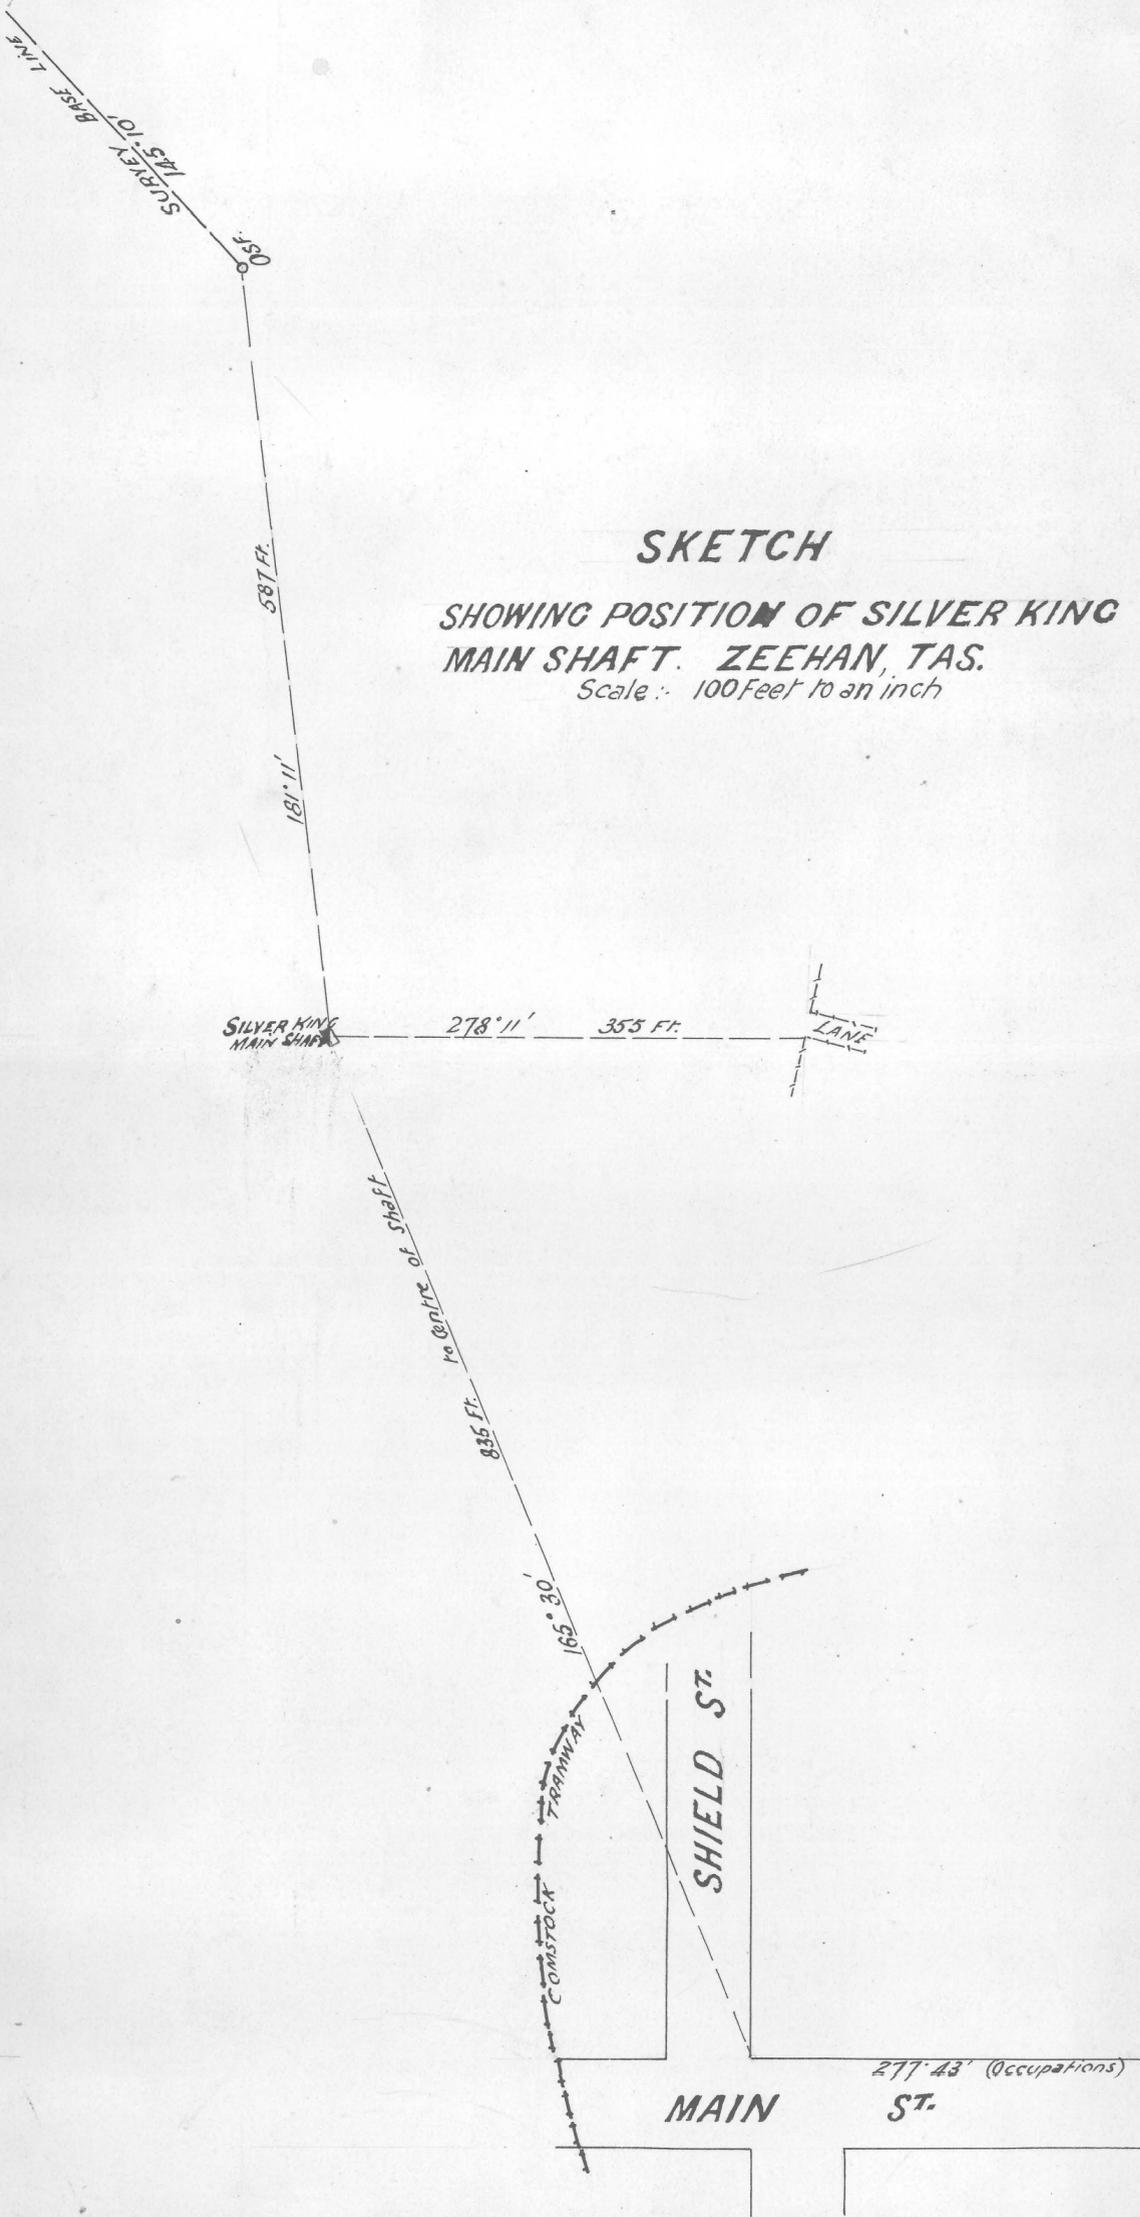

J. C. Ferguson
Sectional Off. in Charge.

J.C.F.
Sur.
13/10/29