




383  
-108

N° 6 SHEET  
Details of Surface  
Scale 50ft. to 1 in.

1157<sup>1/2</sup> 80 ac.

Eastern end N° 23 Trench



West Bdy. 1158<sup>m</sup>

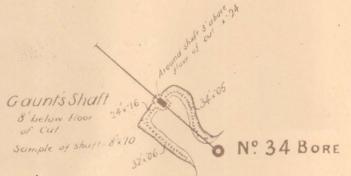


N° 34 BORE

1153<sup>1/2</sup> 63 ac.

1505  
33<sup>1/2</sup> 20 ac

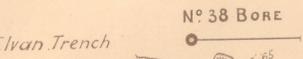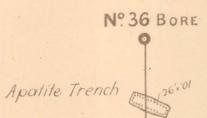

East bdy. 1158<sup>m</sup>

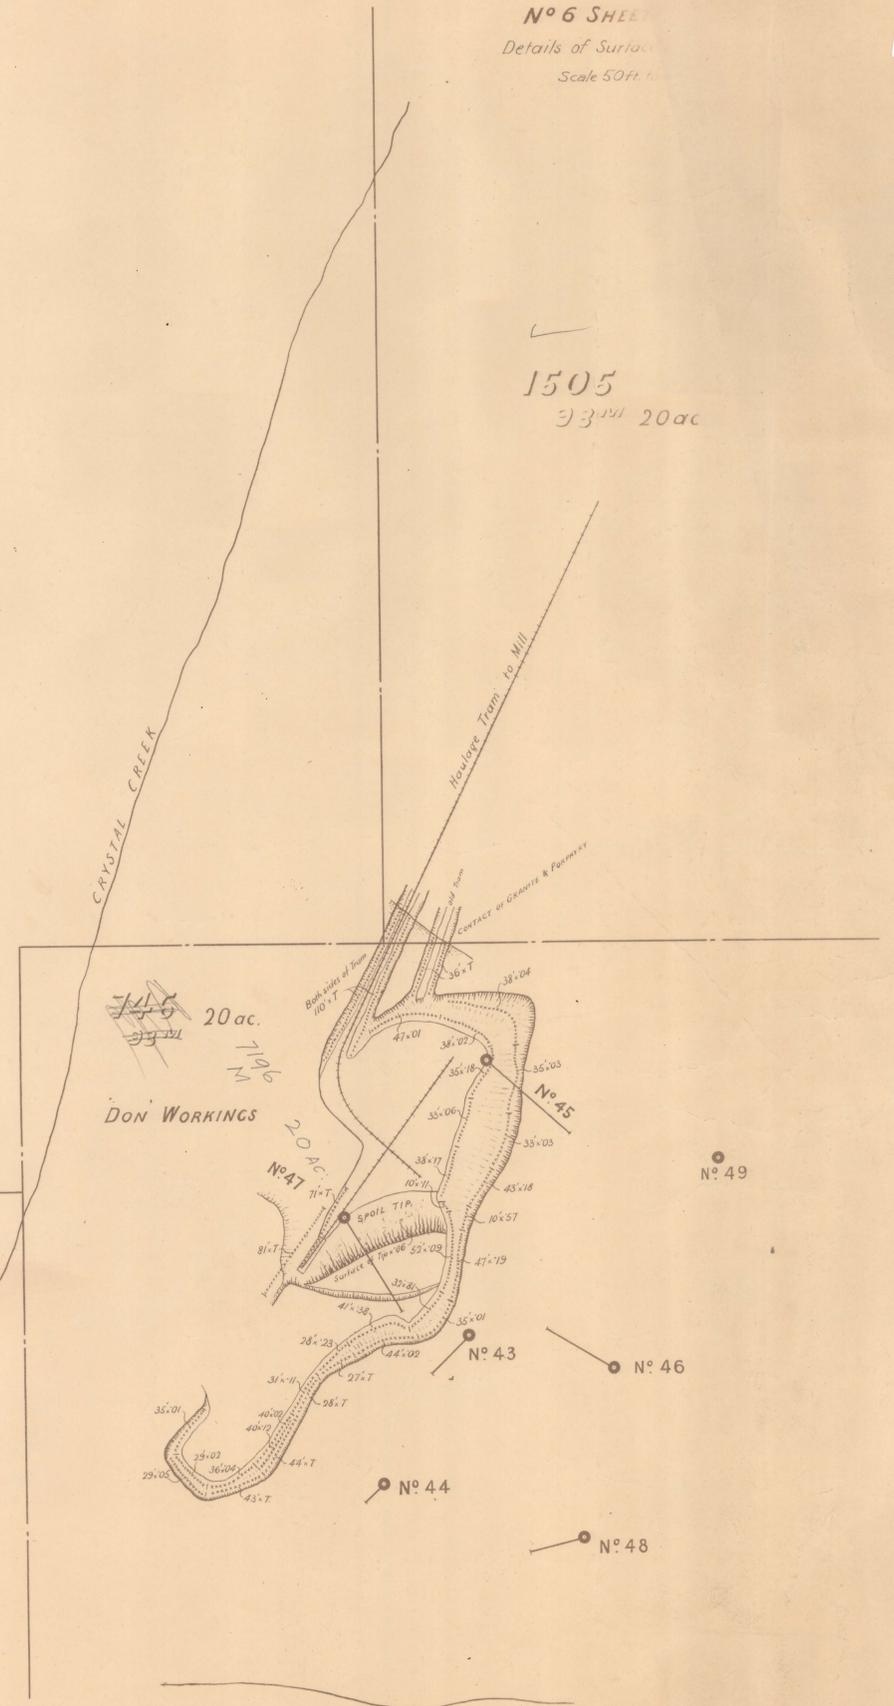

1505  
33<sup>1/2</sup> 20 ac

1157<sup>1/2</sup>

12 ac