


# Mount Lyell Mining & Railway Co Ltd.





Mine Department

SHEET I.

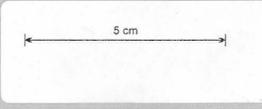

Field Notes of Underground Workings up to Dec 31<sup>st</sup> 1919  
Instrument used 5" Theodolite

General Manager \_\_\_\_\_  
Engineer-in-Charge P. J. Jones

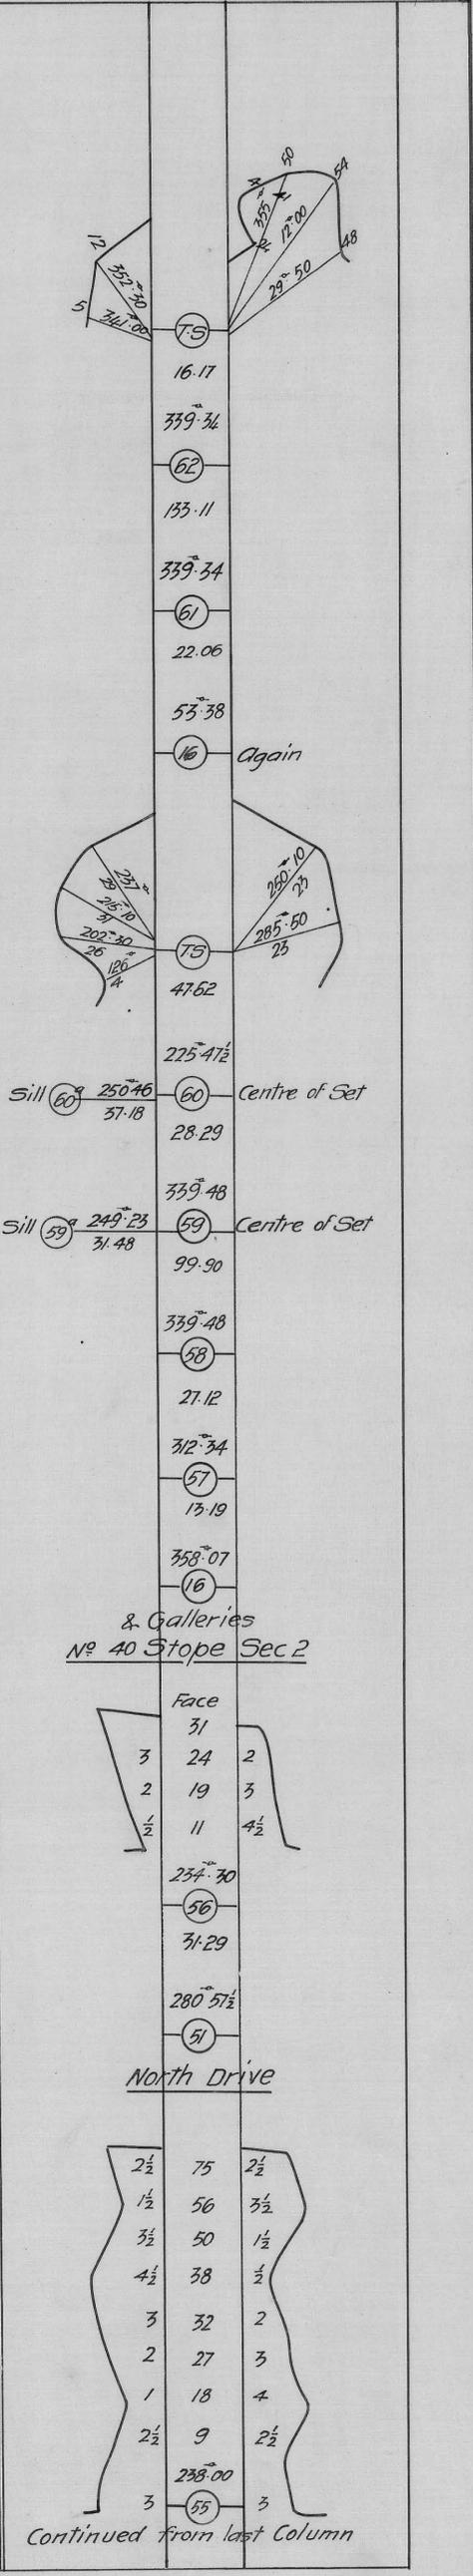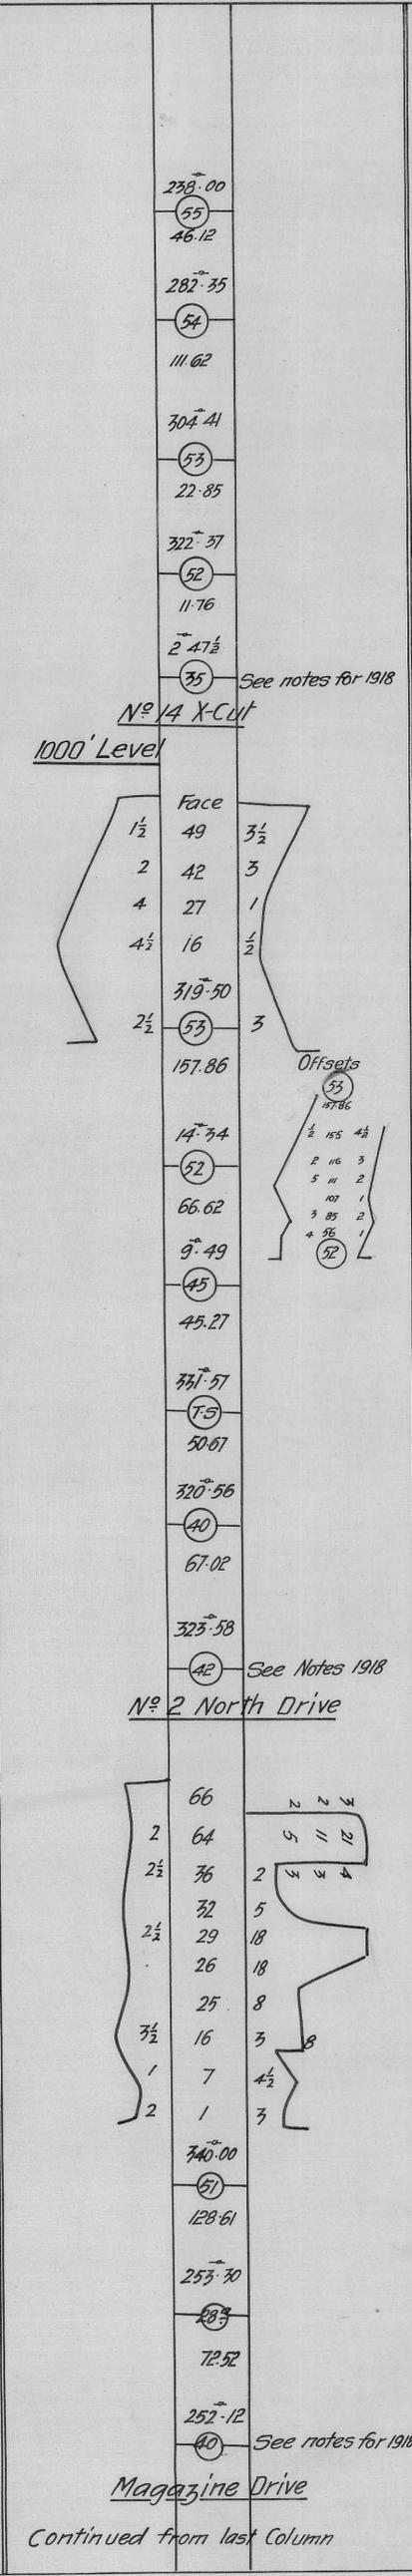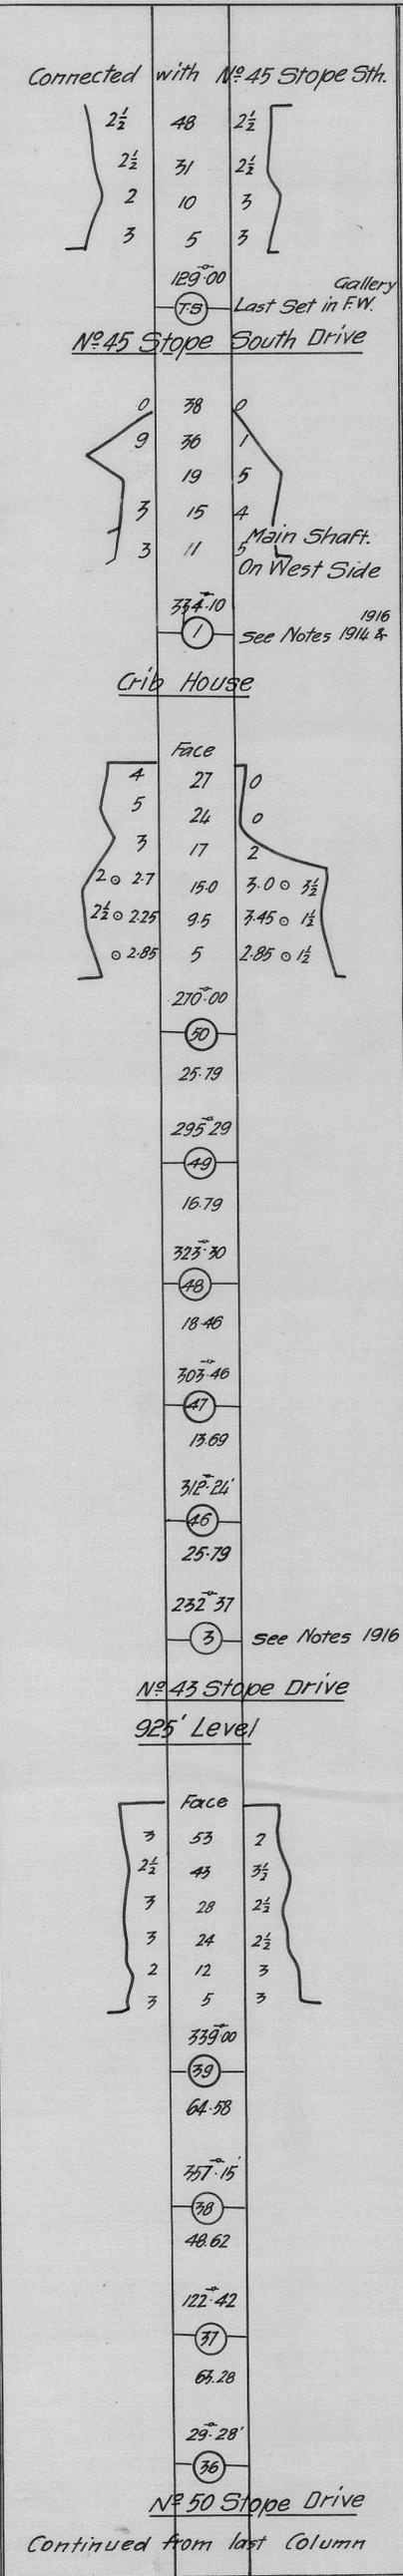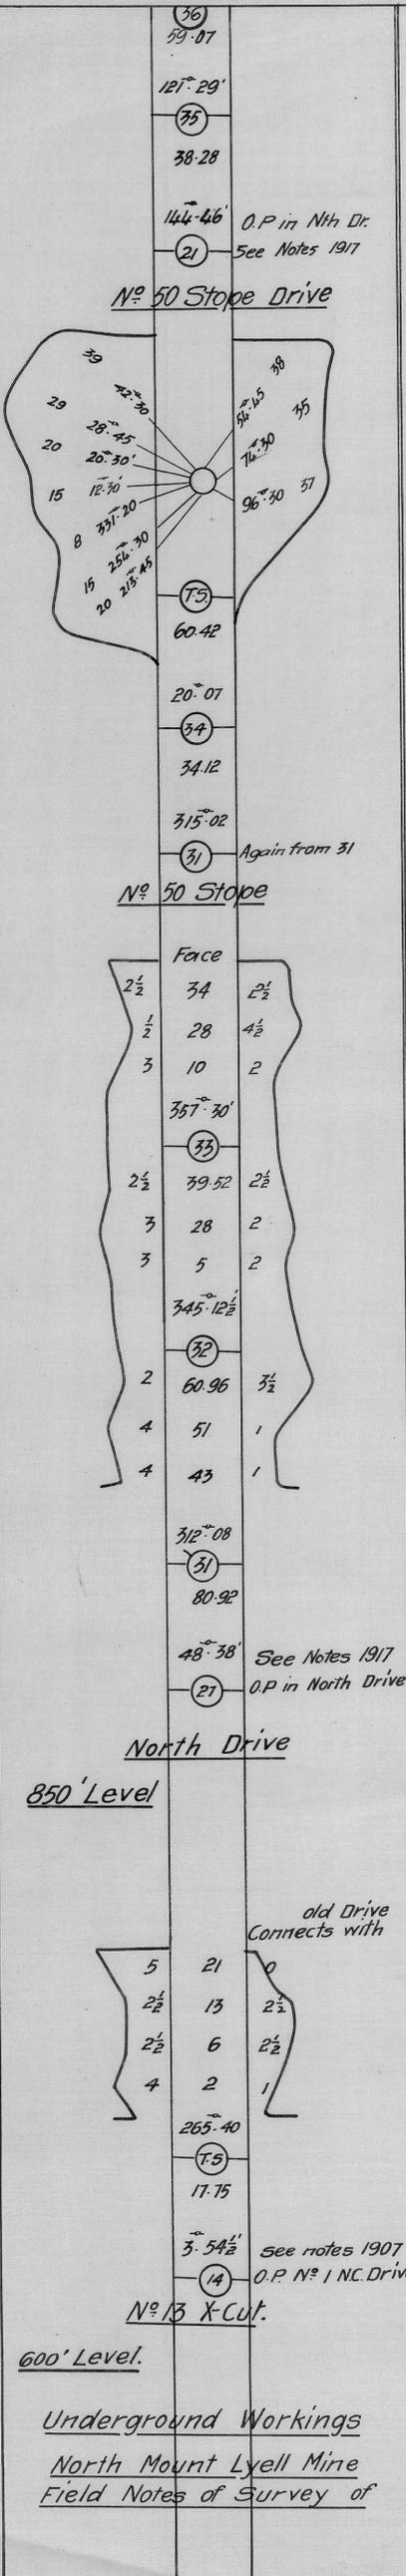

Underground Workings  
North Mount Lyell Mine  
Field Notes of Survey of