


0395_012

5 cm

M N

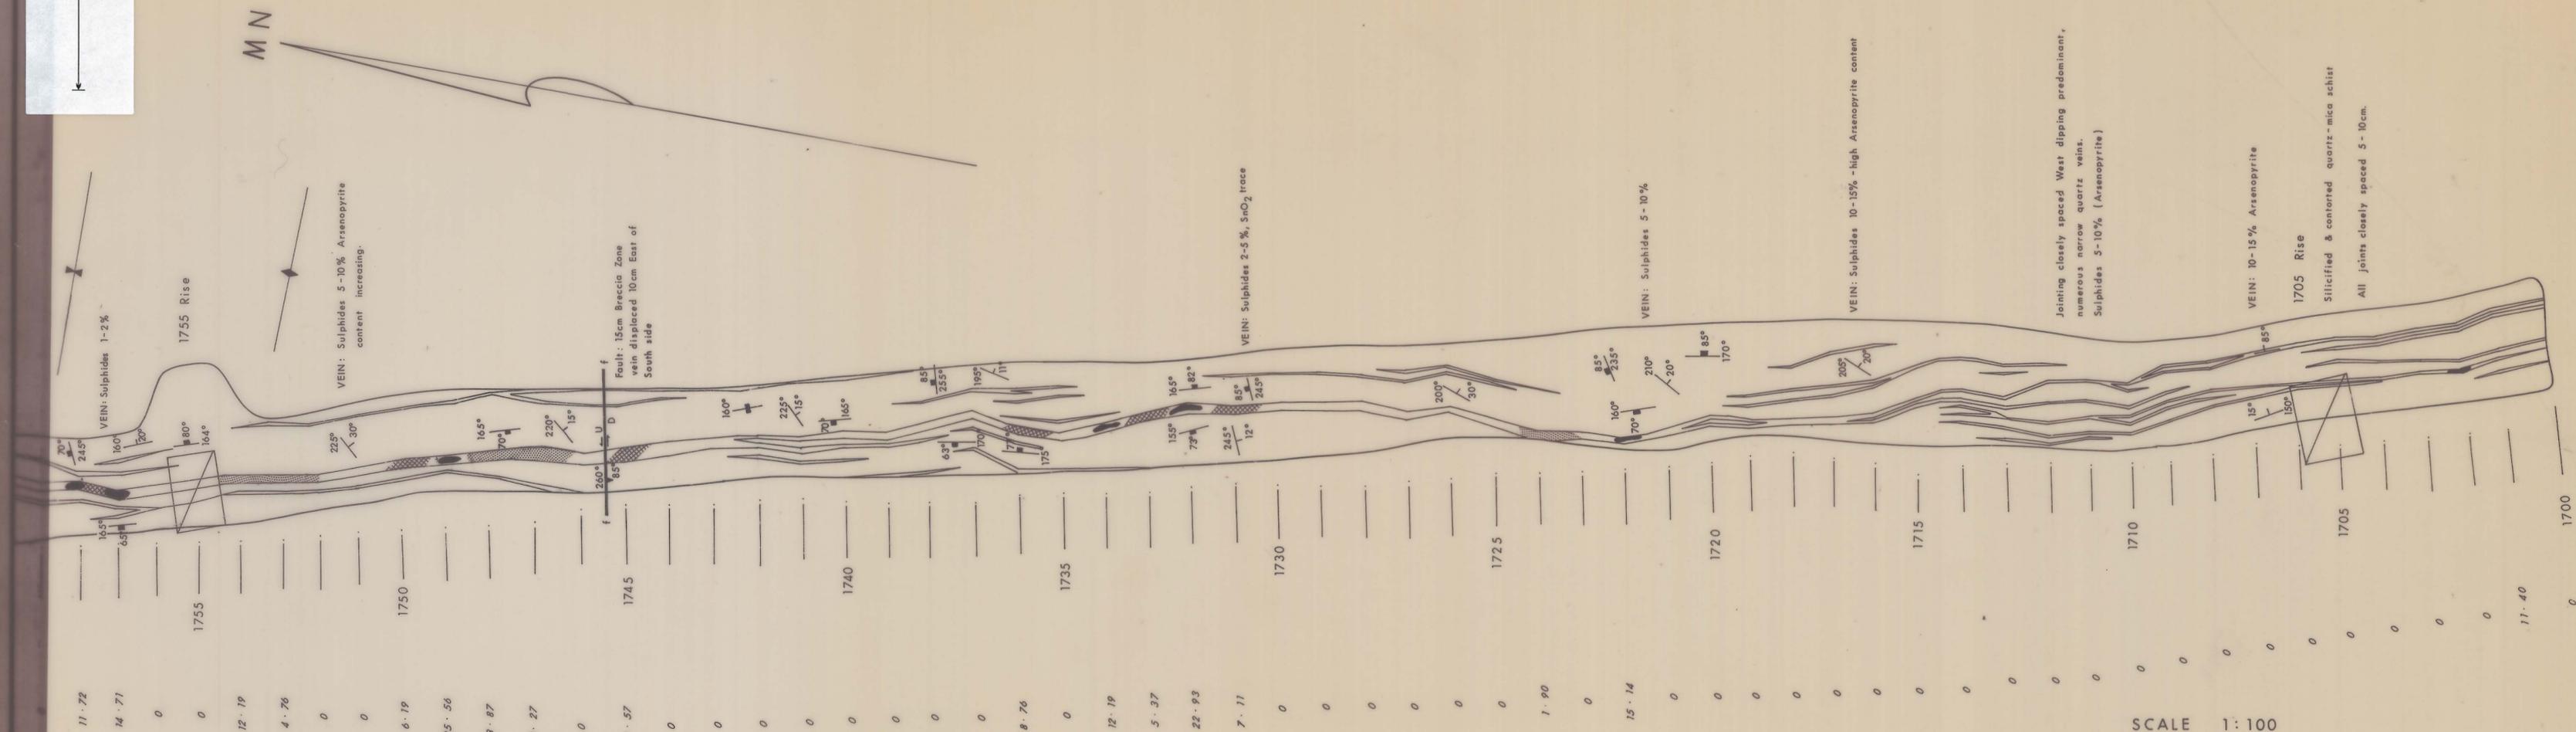

Interval 1757 - 1708
 ave. vein width 21.87cm.
 ave. vein grade 3.44% WO₃

280 LEVEL ADIT

Oakleigh Ck Wolframite Project



REPORT : 79/SYD/19	FILE NO: 173-12d	RE DRAWN	1/11/79	SHEET 4
DATE SEPTEMBER 79			D.J.P.	