




280 LEVEL ADIT

OAKLEIGH CK WOLFRAMITE PROJECT


SHEET 1

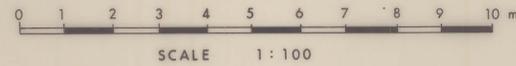

0395_016

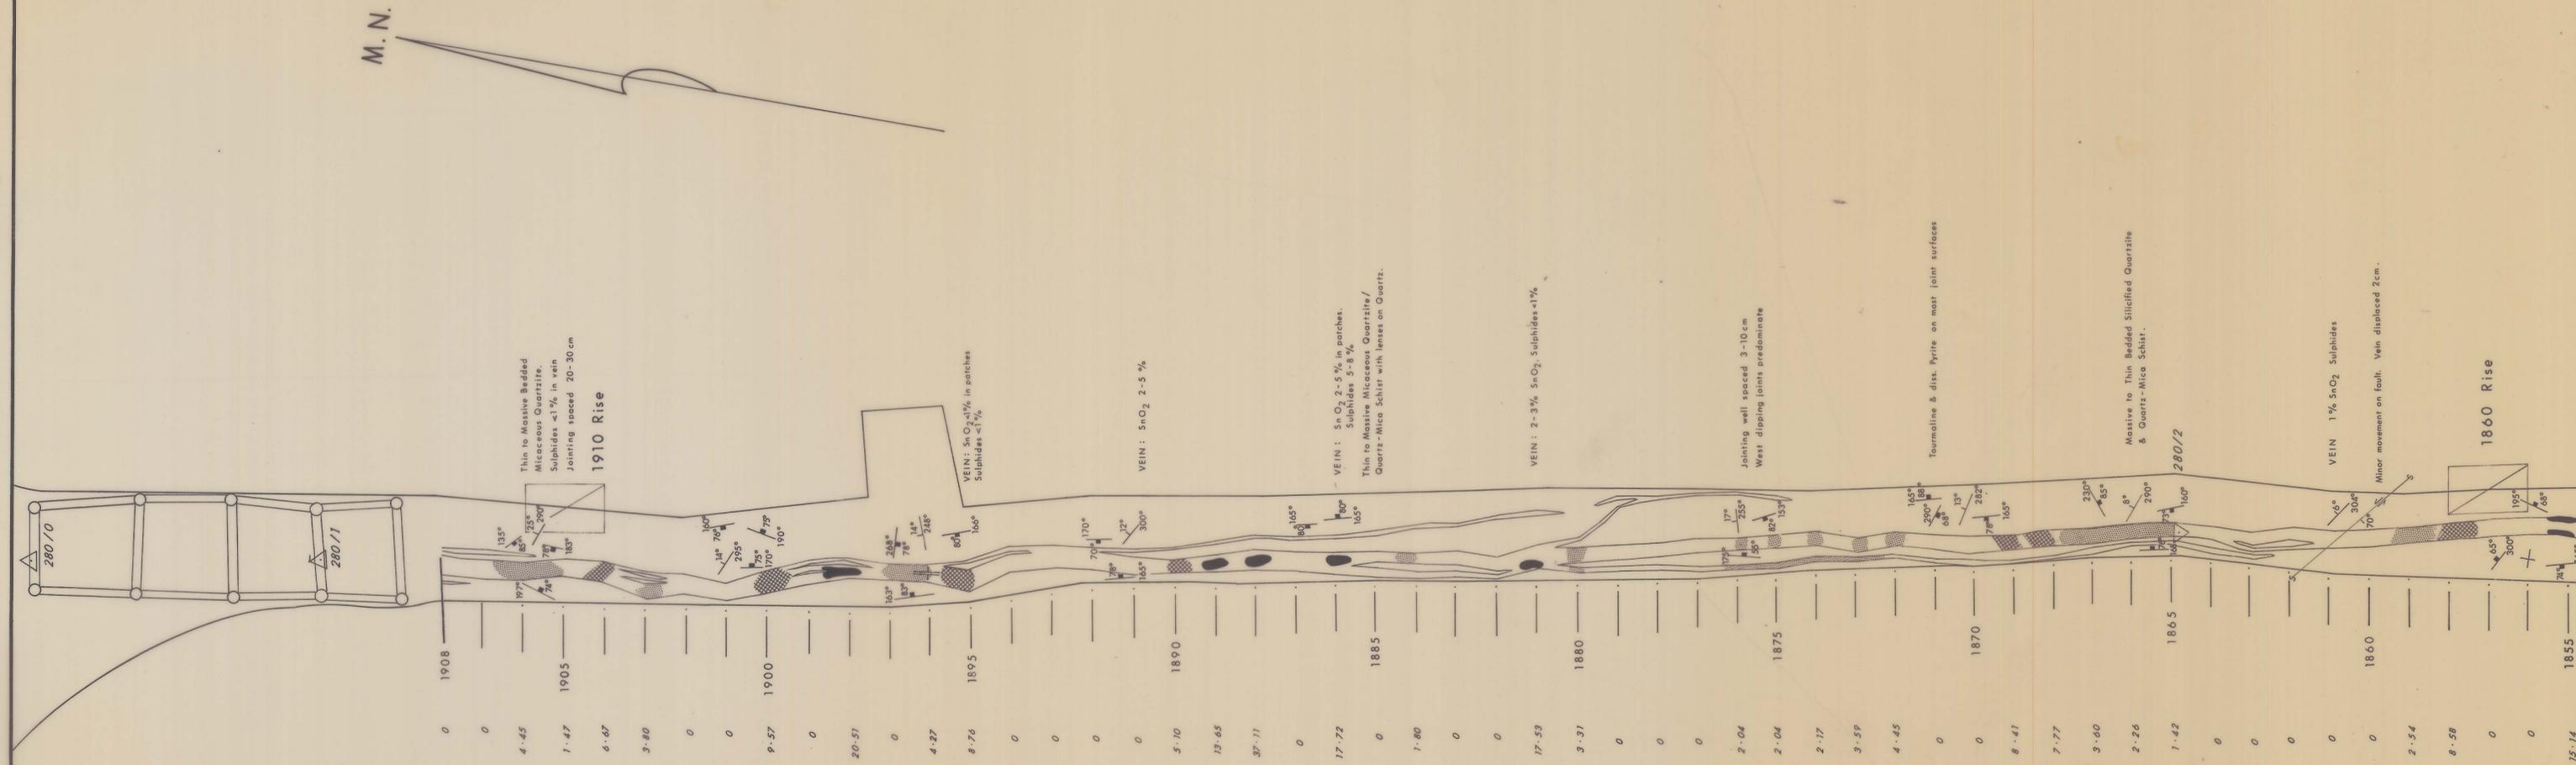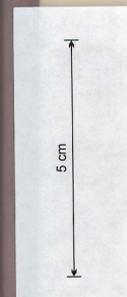

VISUALLY ESTIMATED ORE VALUES (POINT COUNTING)

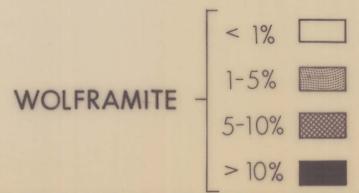

INTERVAL 1908 - 1858
ave. vein width = 51.12 cm
ave. vein grade = 4.21 % WO₃