

PLAN OF DECLINE
AS CONSTRUCTED TO
200 LEVEL

CENTRAL TASMANIAN TUNGSTEN
PTY. LTD.


PREPARED BY SECON AUSTRALIA



FILE NO 173-190 DATE DRAWN 5.3.88
LAWSON

Details of Decline Towers

TOWER	DATE	NO. OF TOWERS	NO. OF DECKS	NO. OF STAIRS	NO. OF LIFTS	NO. OF ESCAPE ROUTES
1	1987/02	4	1	1	1	1
2	1987/02	4	1	1	1	1
3	1987/02	4	1	1	1	1
4	1987/02	4	1	1	1	1
5	1987/02	4	1	1	1	1
6	1987/02	4	1	1	1	1
7	1987/02	4	1	1	1	1
8	1987/02	4	1	1	1	1
9	1987/02	4	1	1	1	1
10	1987/02	4	1	1	1	1

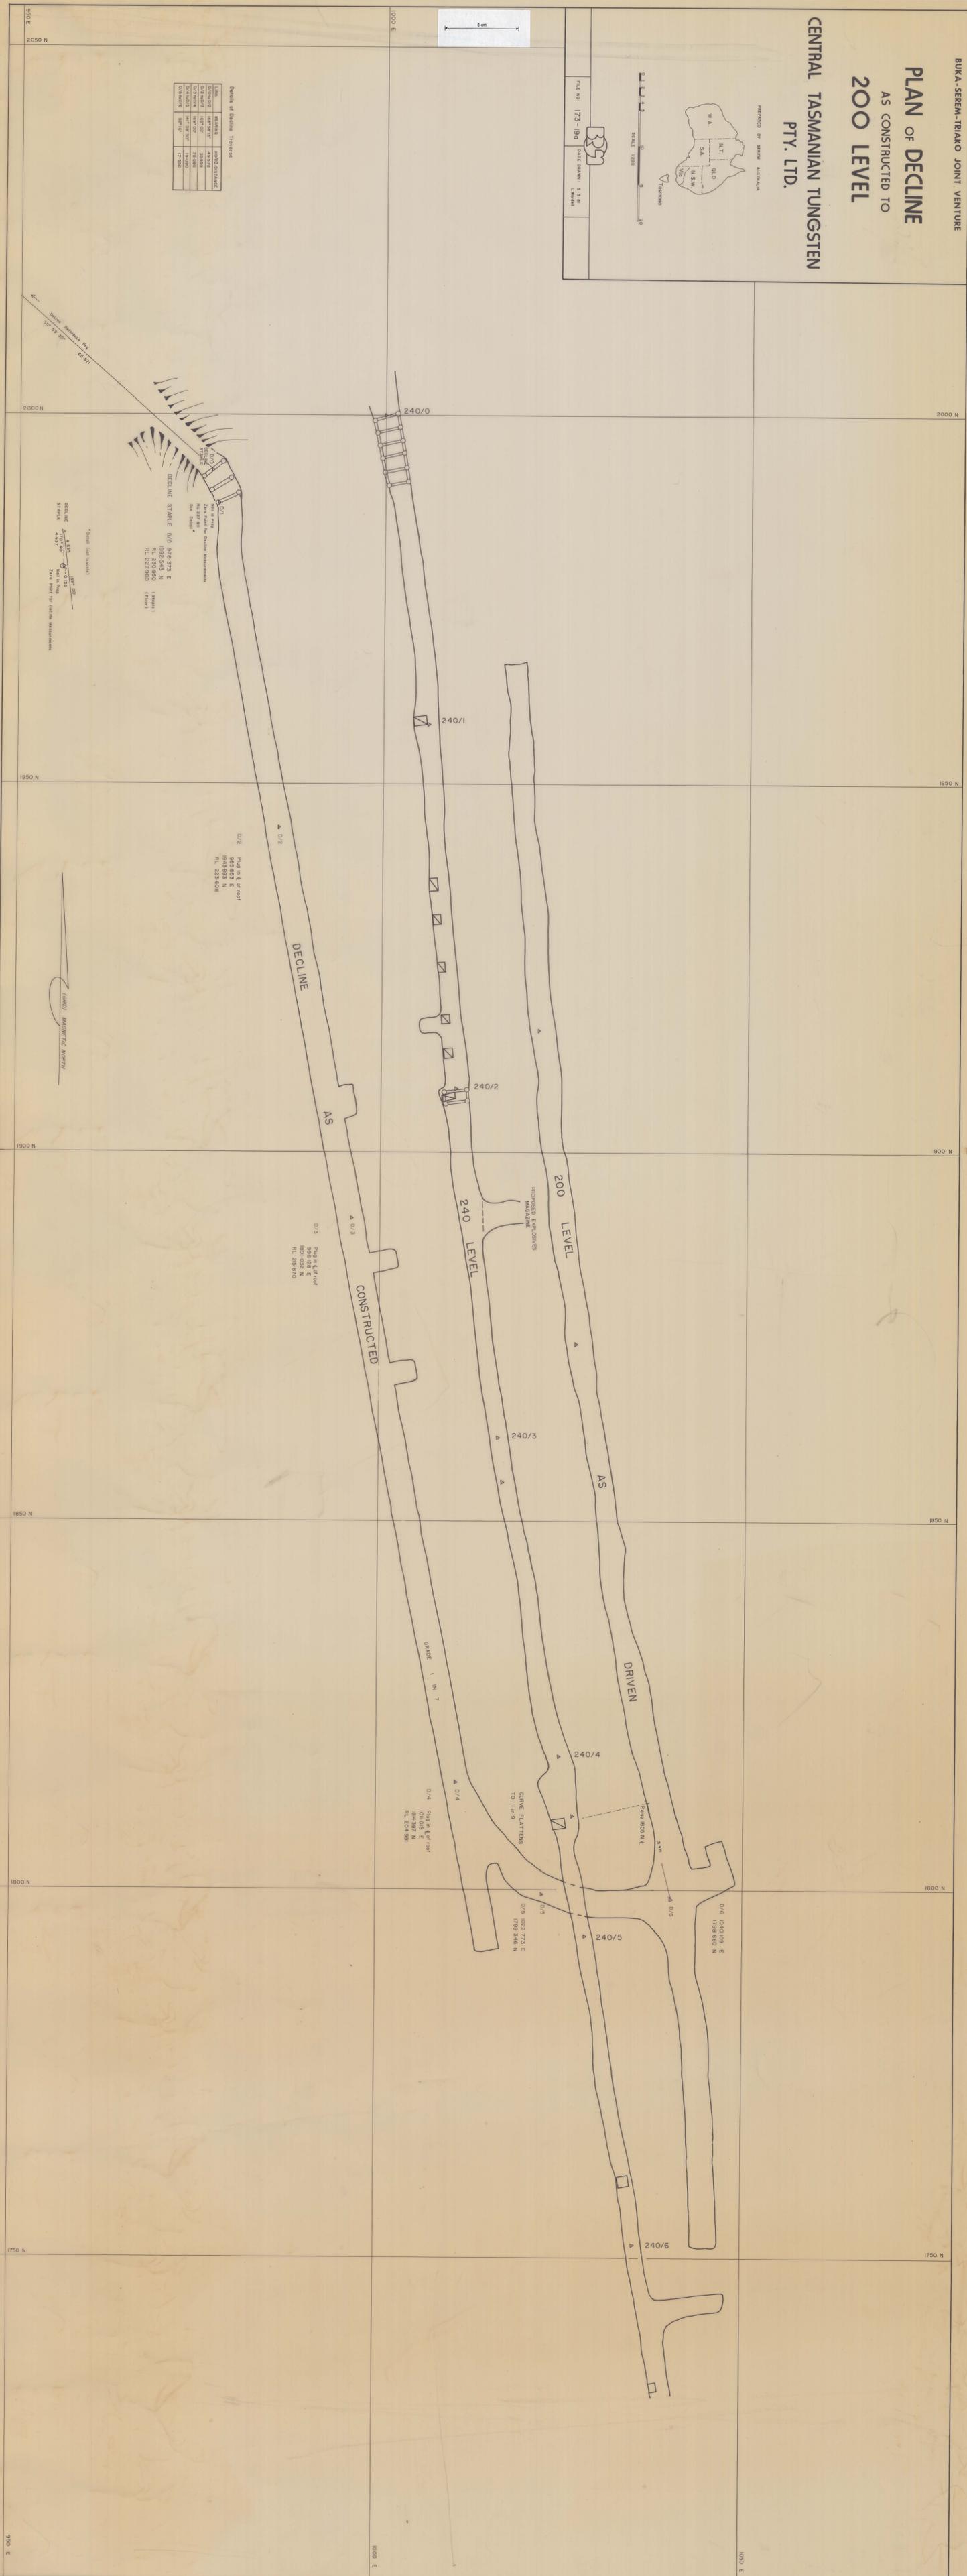

DECLINE STABLE D/O 976 373 E
RL 230 950 (BANK)
RL 229 950 (100%)
RL 229 950 (100%)

D/O 2 Peg in E of road
1894 883 N
RL 223 608

D/O 3 Peg in E of road
1891 032 N
RL 229 870

D/O 4 Peg in E of road
1801 038 E
RL 224 499

D/O 5 1022 773 E
1799 346 N

D/O 6 1040 028 E
1798 600 N

