


0400-02S

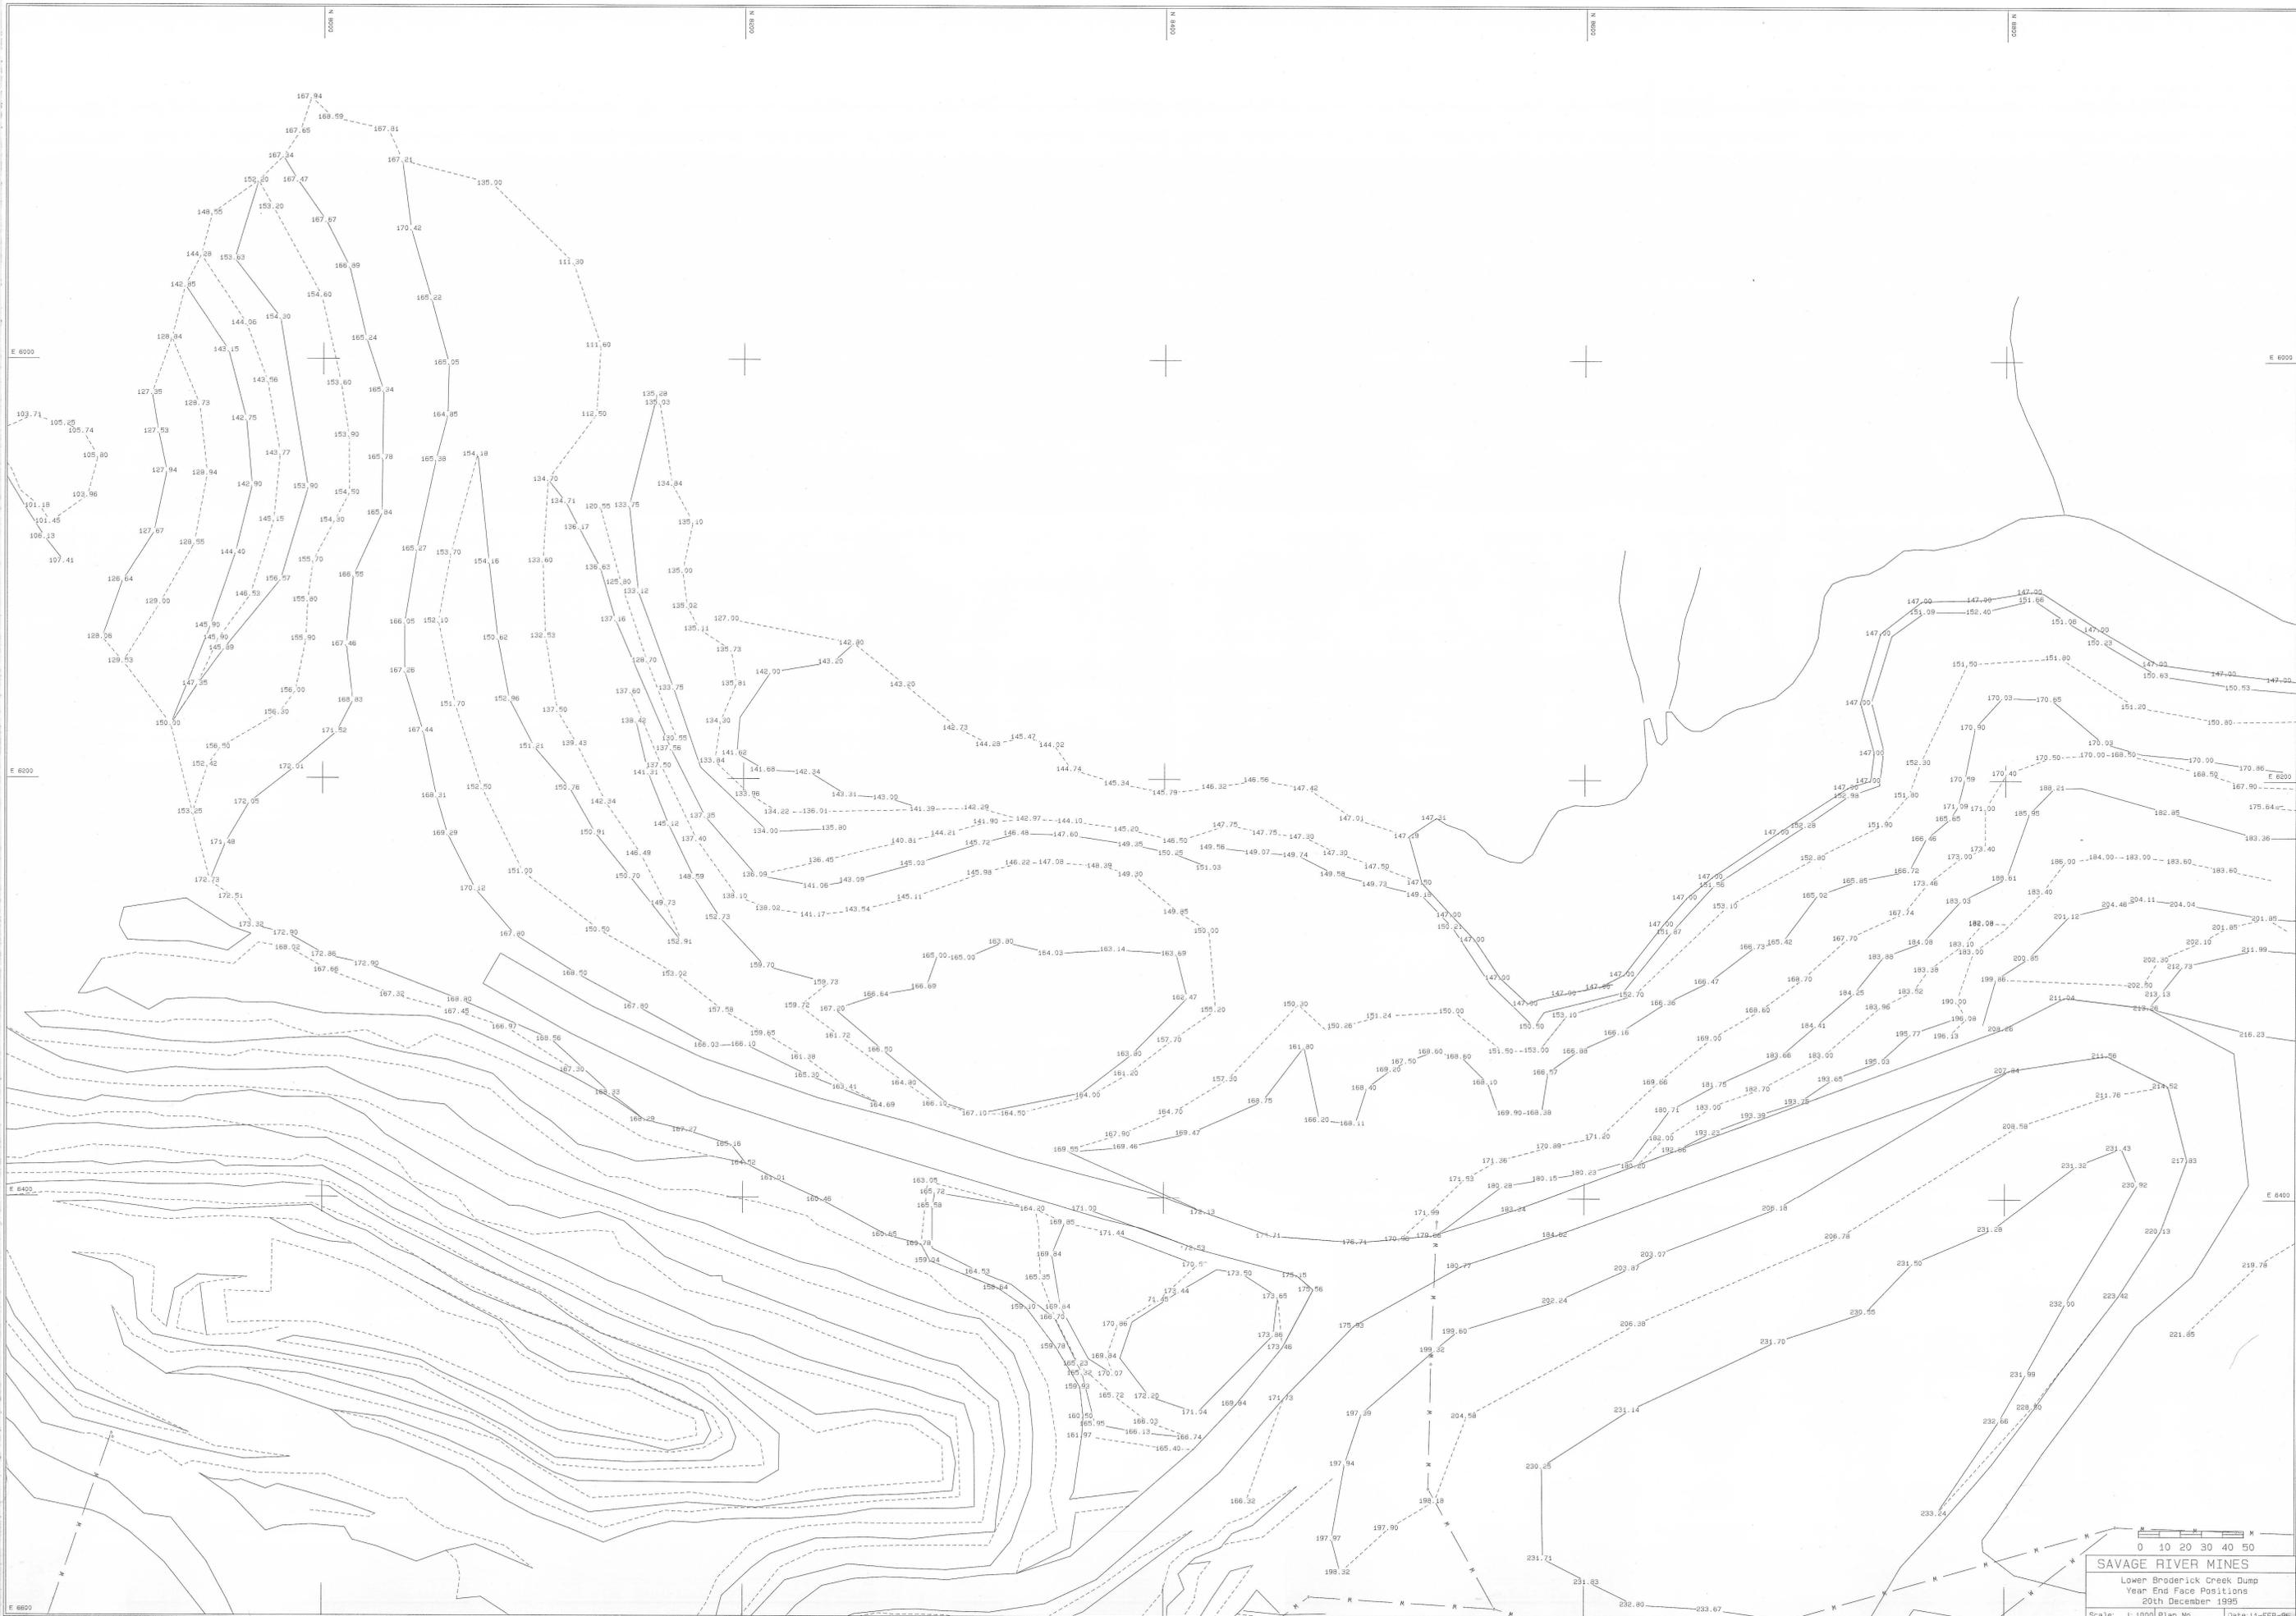

0 10 20 30 40 50

**SAVAGE RIVER MINES**  
 Lower Broderick Creek Dump  
 Year End Face Positions  
 20th December 1995

Scale: 1:1000 Plan No. Date: 11-FEB-96