


73

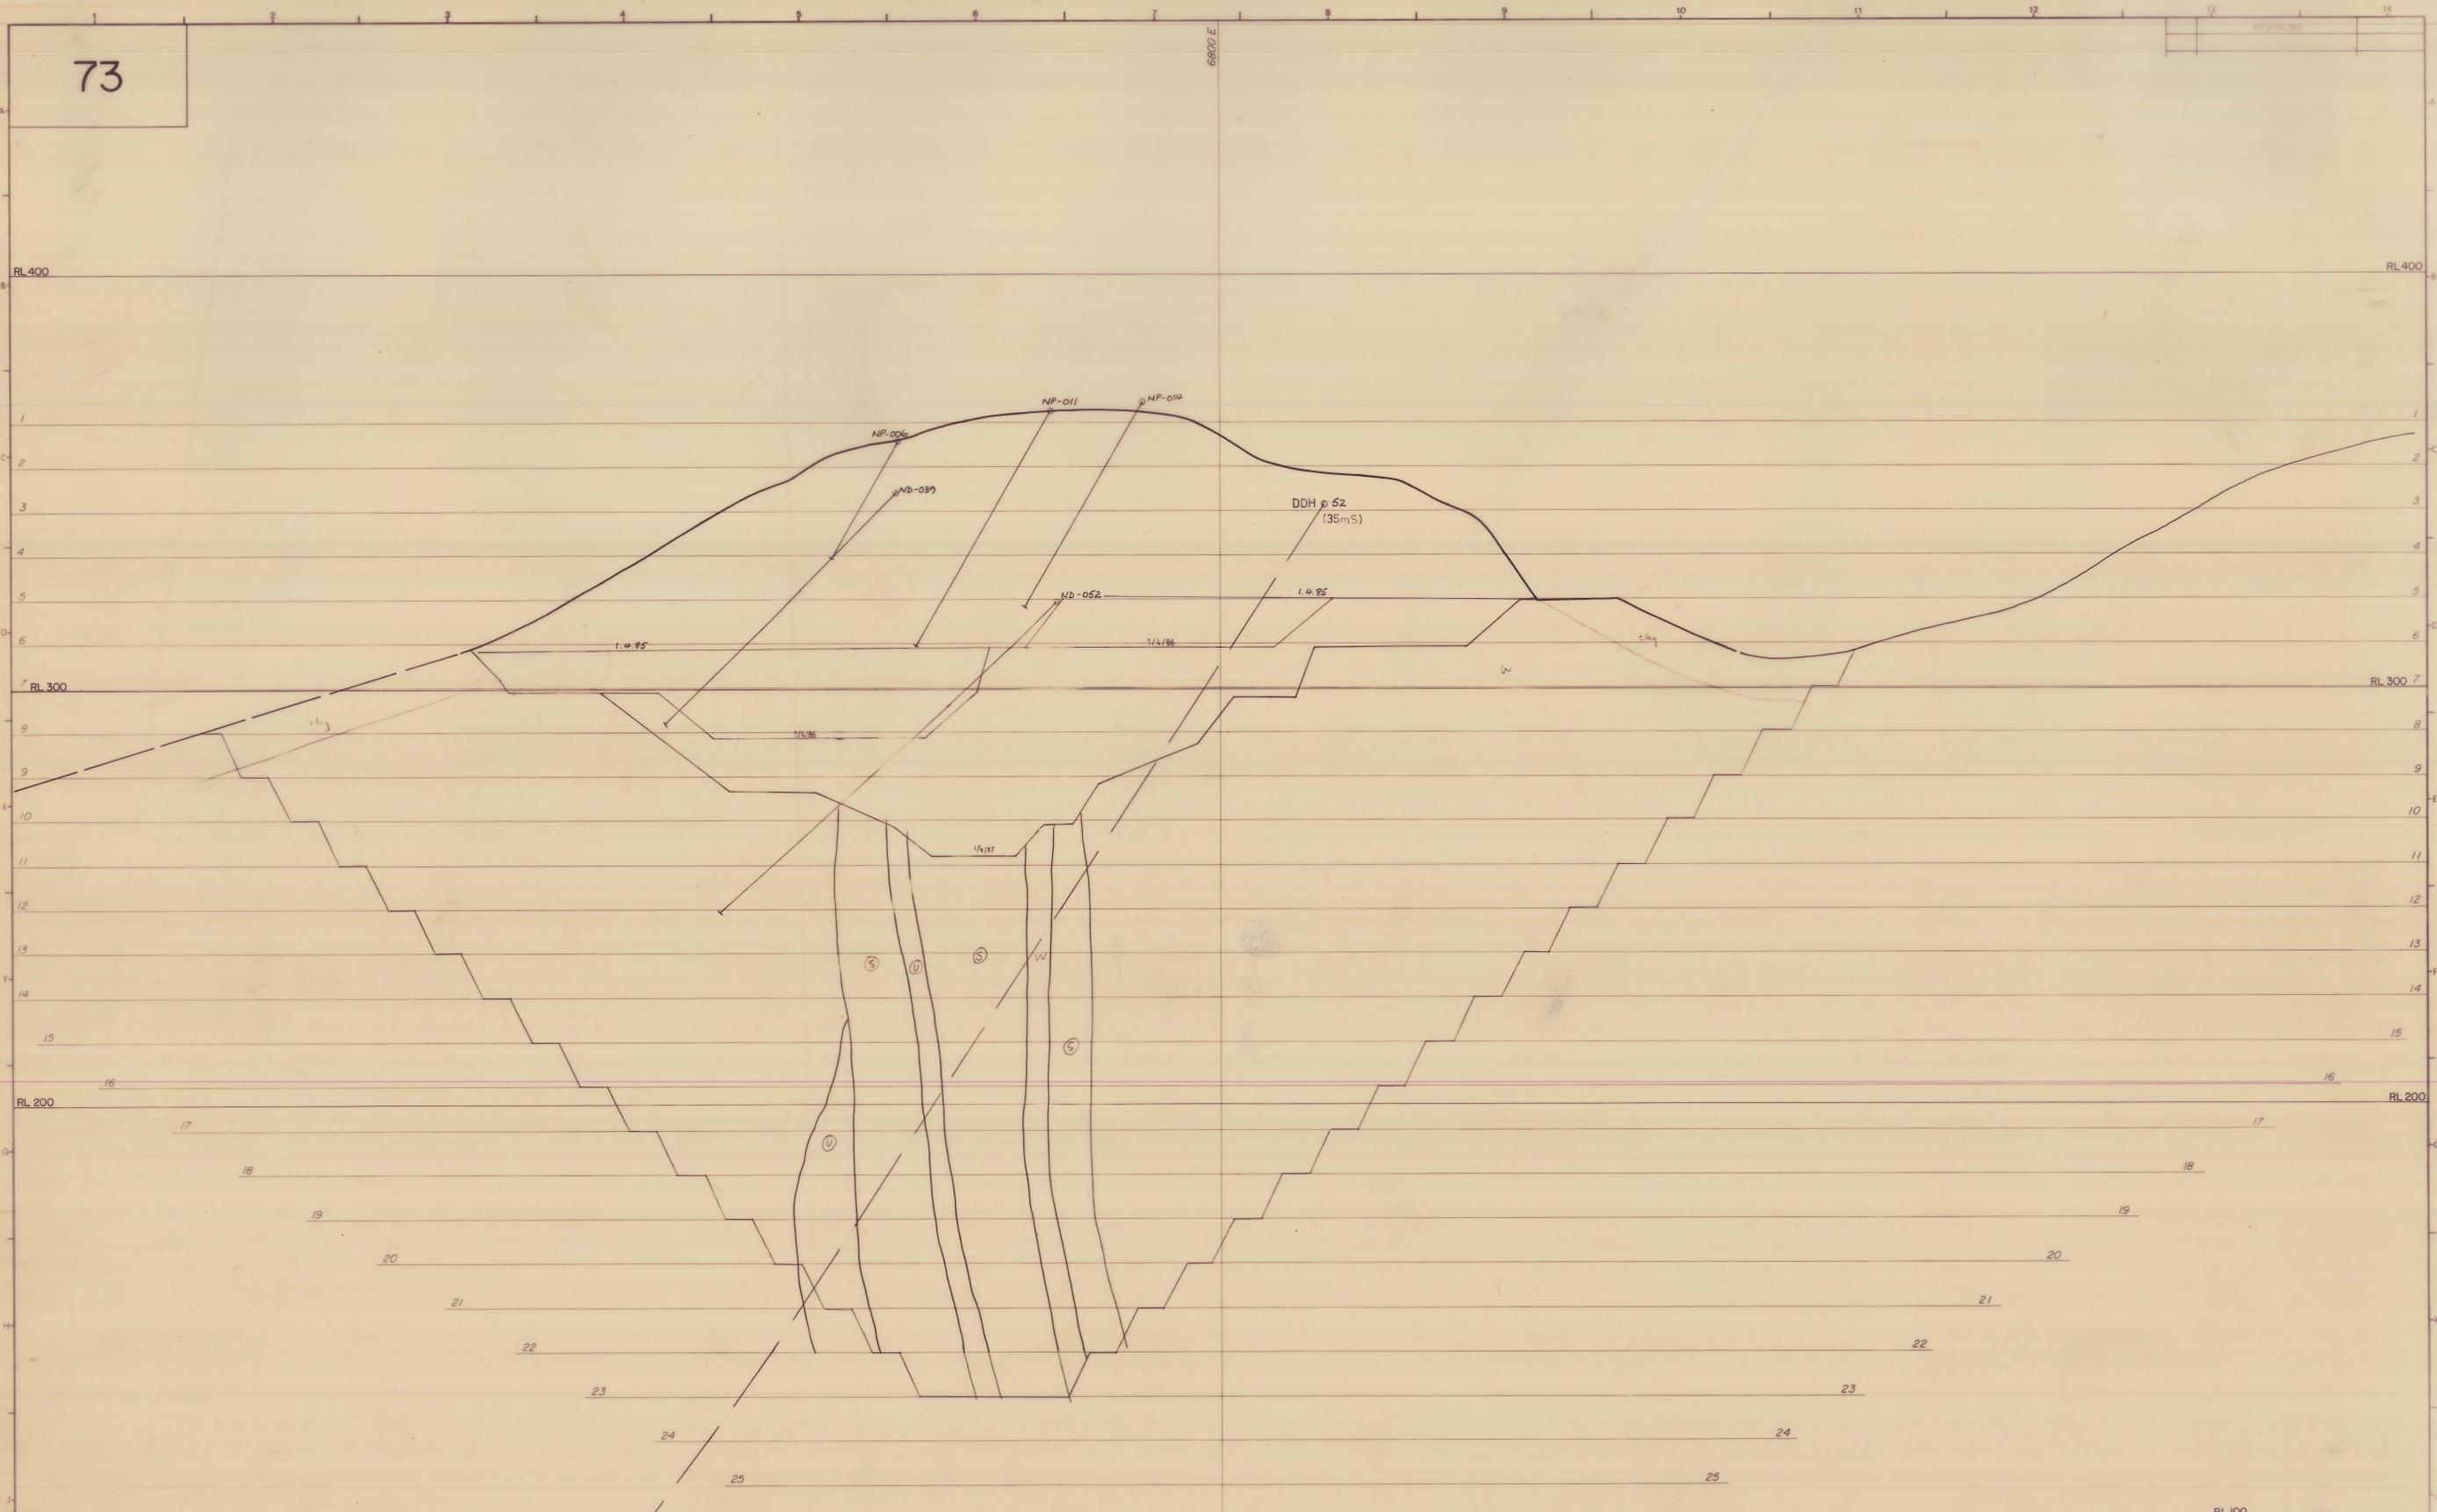

(16mN)

9340 Nth.
LOOKING NORTH

INFLUENCE WIDTH
50m



NORTHERN DEPOSIT

73

TOLERANCES UNLESS OTHERWISE STATED				THIRD ANGLE PROJECTION	
LINEAR DIMENSION	LINEAR TOLERANCE	ANGULAR DIMENSION	ANGULAR TOLERANCE	ALL DIMENSIONS ARE IN MILLIMETRES UNLESS OTHERWISE STATED.	
0	± 1.5	0°	$\pm 0.5^\circ$	DATE	
0.0	± 0.25	0.00°	$\pm 0.1^\circ$	DRAWN	
0.00	± 0.025	0.000°	$\pm 0.01^\circ$	APP	

LOC: ITEM QTY DESCRIPTION
SAVAGE RIVER MINES
 PICKANDS MATHER & CO. INTERNATIONAL
 MANAGING AGENT
 P.O. BOX 353, WYNYARD, TASMANIA, 7325

MINING CROSS SECTION

SCALE	1:600
AREA	
FILE	
DRG No.	

0400-045