




SECTION 7,400N LOOKING NORTH

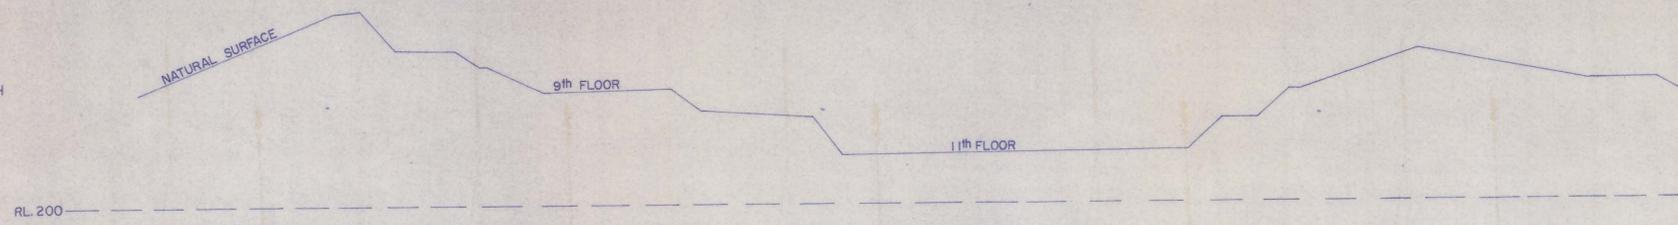

SECTION 7,000N LOOKING NORTH

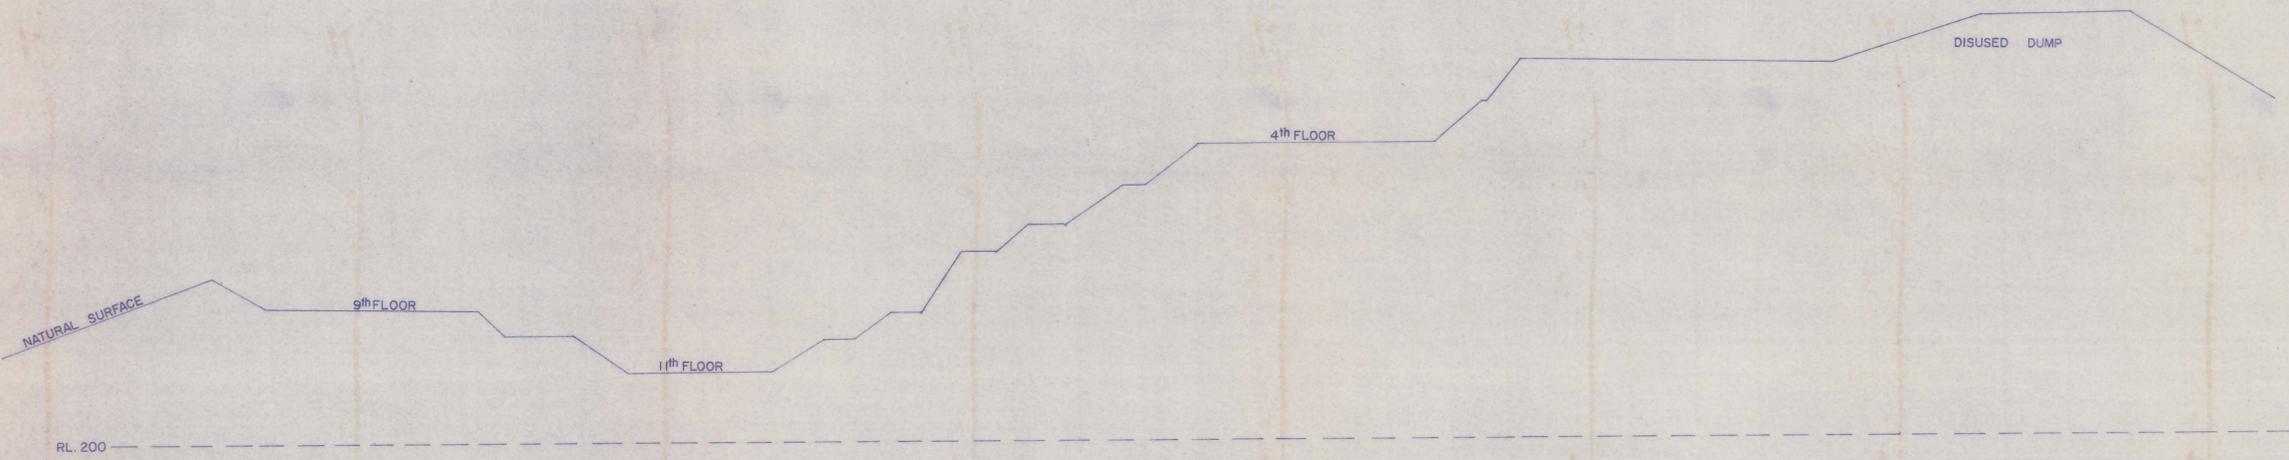

SECTION 6,400N LOOKING NORTH

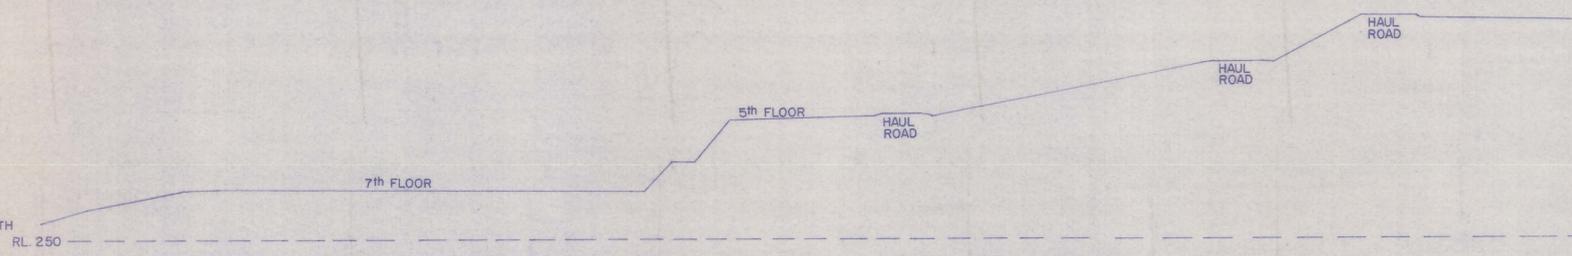

MICROFILMED



THIRD ANGLE PROJECTION			REVISIONS	
DR.	CH.	APP.		
SAVAGE RIVER MINES PICKANDS MATHER & CO. INTERNATIONAL MANAGING AGENT P.O. BOX 446, BURNIE, TASMANIA, 7320			SCALE 1/1000	
			DRG. No.	
TYPICAL CROSS SECTIONS OF PIT BANKS AT DECEMBER 31 ST 1973				

74-807

090 - 0070