



0400-061


SECTION 24,600 N LOOKING NORTH

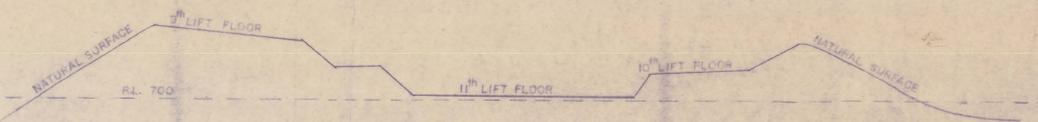

SECTION 23,110 N LOOKING NORTH

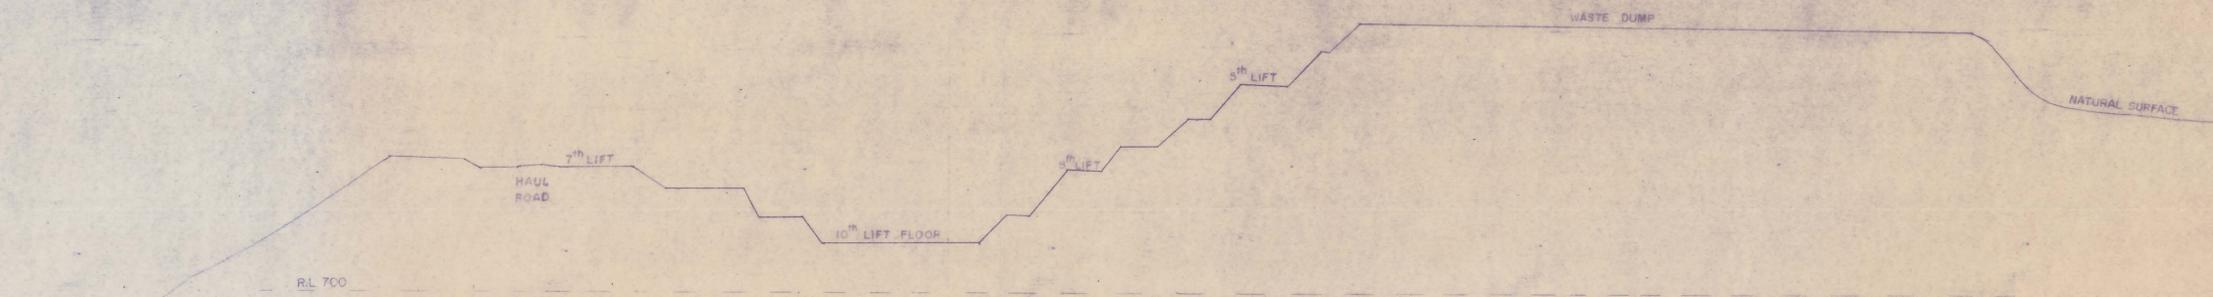

SECTION 21,950 N LOOKING NORTH

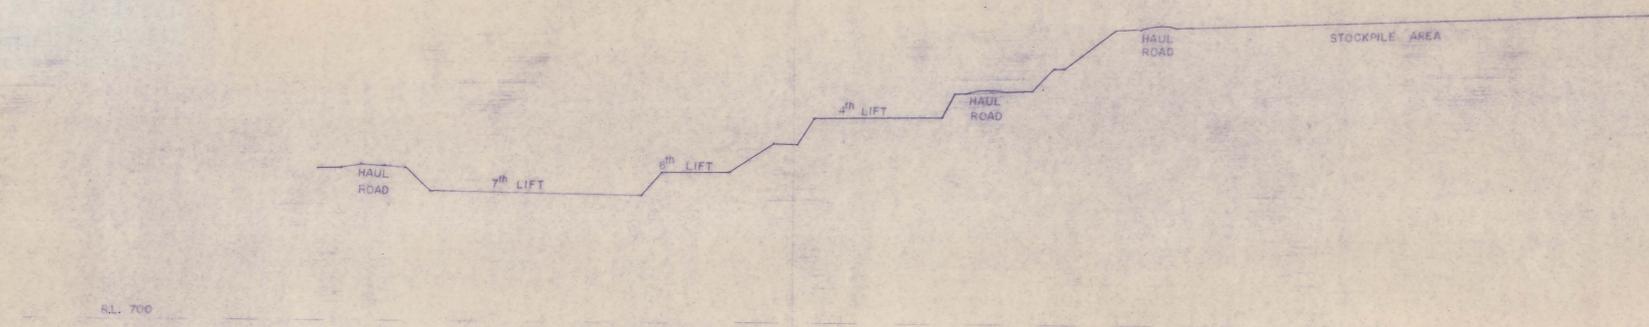

21,000 E

MICROFILMED

5m
0400-061

DR	CH	APP	REVISIONS	SCALE	1" = 100'
SAVAGE RIVER MINES PICKANDS MATHER & CO. INTERNATIONAL MANAGING AGENT P.O. BOX 446 BURNIE, TASMANIA 7320				DRG No	73059
TYPICAL CROSS SECTIONS OF PIT BANKS AT DECEMBER 28th 1972					