



REVISIONS	

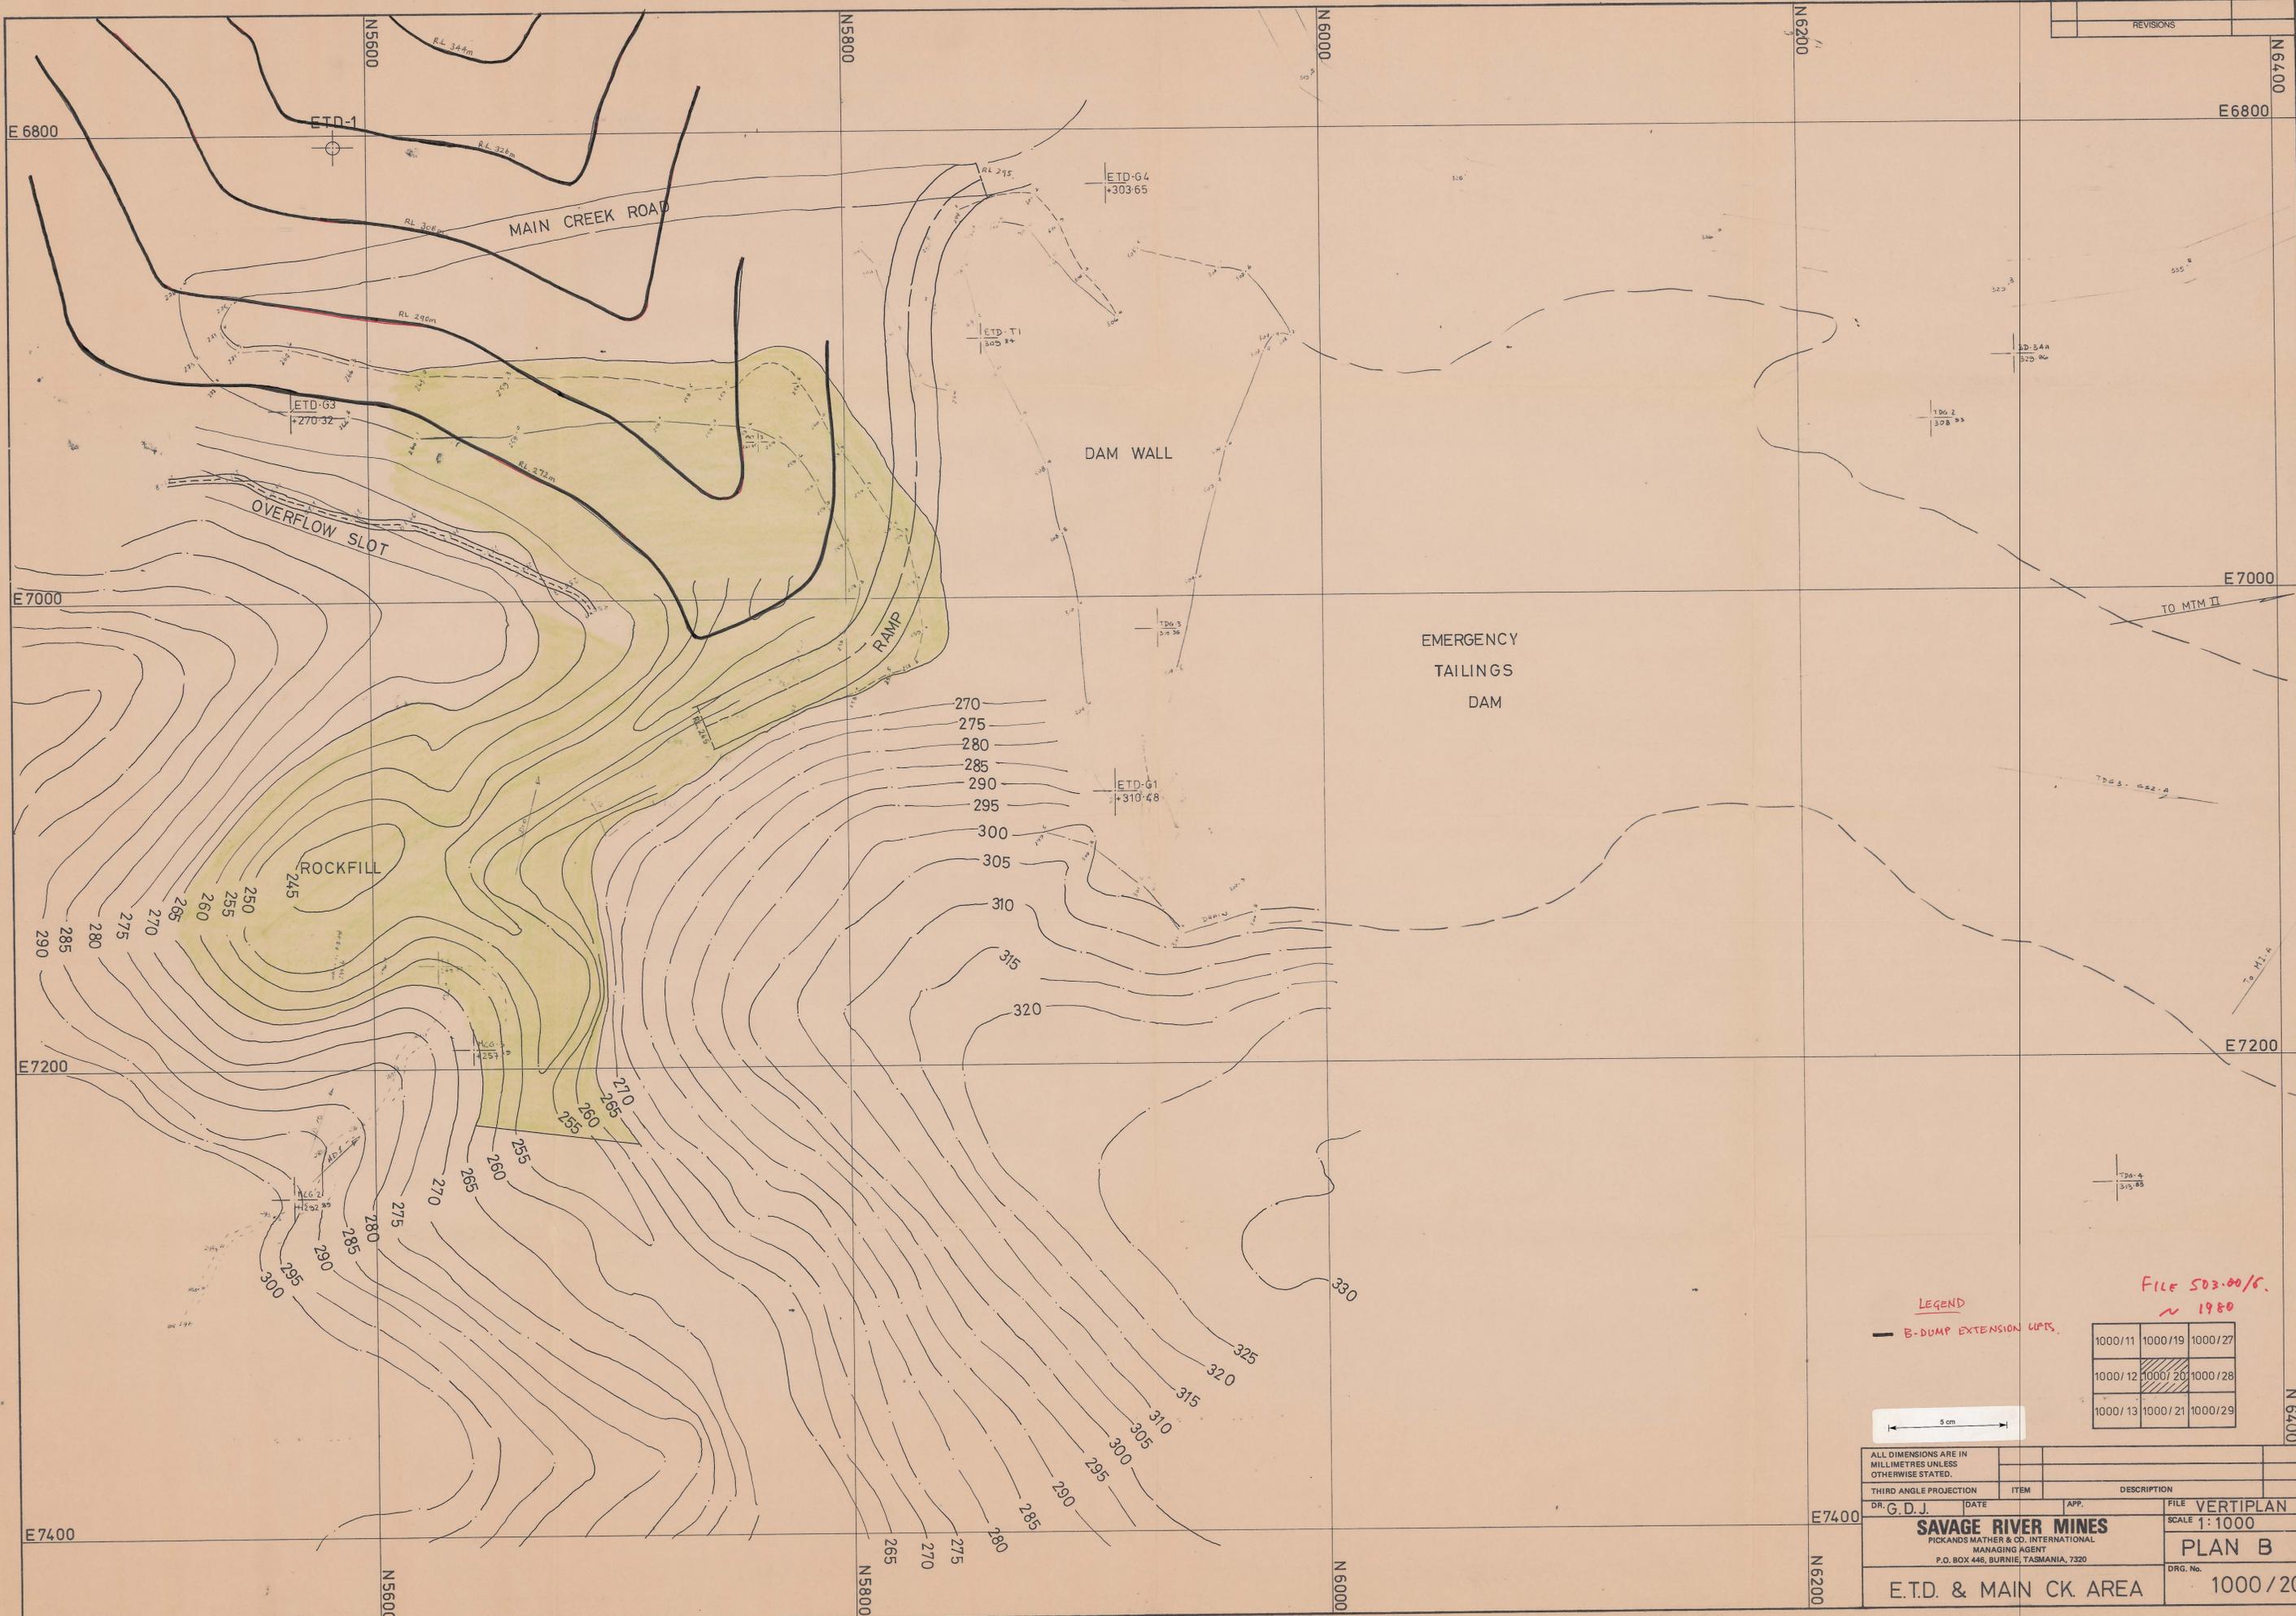

LEGEND
 - B-DUMP EXTENSION CURTS.

File 503-00/6
 ~ 1980

1000/11	1000/19	1000/27
1000/12	1000/20	1000/28
1000/13	1000/21	1000/29

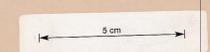

ALL DIMENSIONS ARE IN MILLIMETRES UNLESS OTHERWISE STATED.			
THIRD ANGLE PROJECTION	ITEM	DESCRIPTION	FILE
DR. G.D.J.	DATE	APP.	FILE VERTIPLAN
SAVAGE RIVER MINES PICKANDS MATHER & CO. INTERNATIONAL MANAGING AGENT P.O. BOX 446, BURNIE, TASMANIA, 7320			SCALE 1:1000
E.T.D. & MAIN CK. AREA			PLAN B
			DRG. No. 1000/20

0400_075

0006/0003