


SECTION E-E



SECTION F-F

Vertical Scale 1:500
 Horizontal Scale 1:1000

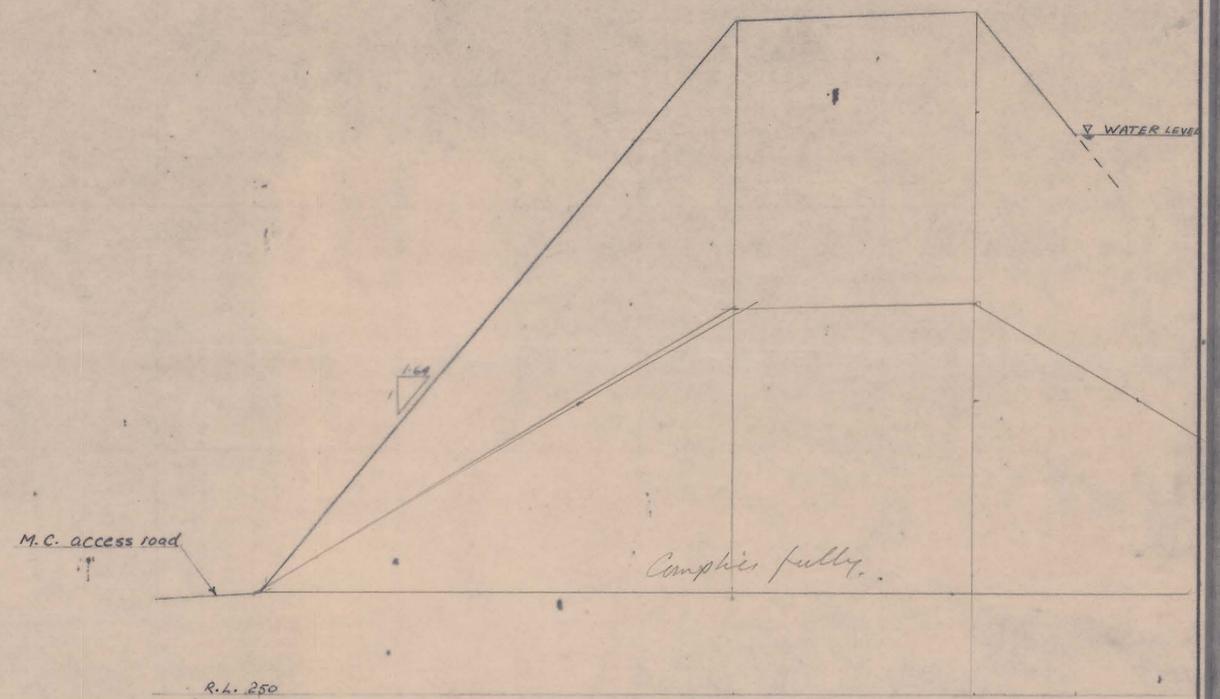

EMERGENCY TAILINGS DAM
 CROSS SECTIONS (For plan see GS-19)

FILE 503.00/6
~~23-12-85~~
 10-7-80

DEPARTMENT OF MINES
 BURNIE
 RECEIVED 4 JUN 1980
 ANSWERED
 REF. No.

SRM ETD
 Drawn. J. HOLMES
 DATE 5-6-80
 GS-19-02