




SECTION A-A

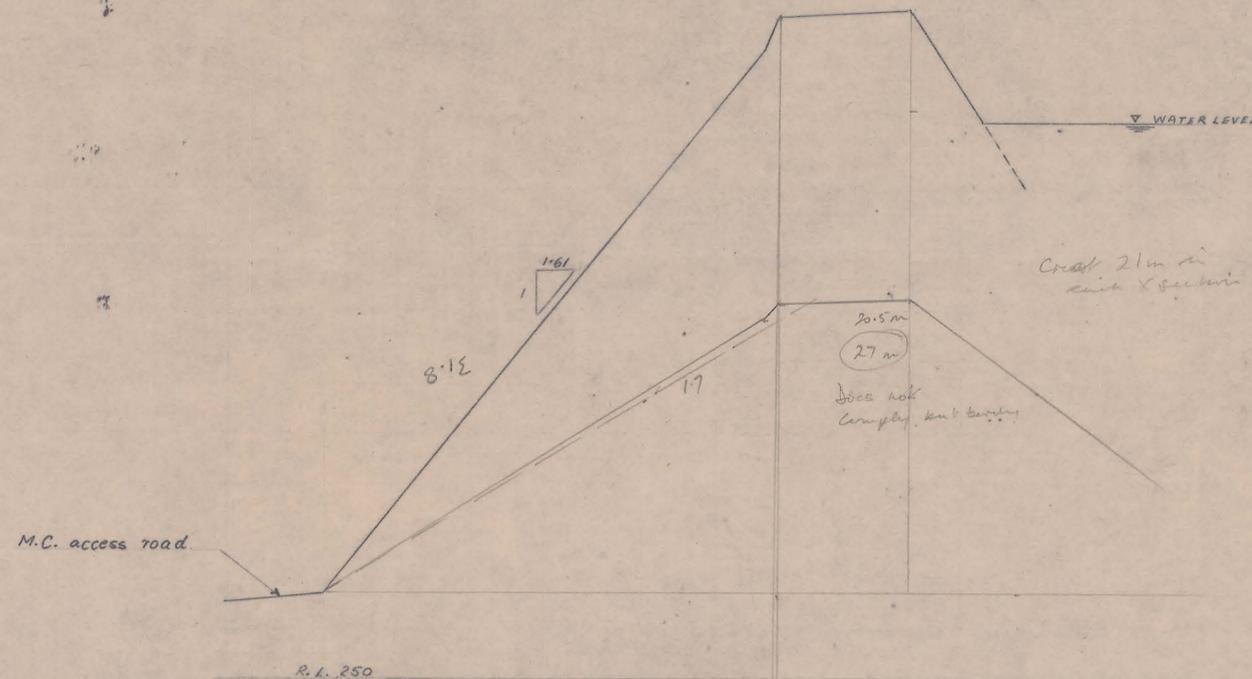

SECTION B-B

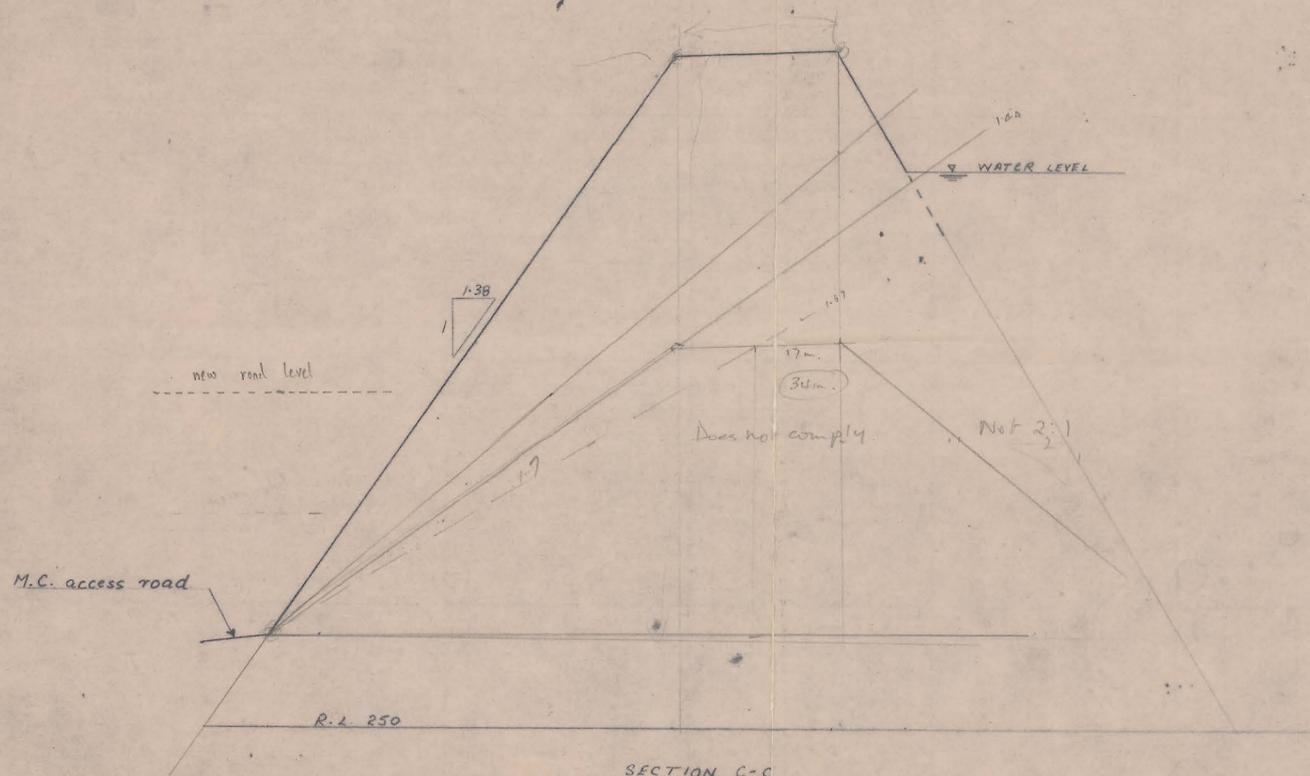

SECTION C-C

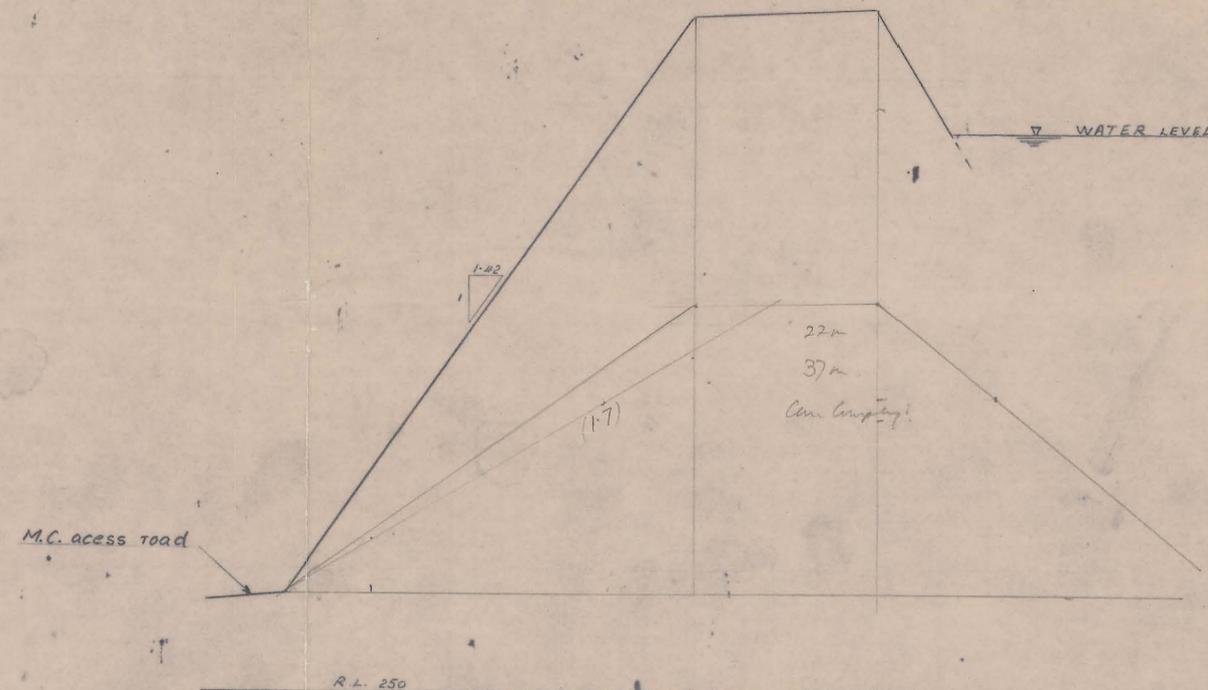


SECTION D-D

Vertical Scale 1:500
Horizontal Scale 1:1000

EMERGENCY TAILINGS DAM
CROSS SECTIONS (For plan see GS-19)

~~23-12-75~~
FILE 503.00/6.
10-7-80

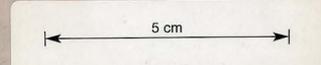

DEPARTMENT OF MINES BURNIE	S.M.E.
RECEIVED 24 JUN 1980	
PREPARED	
No.	

S.R.M.	ETD
Drawn: J. HOLMES	
DATE: 5-6-80	GS-19-03