


0401-002

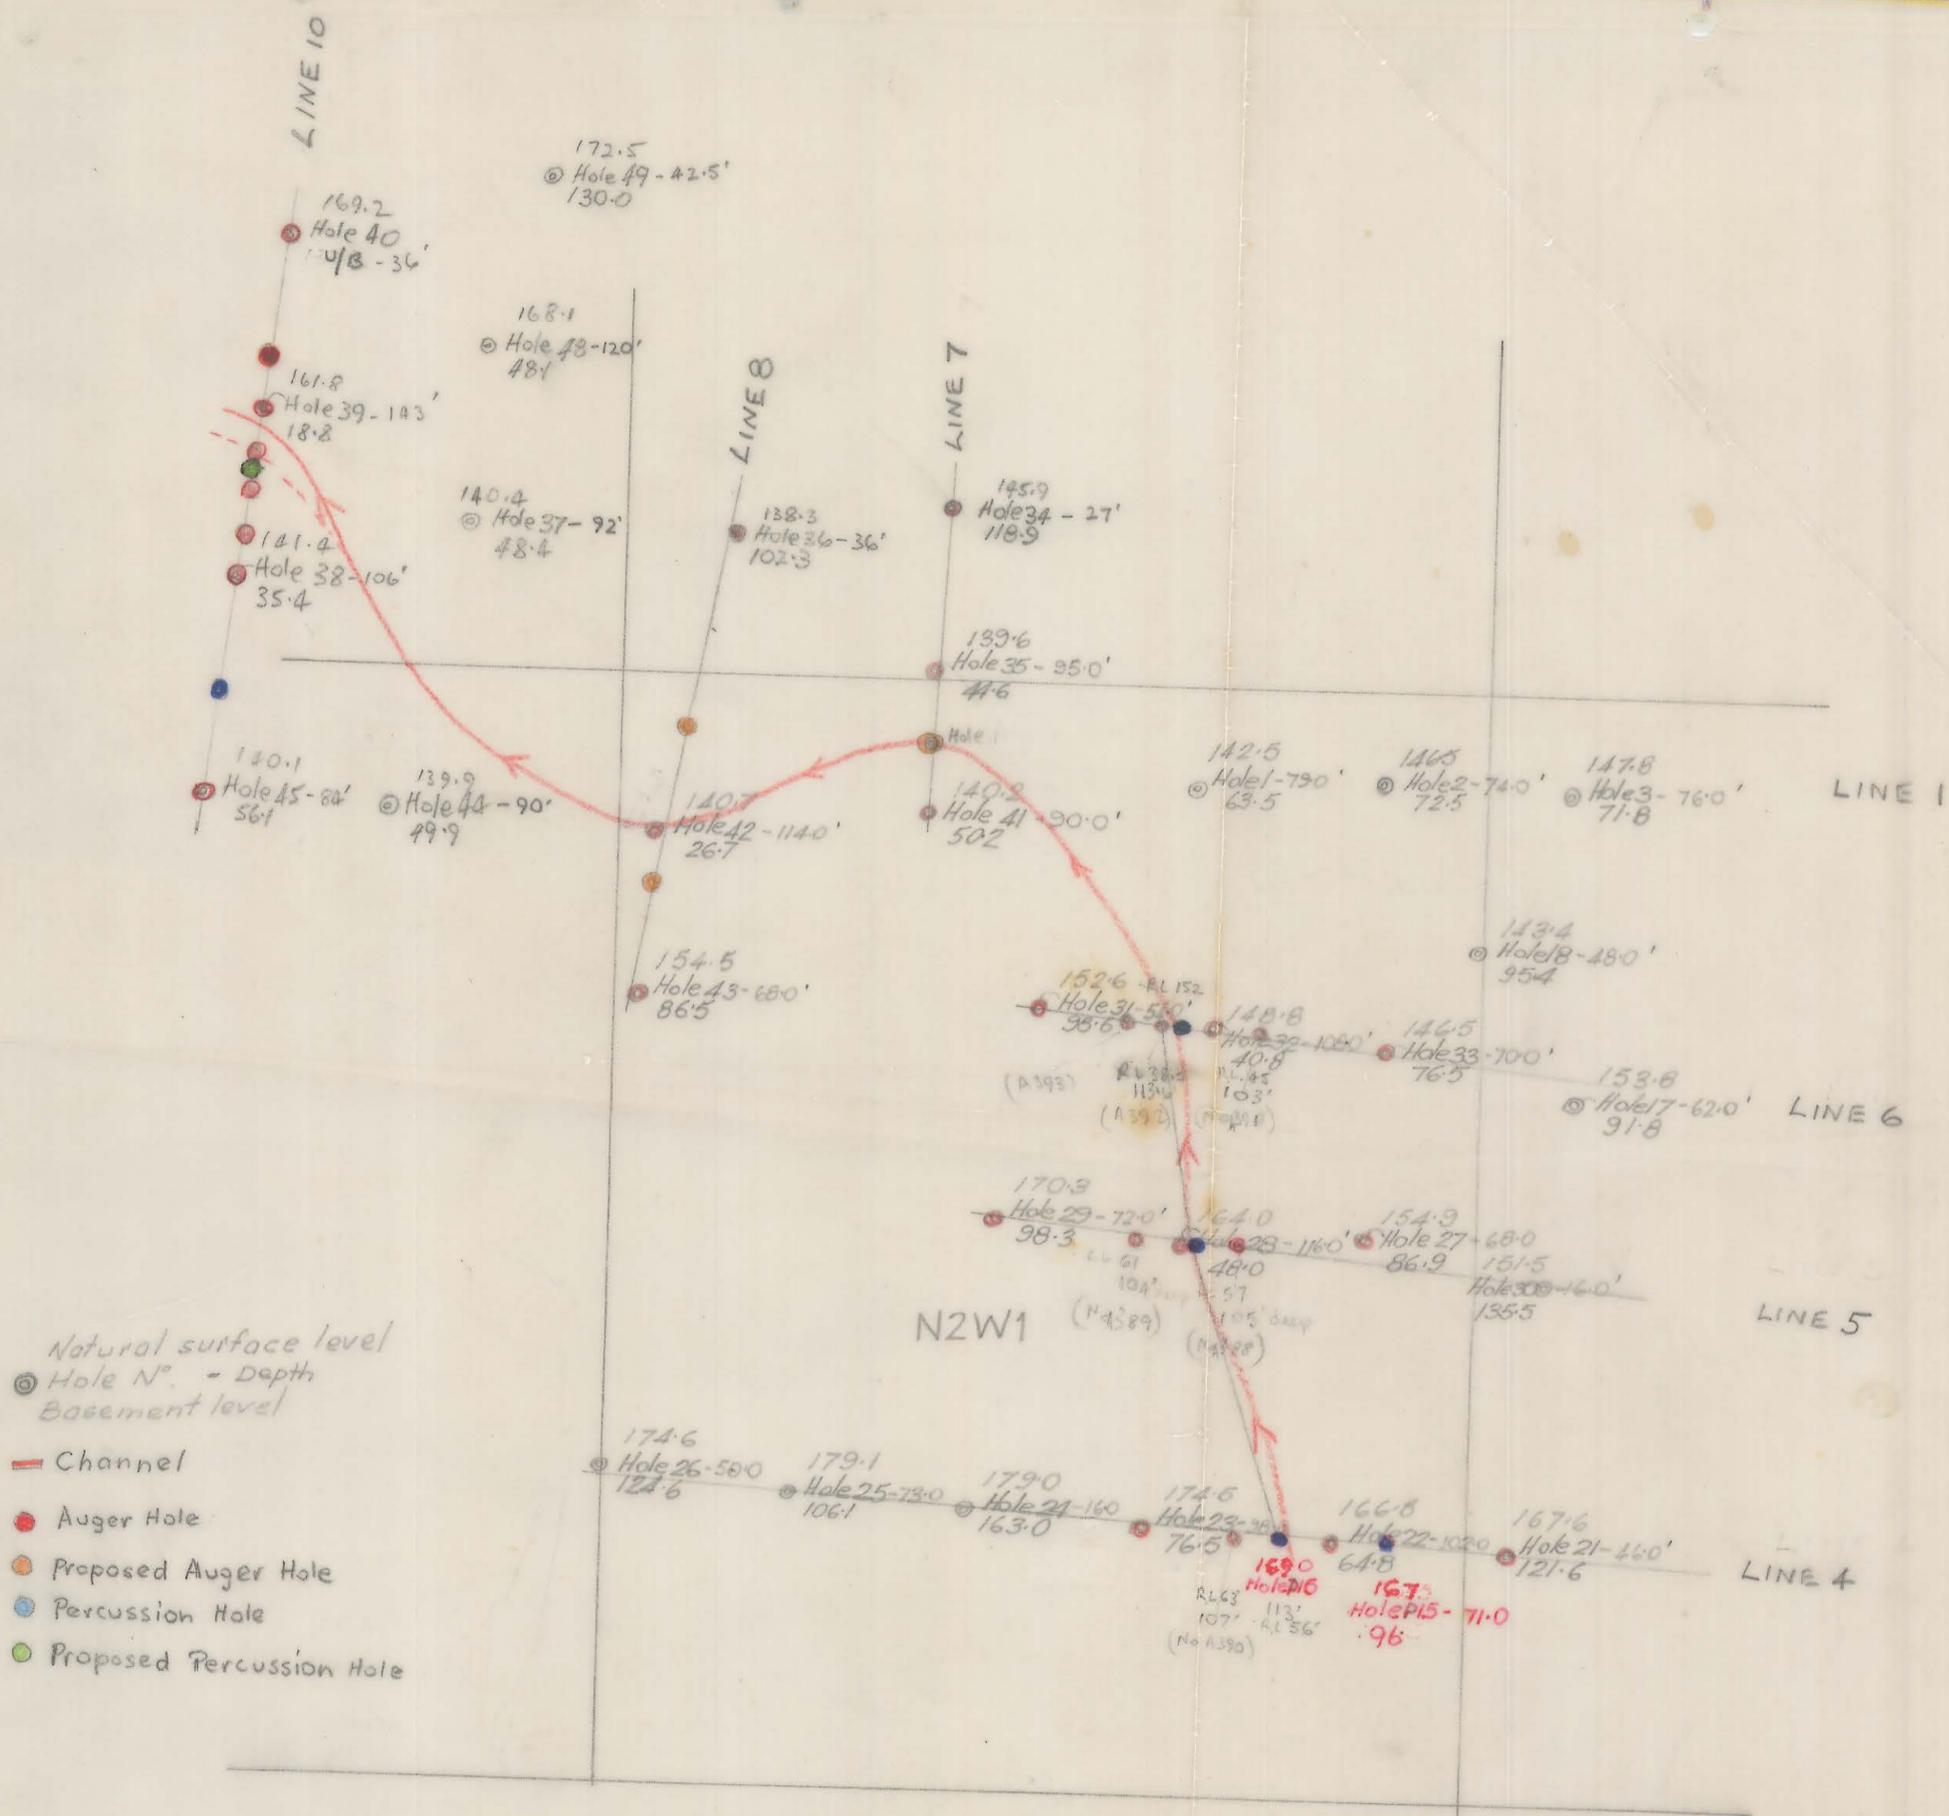

5 cm  
 0401-002

NORTH SCOTIA  
 DRILLHOLE LOCATIONS  
 B.M.I. Mining Pty. Limited.  
 Launceston T.A.S.  
 Scale 1" = 5ch (330ft) 29/6/71  
 Z.K.  
 Amended 2/7/71