


0401_066

0401_066

5 cm

SEE N4W2

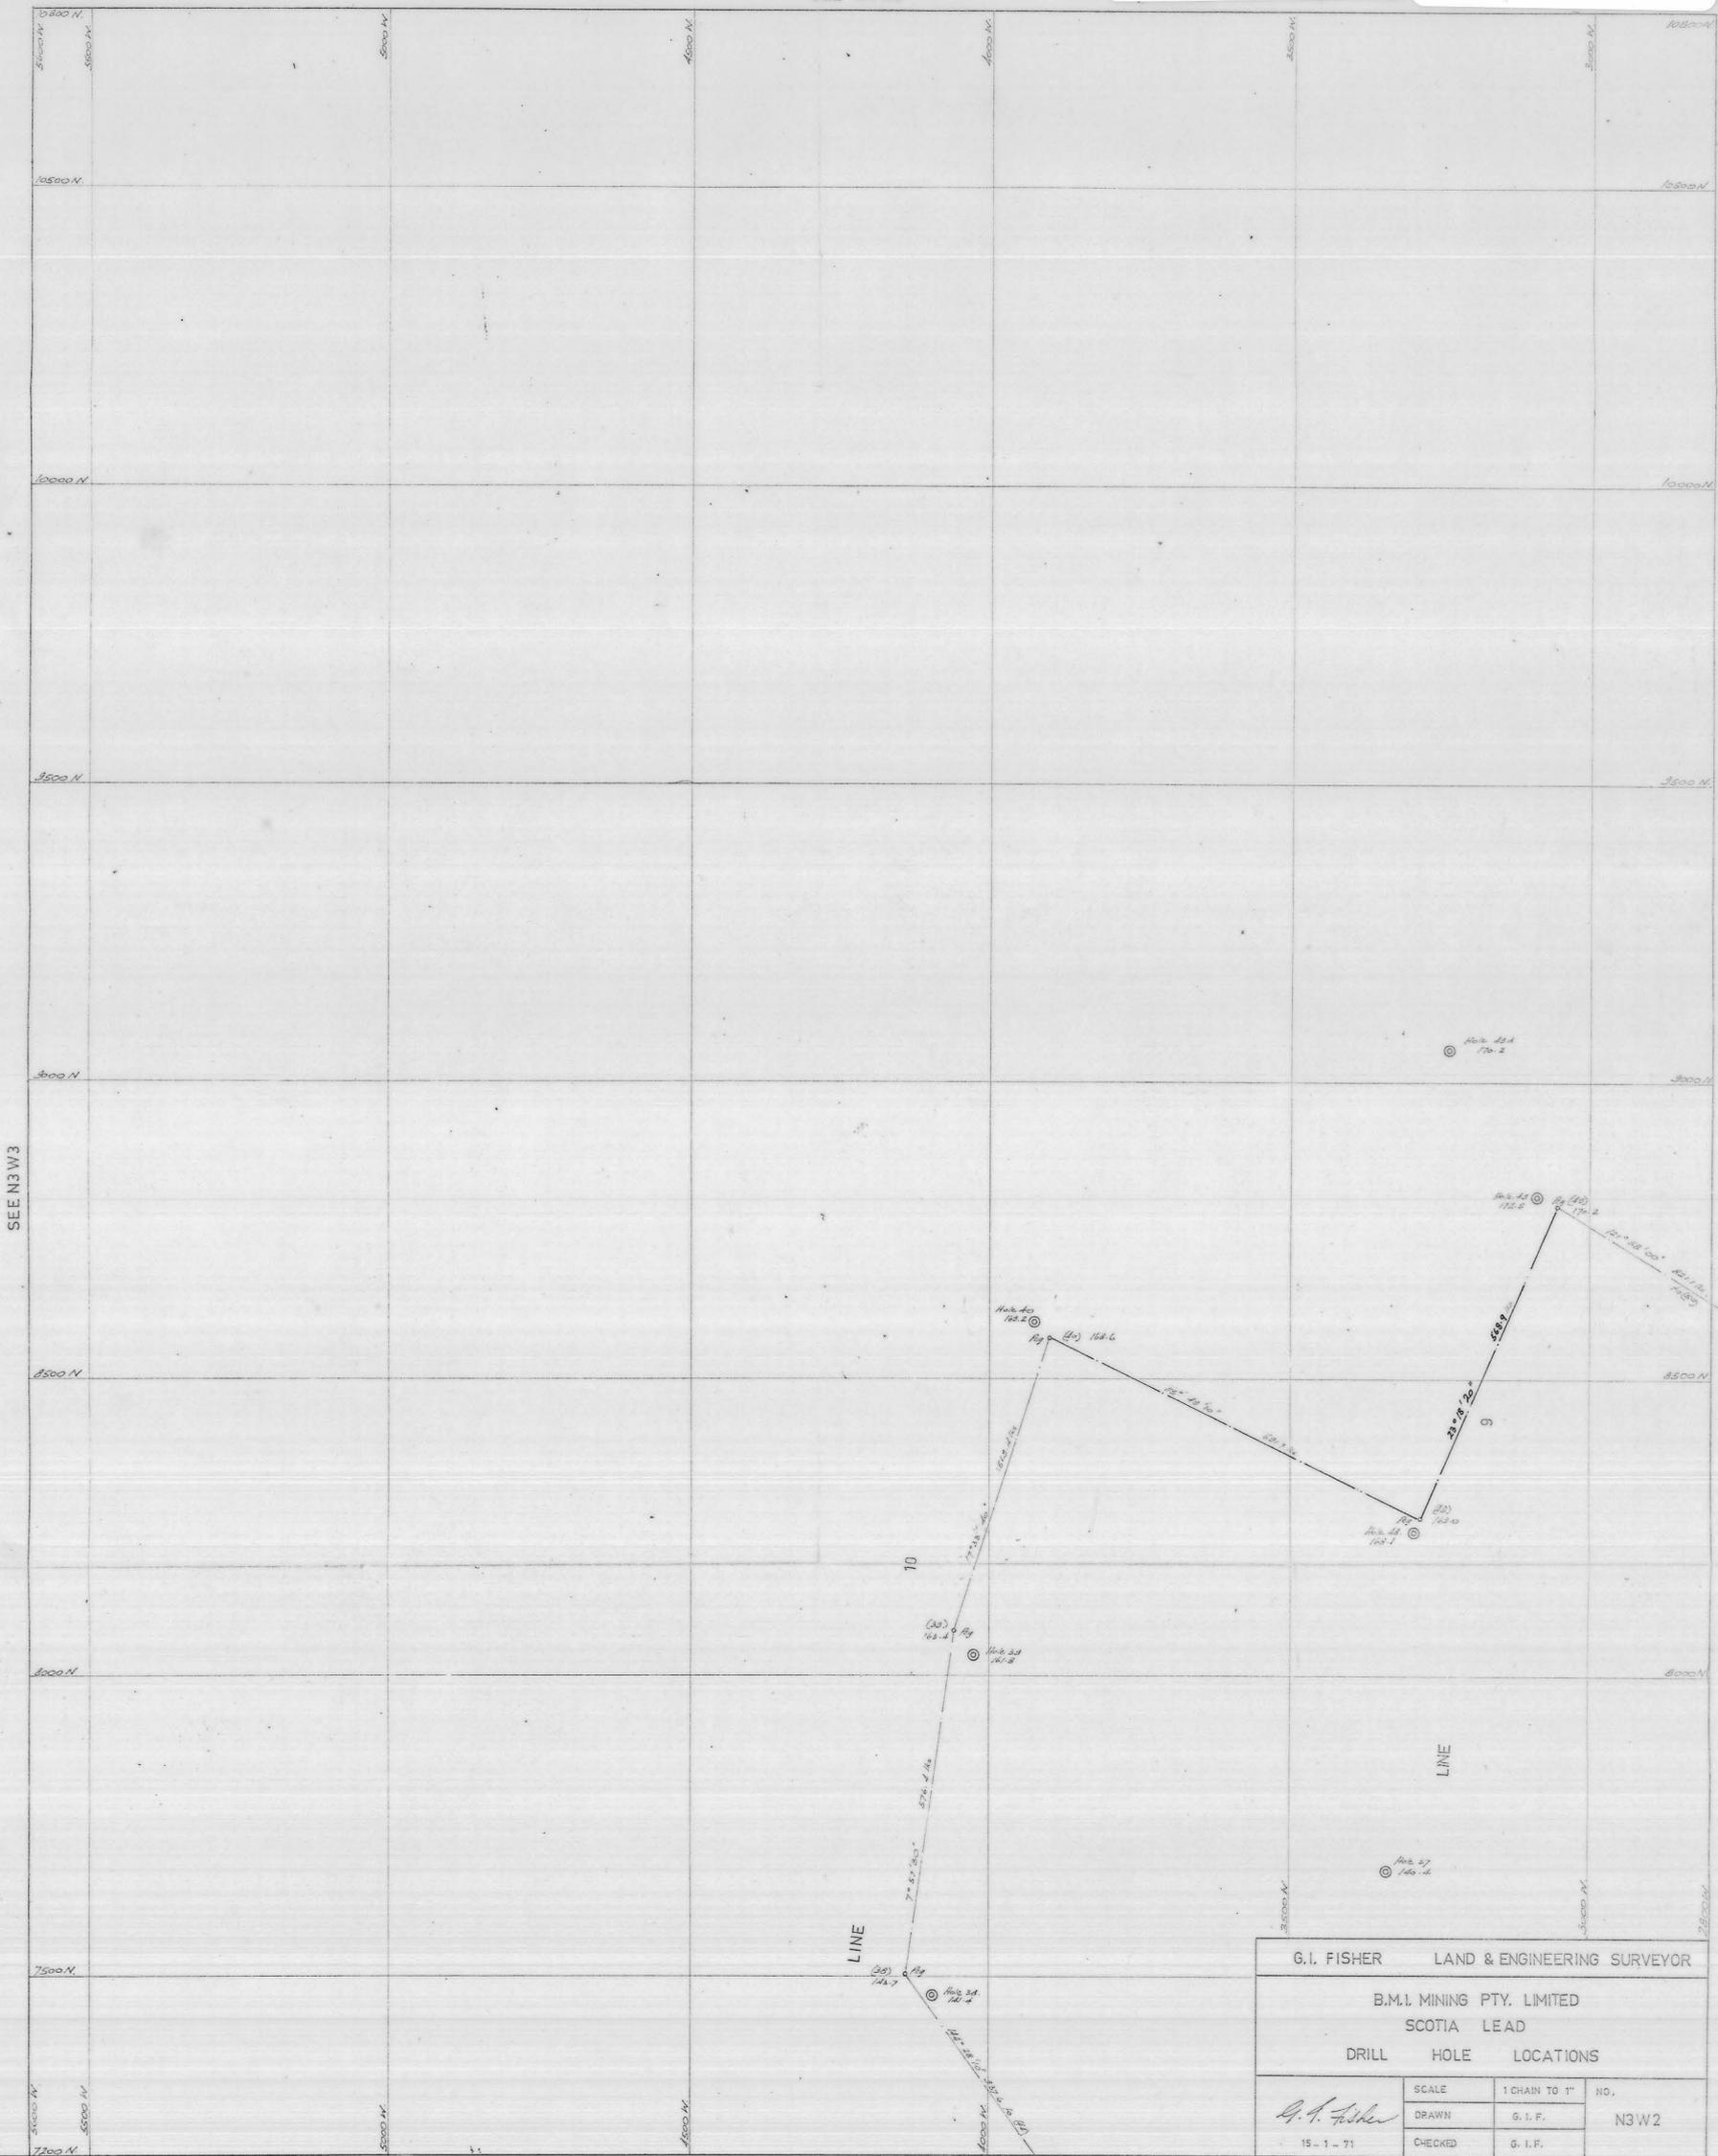

G.I. FISHER		LAND & ENGINEERING SURVEYOR	
B.M.I. MINING PTY. LIMITED			
SCOTIA LEAD			
DRILL HOLE LOCATIONS			
<i>G.I. Fisher</i>	SCALE	1 CHAIN TO 1"	NO.
	DRAWN	G. I. F.	N3W2
	CHECKED	G. I. F.	
15-1-71			

Fig 32