


0401-068

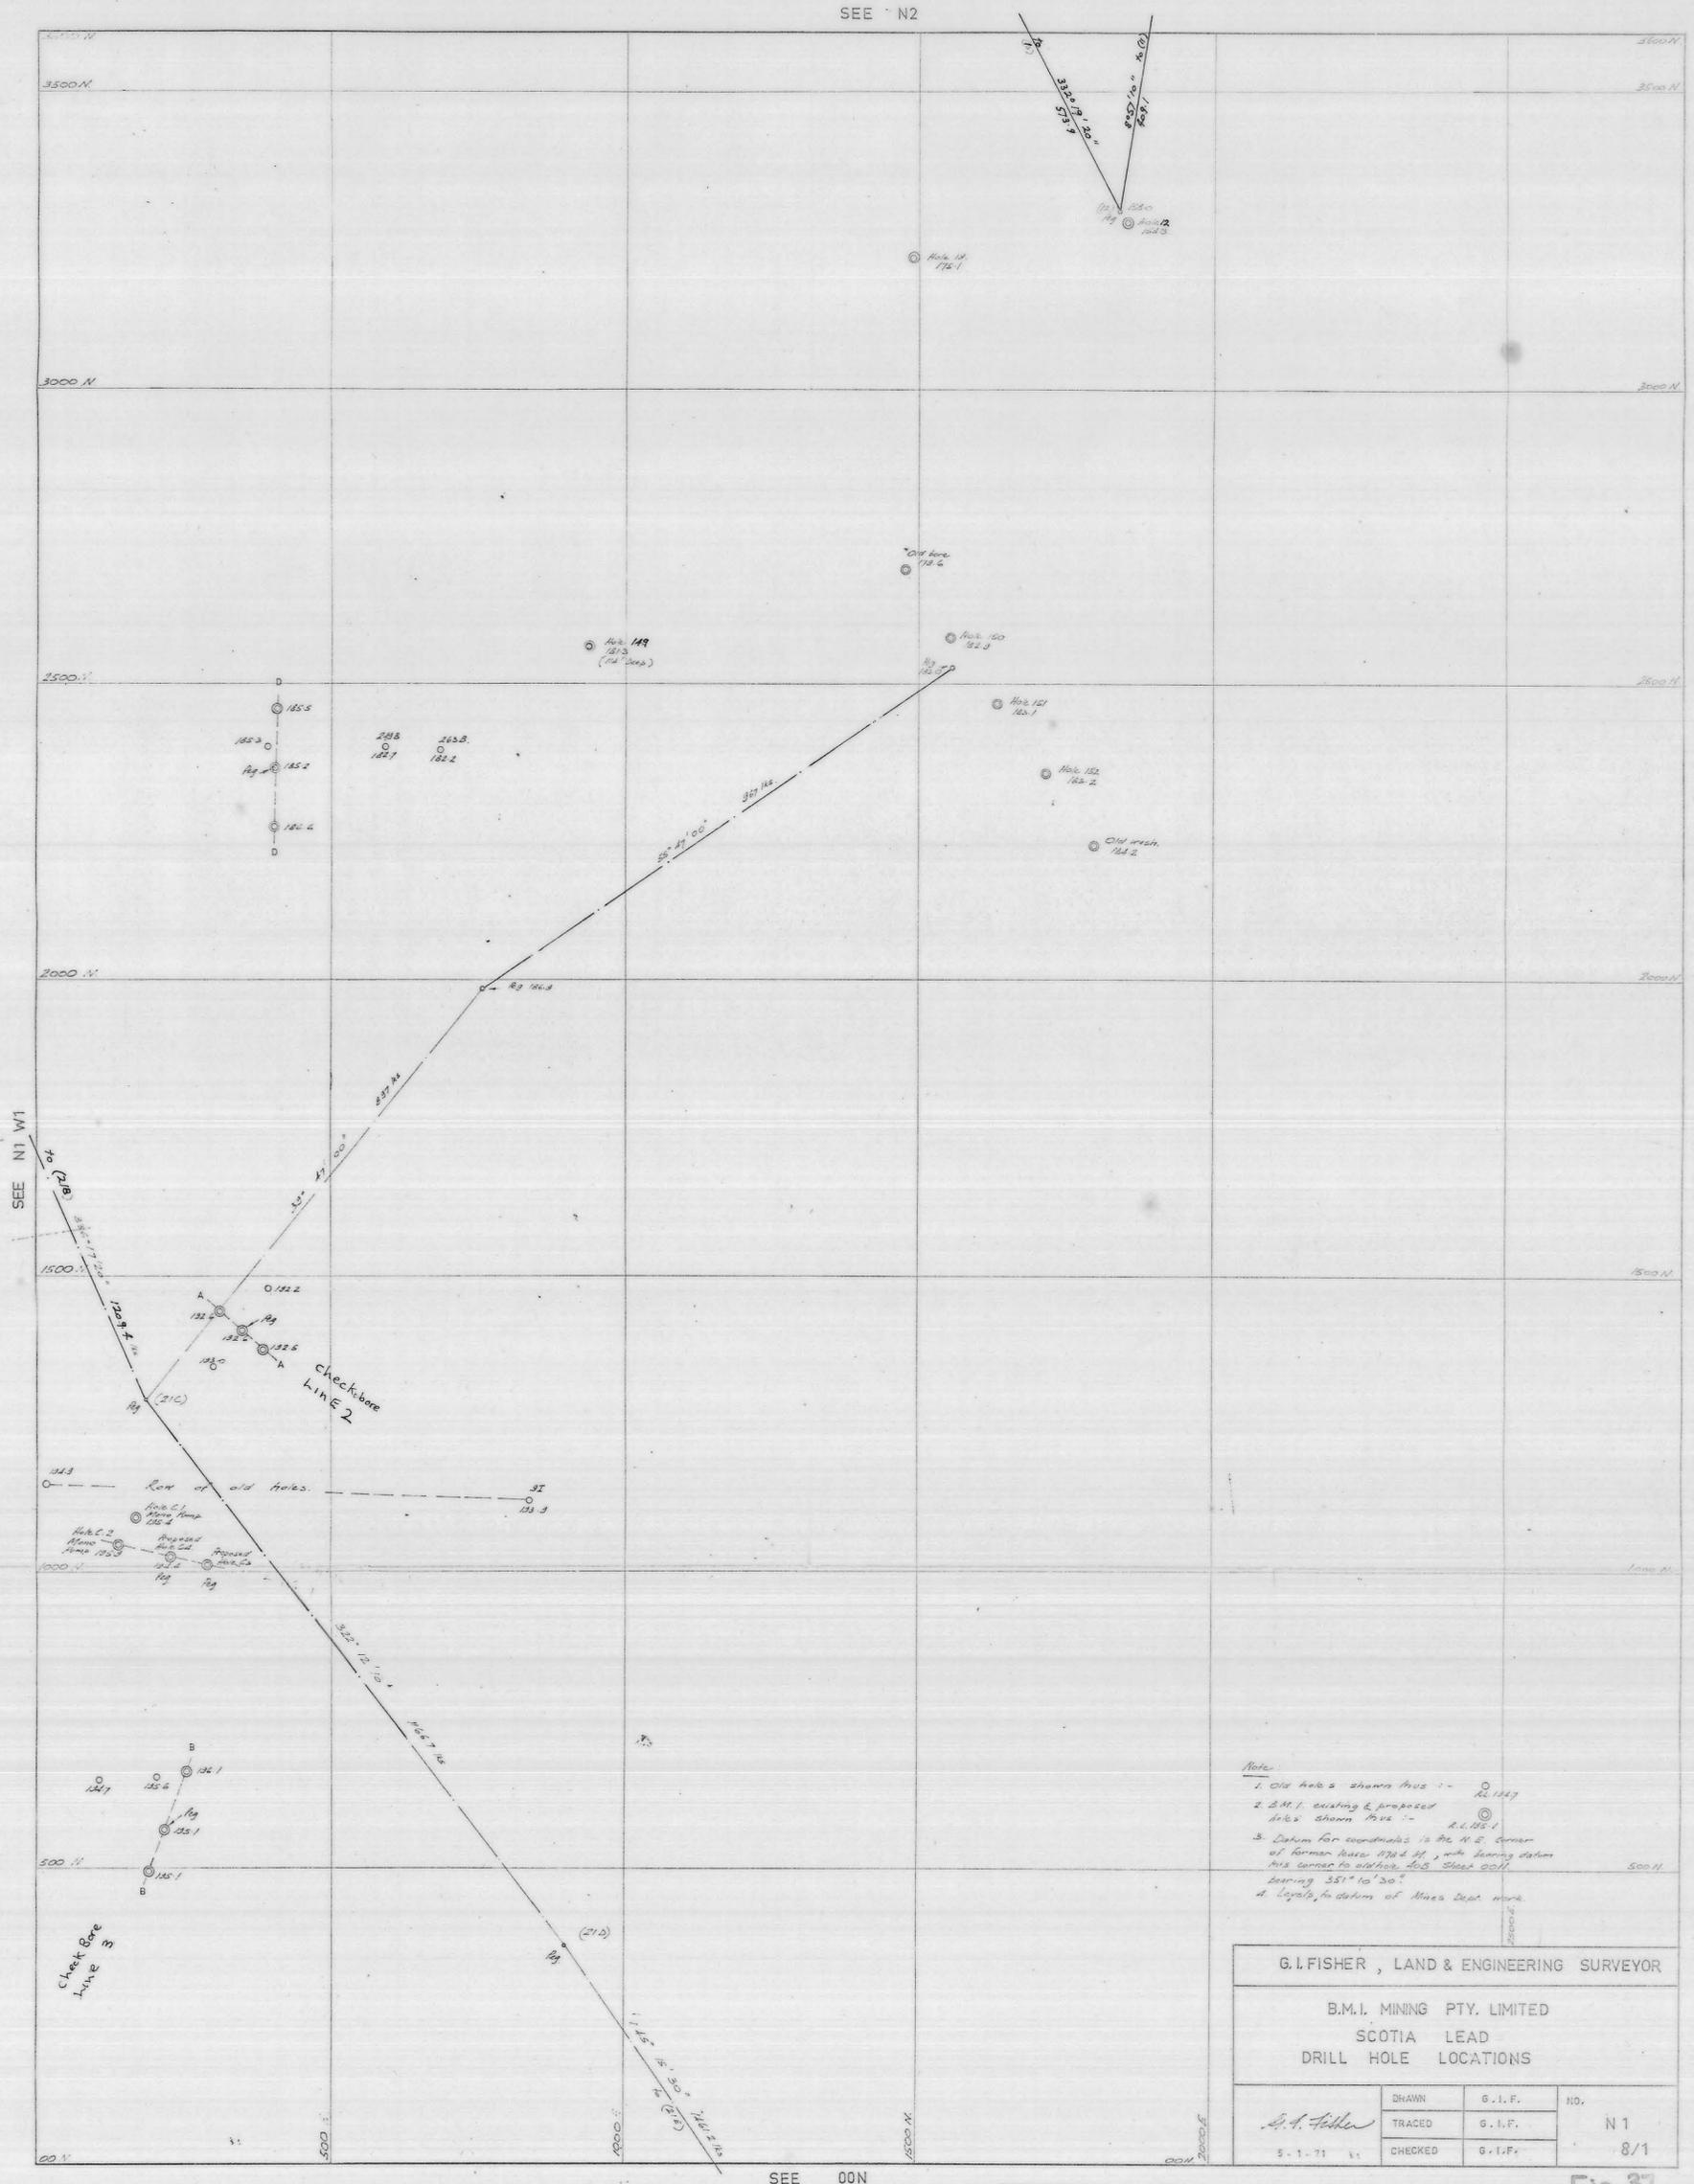

Note:  
 1. Old holes shown thus :- R. 1527  
 2. B.M. existing & proposed holes shown thus :- R. 1551  
 3. Datum for coordinates is the N.E. corner of former block 170 & 171, with bearing datum this corner to station 205 Steel 0011 bearing 351° 10' 30\"/>

G.I. FISHER, LAND & ENGINEERING SURVEYOR			
B.M.I. MINING PTY. LIMITED			
SCOTIA LEAD			
DRILL HOLE LOCATIONS			
<i>G.I. Fisher</i>	DRAWN	G.I.F.	NO. N1
	TRACED	G.I.F.	
	CHECKED	G.I.F.	
5-1-71			8/1

5 cm

0401-068