


0401-070

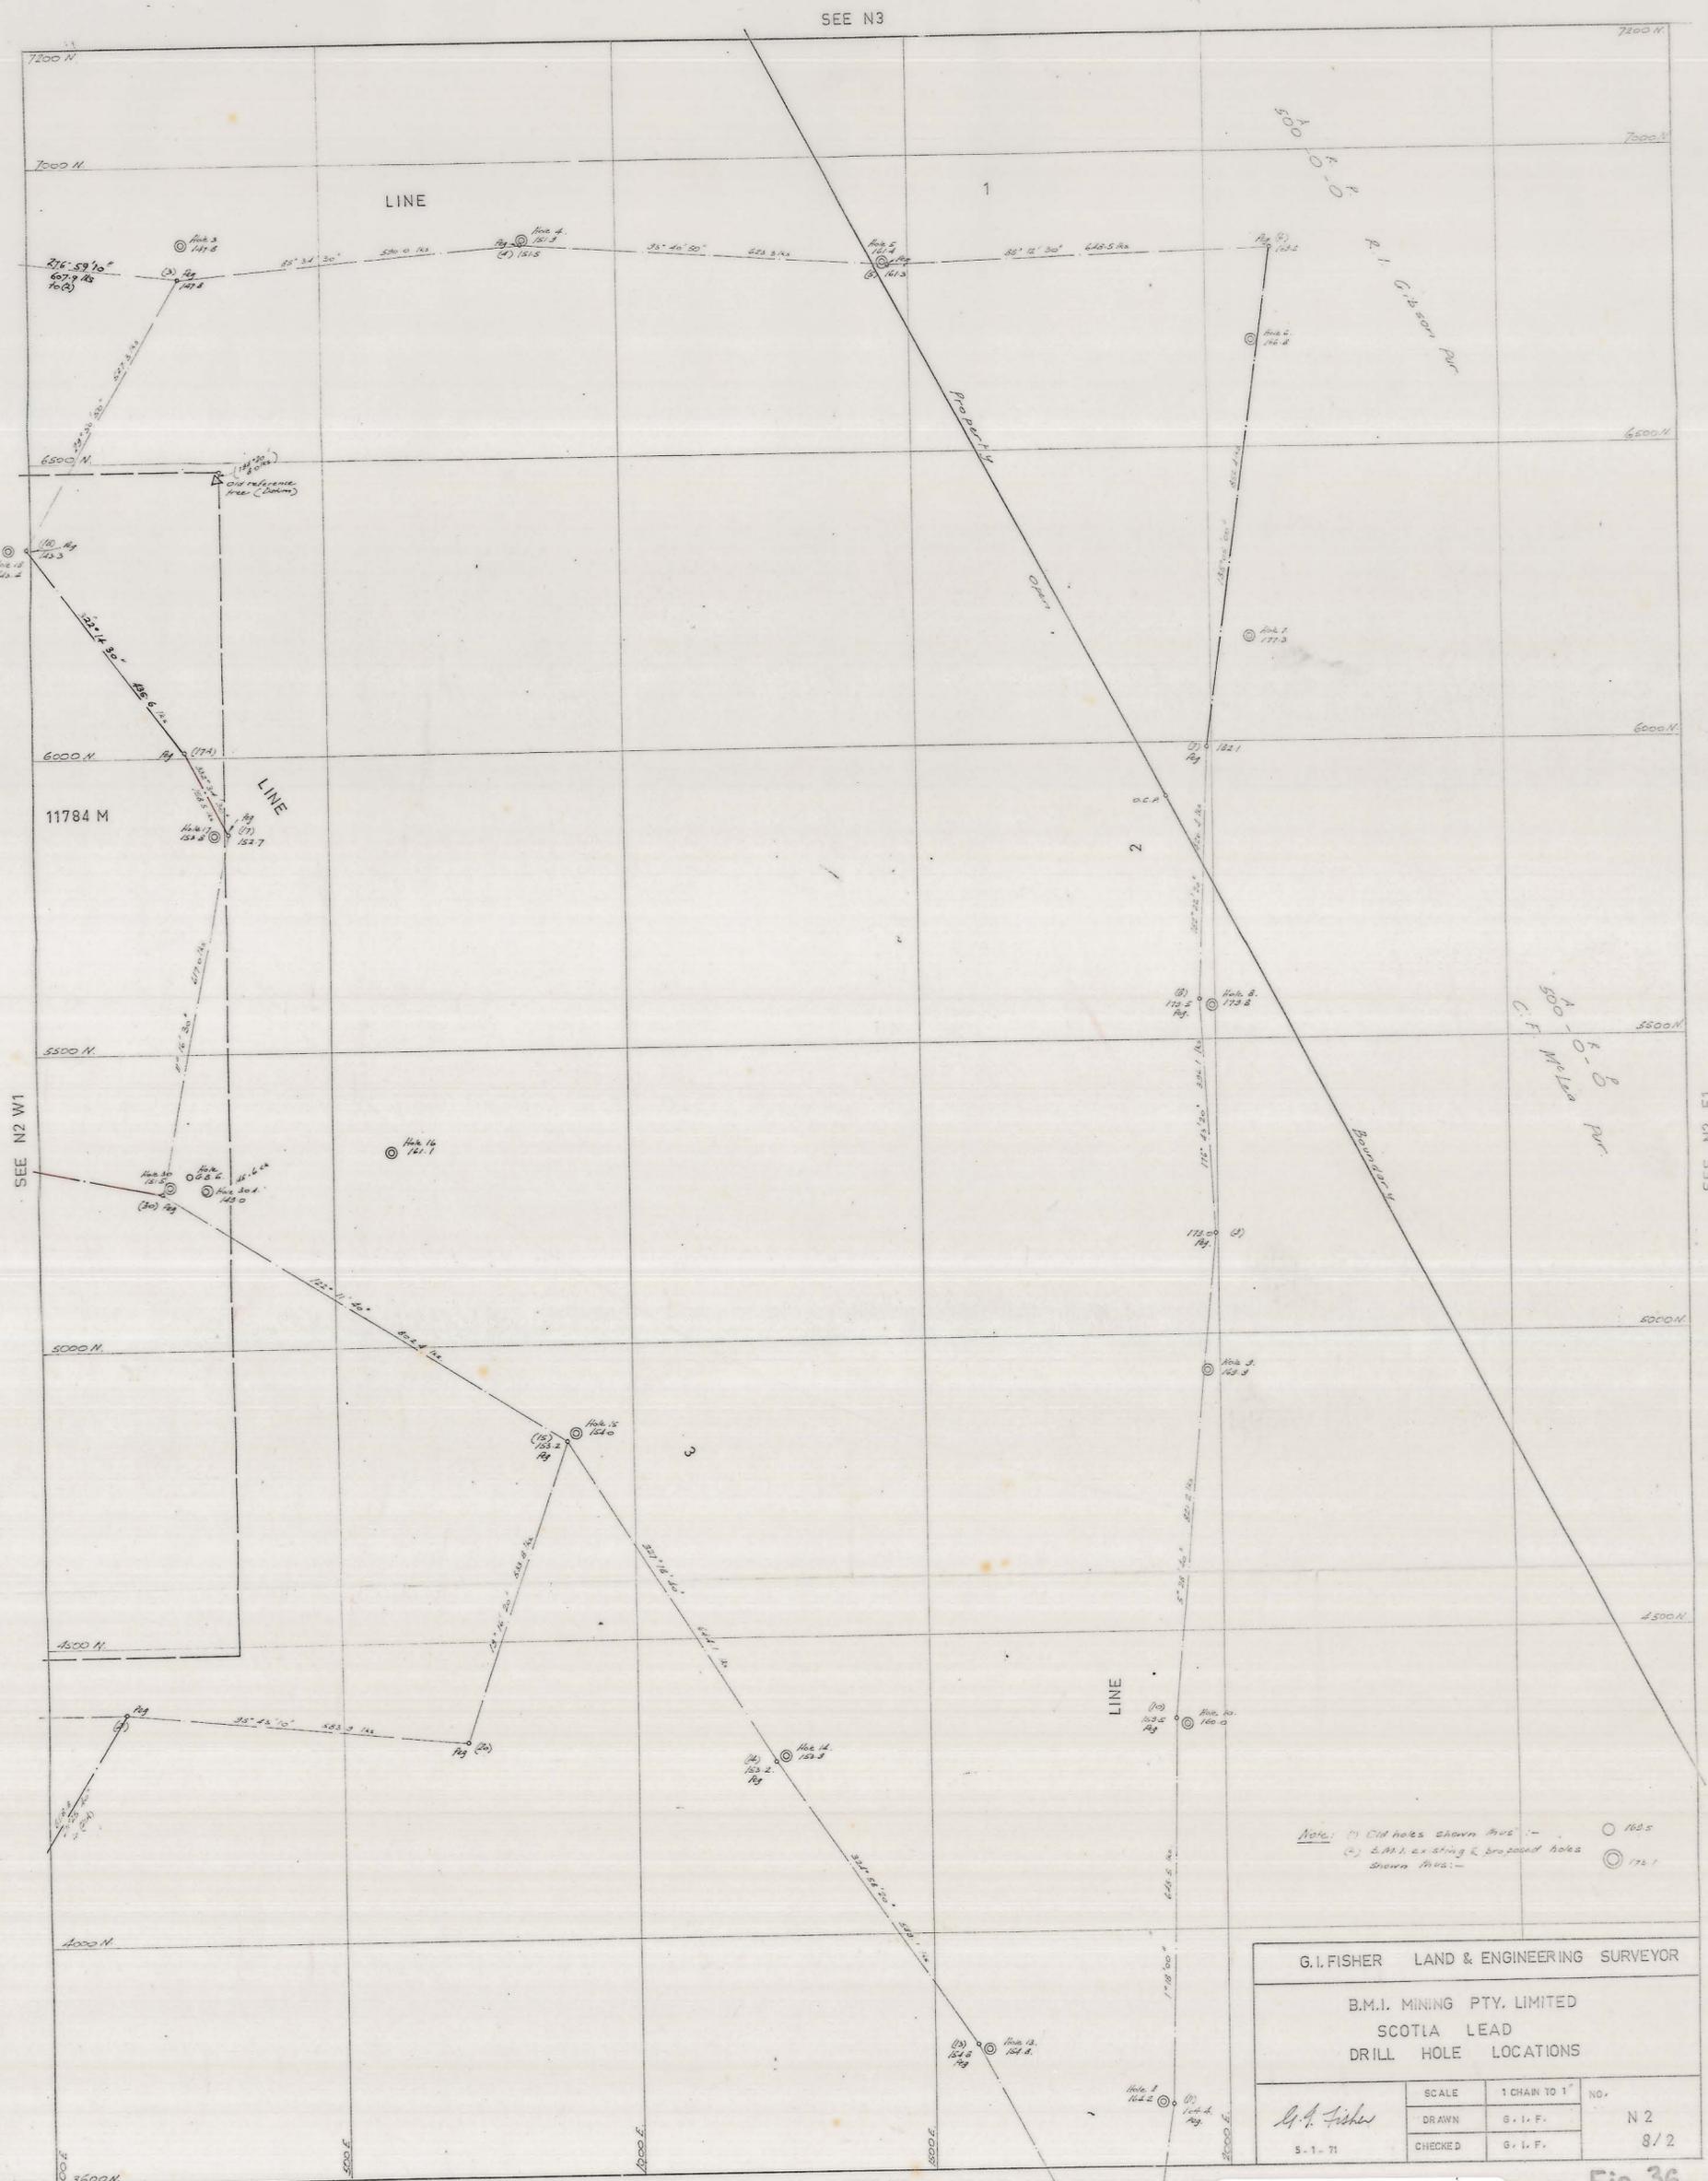

G.I. FISHER LAND & ENGINEERING SURVEYOR

B.M.I. MINING PTY. LIMITED
SCOTIA LEAD
DRILL HOLE LOCATIONS

SCALE 1 CHAIN TO 1"
DRAWN G. I. F.
CHECKED G. I. F.

NO. N2
8/2

5-1-71

5 cm

0401-070

Fig 36