


5 cm
0401-072

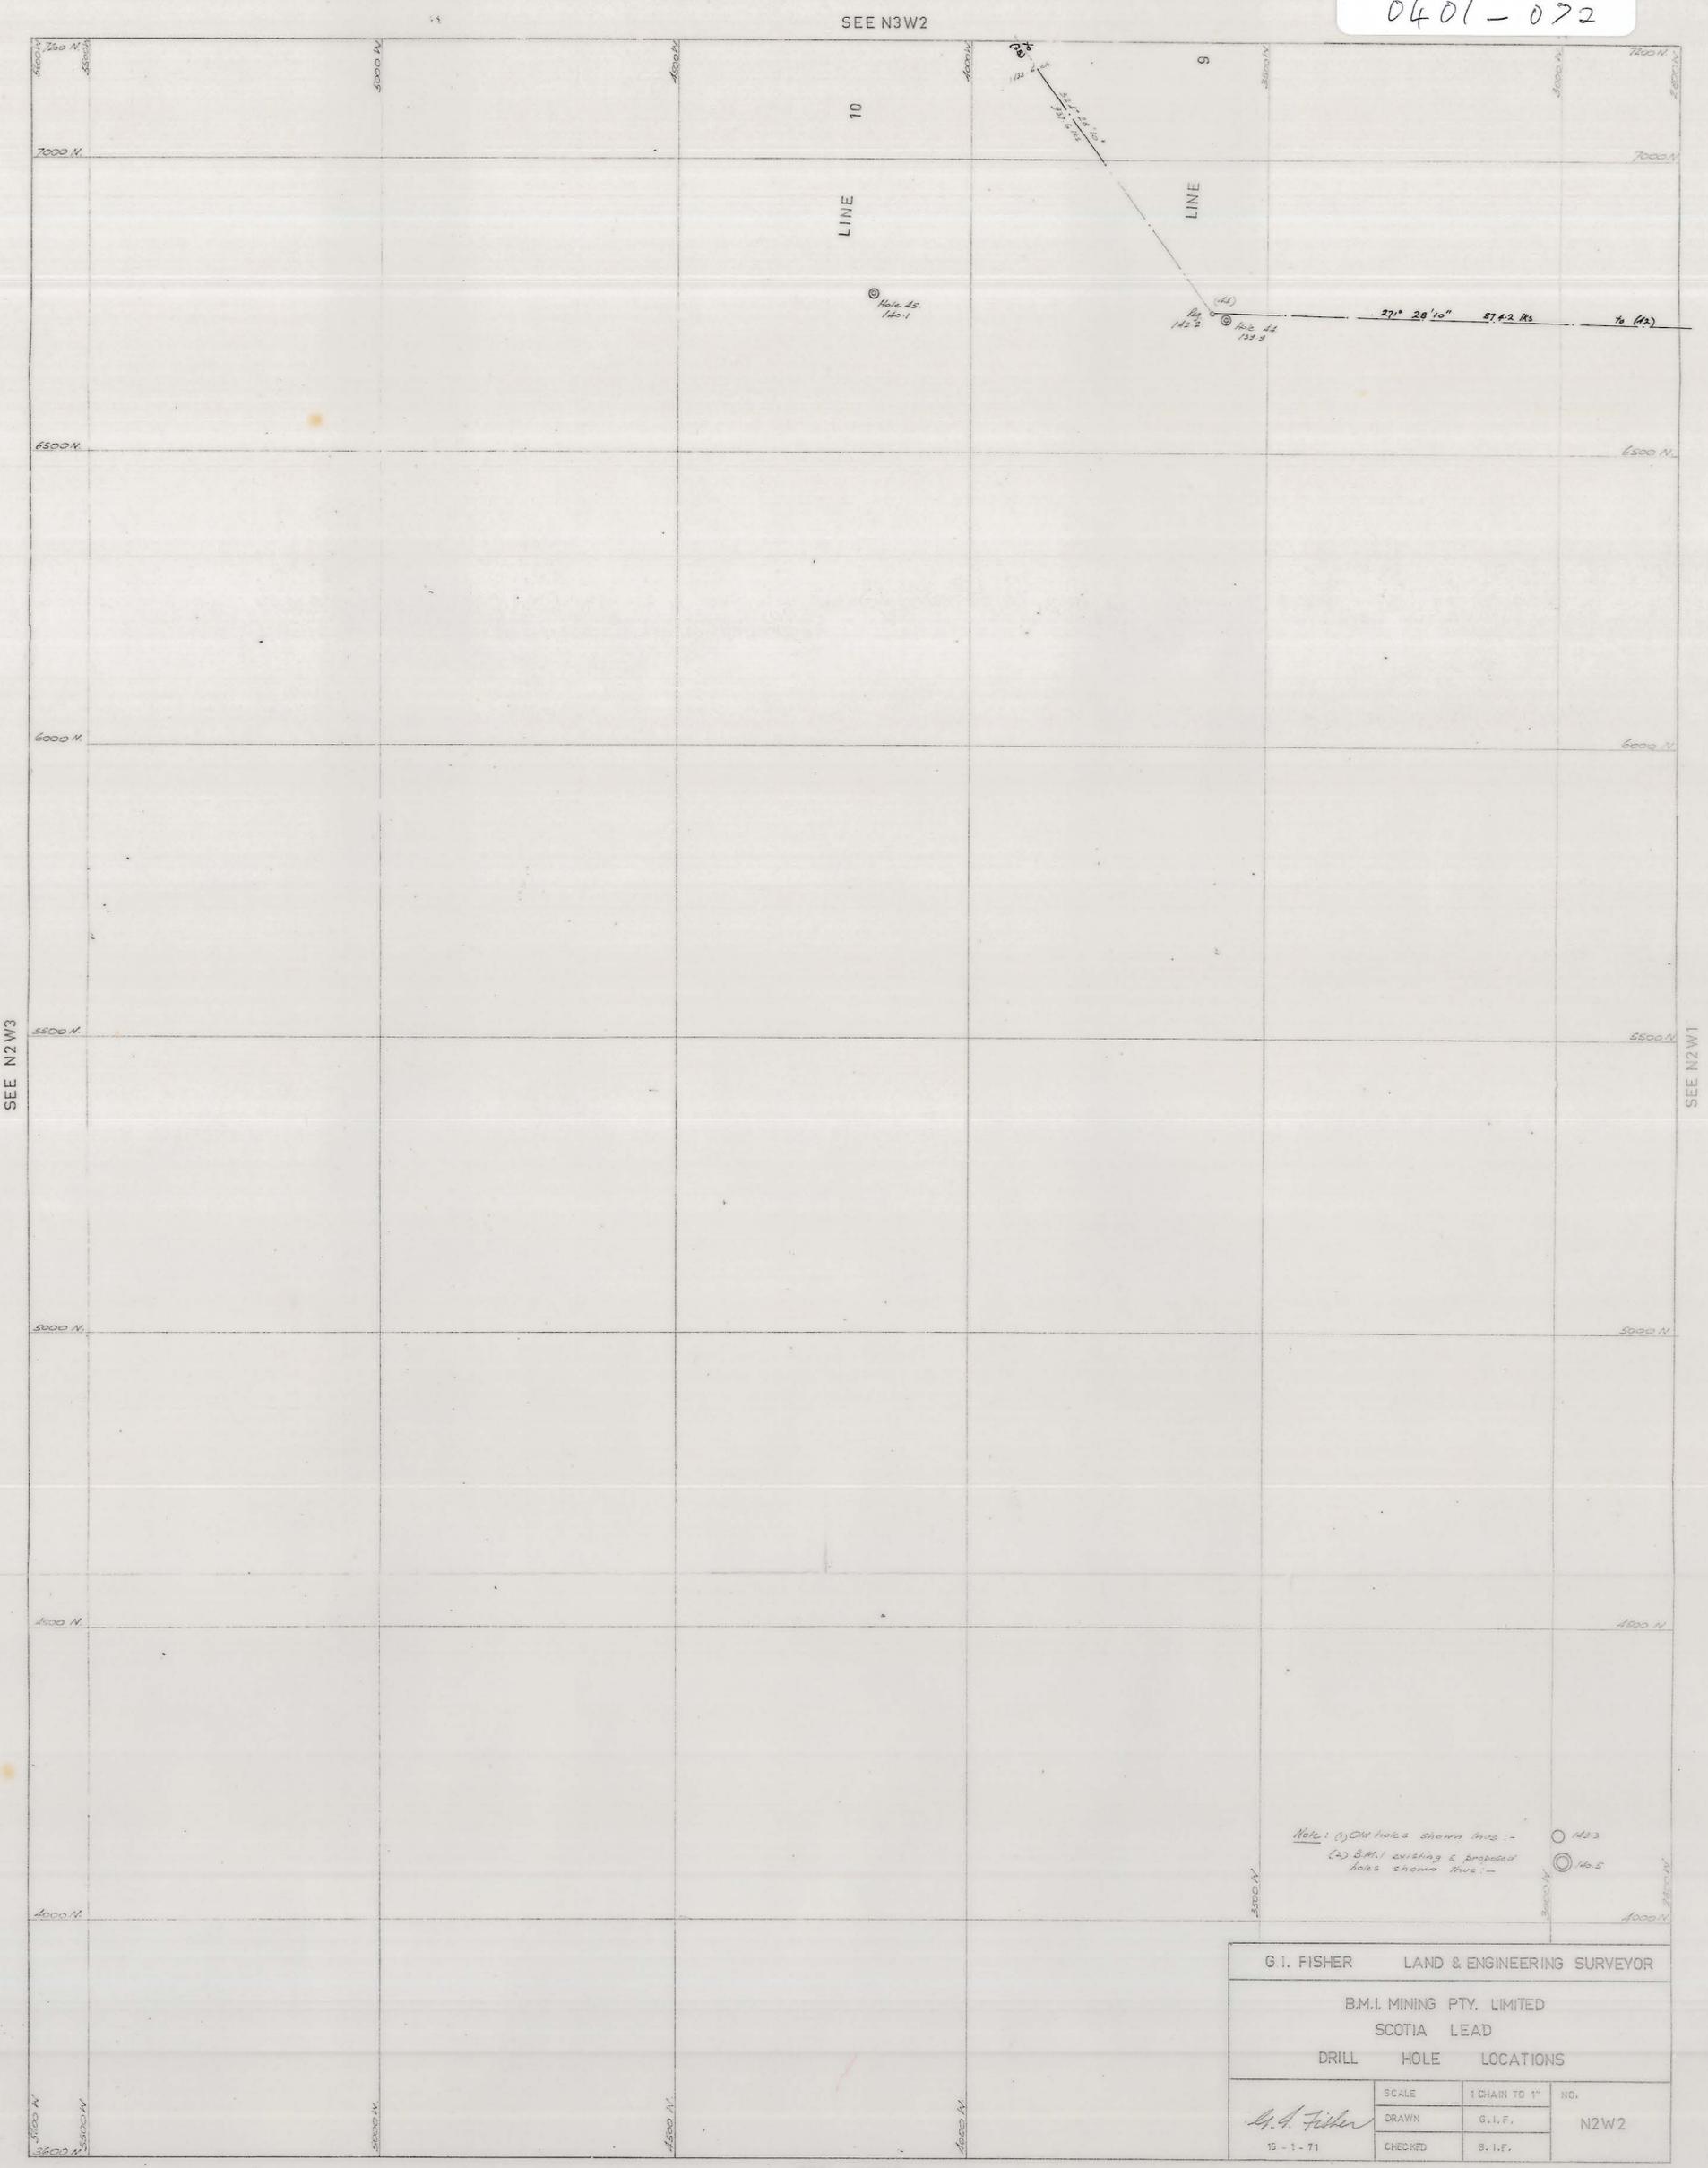

Note: (1) Old holes shown thus: ○ 143
 (2) B.M. existing & proposed holes shown thus: ⊙ 145

G. I. FISHER LAND & ENGINEERING SURVEYOR		
B.M.I. MINING PTY. LIMITED		
SCOTIA LEAD		
DRILL HOLE LOCATIONS		
G.I. Fisher 15-1-71	SCALE	1 CHAIN TO 1" NO.
	DRAWN	G. I. F.
	CHECKED	G. I. F.
		N2W2