


0401-073

5 cm
0401-073

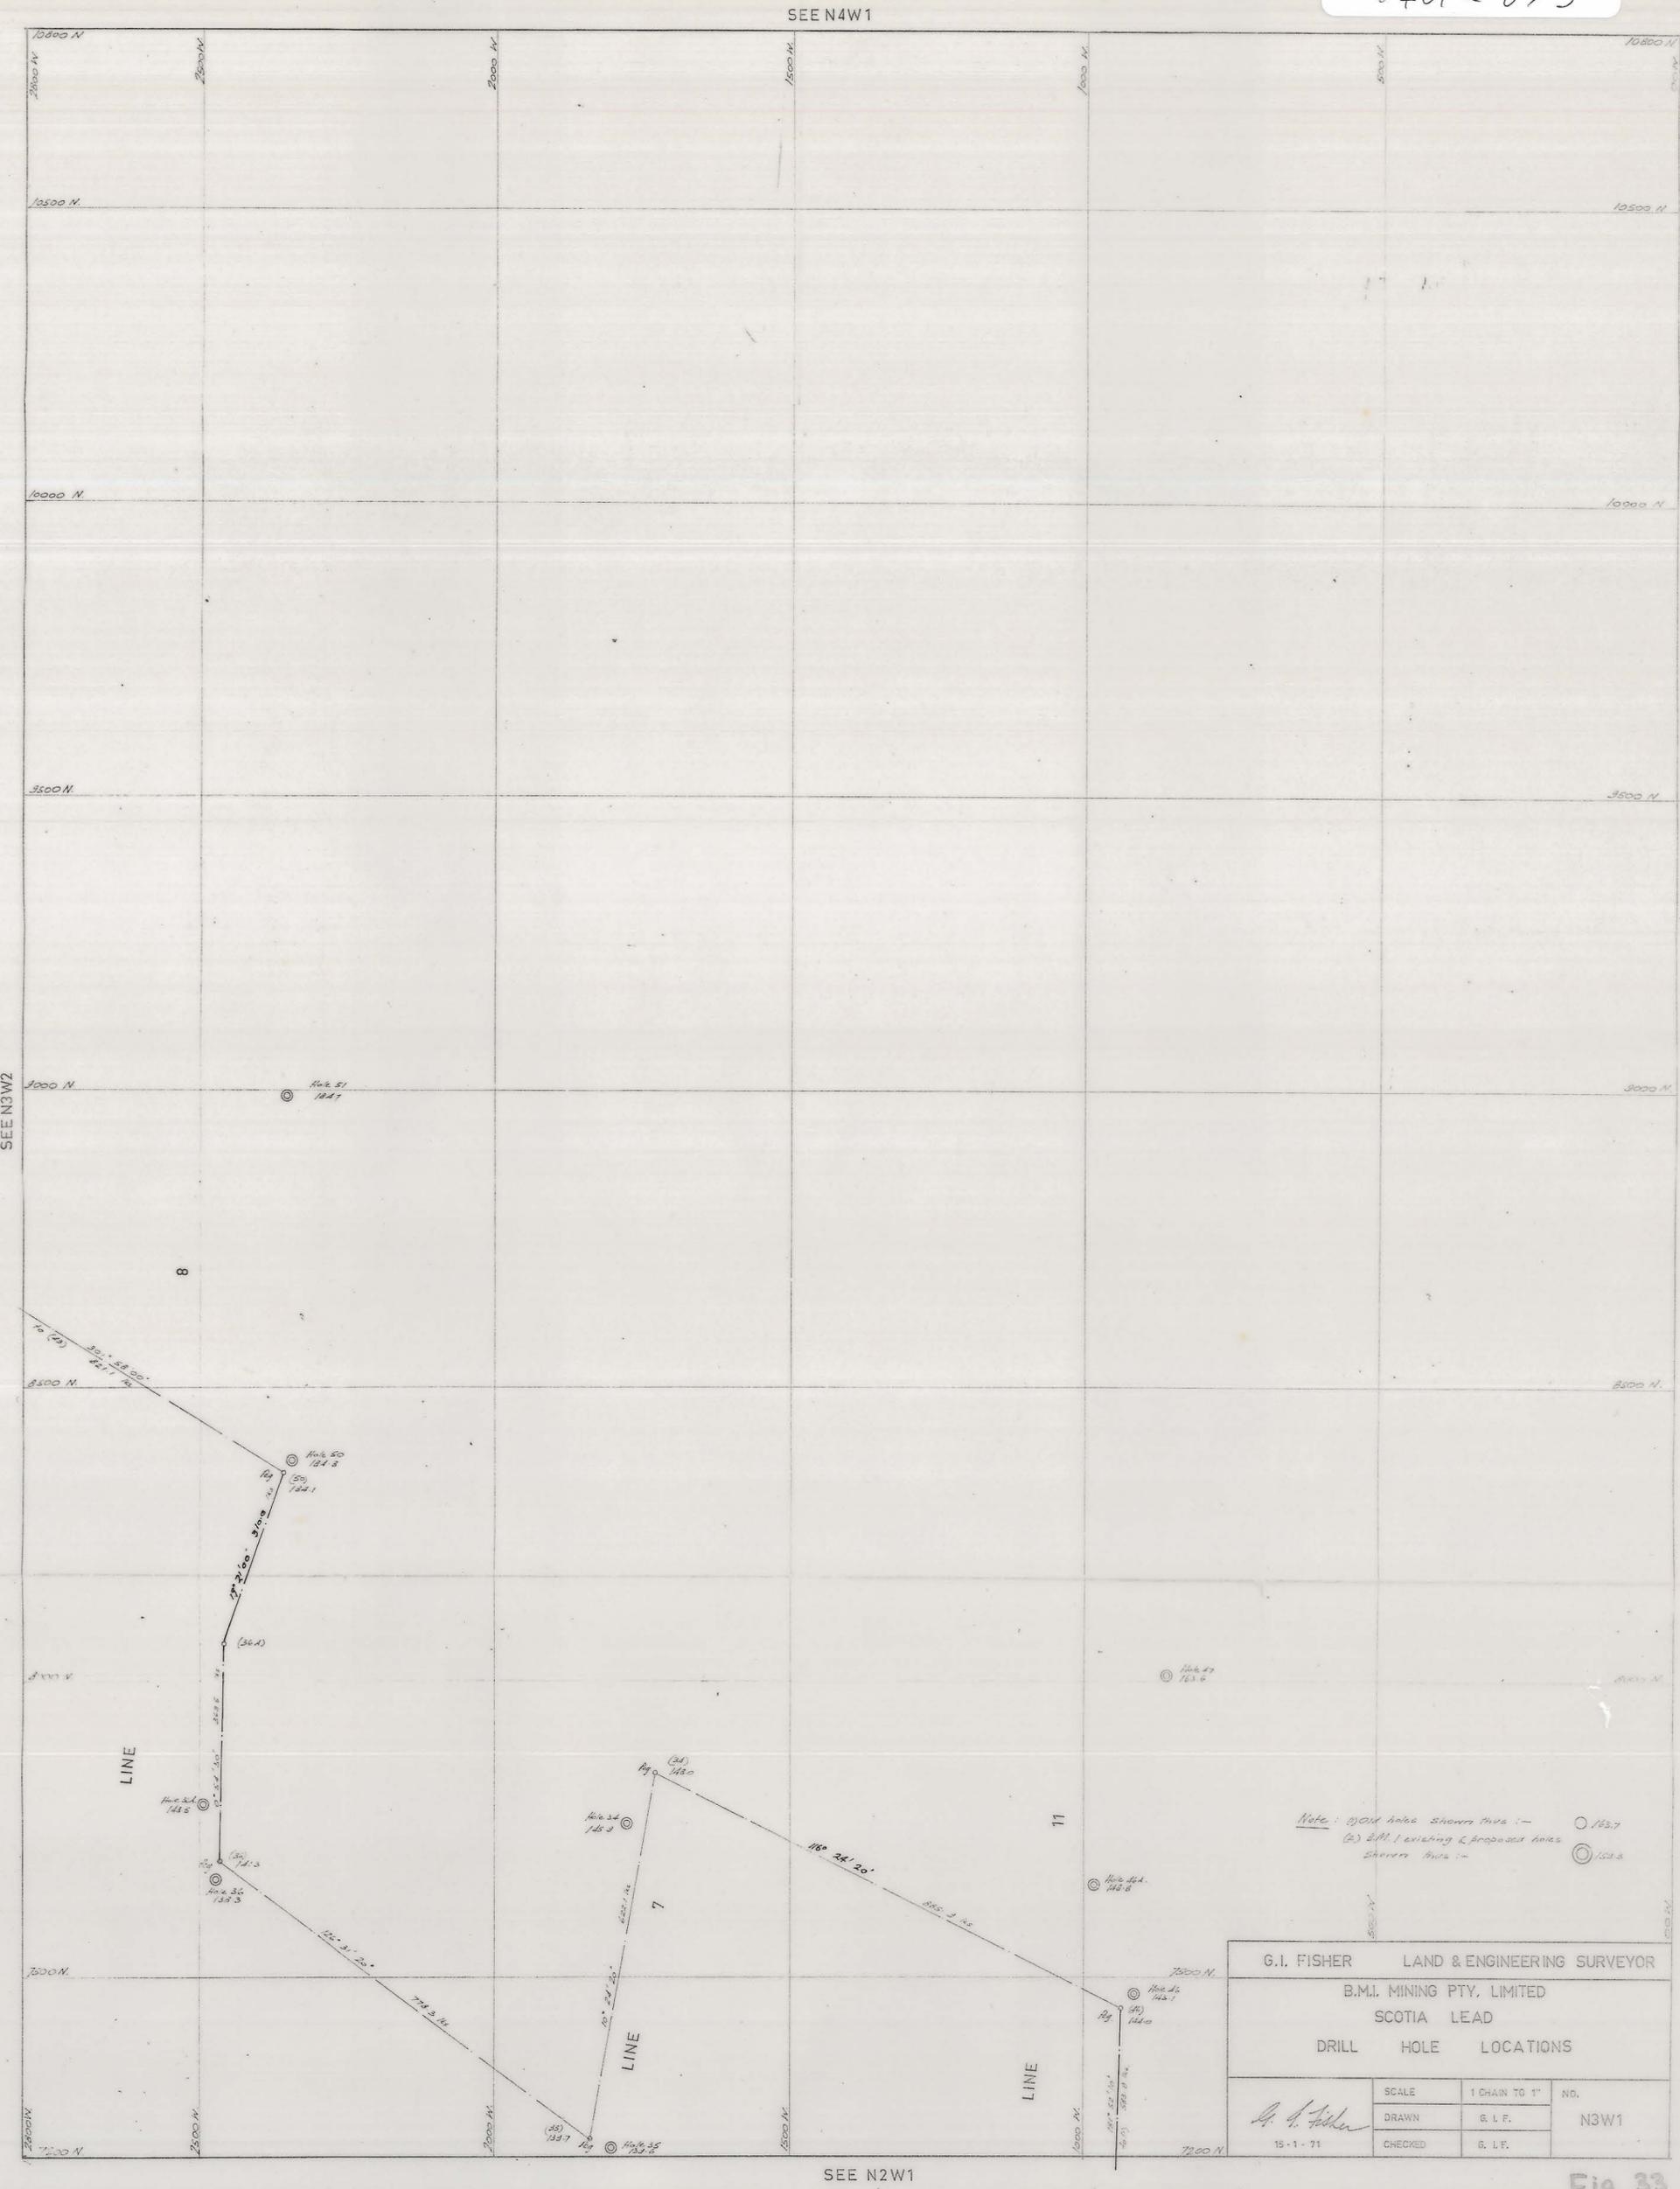

Note: (A) Old holes shown thus: ○
 (B) Old existing & proposed holes shown thus: ⊙

G.I. FISHER LAND & ENGINEERING SURVEYOR
 B.M.I. MINING PTY. LIMITED
 SCOTIA LEAD
 DRILL HOLE LOCATIONS

SCALE	1 CHAIN TO 1"	NO.
DRAWN	G. I. F.	N3W1
CHECKED	G. I. F.	

15-1-71