


0401-076

561-25

GLADSTONE
Boring by - Groves

Scale 8 inches to one mile.

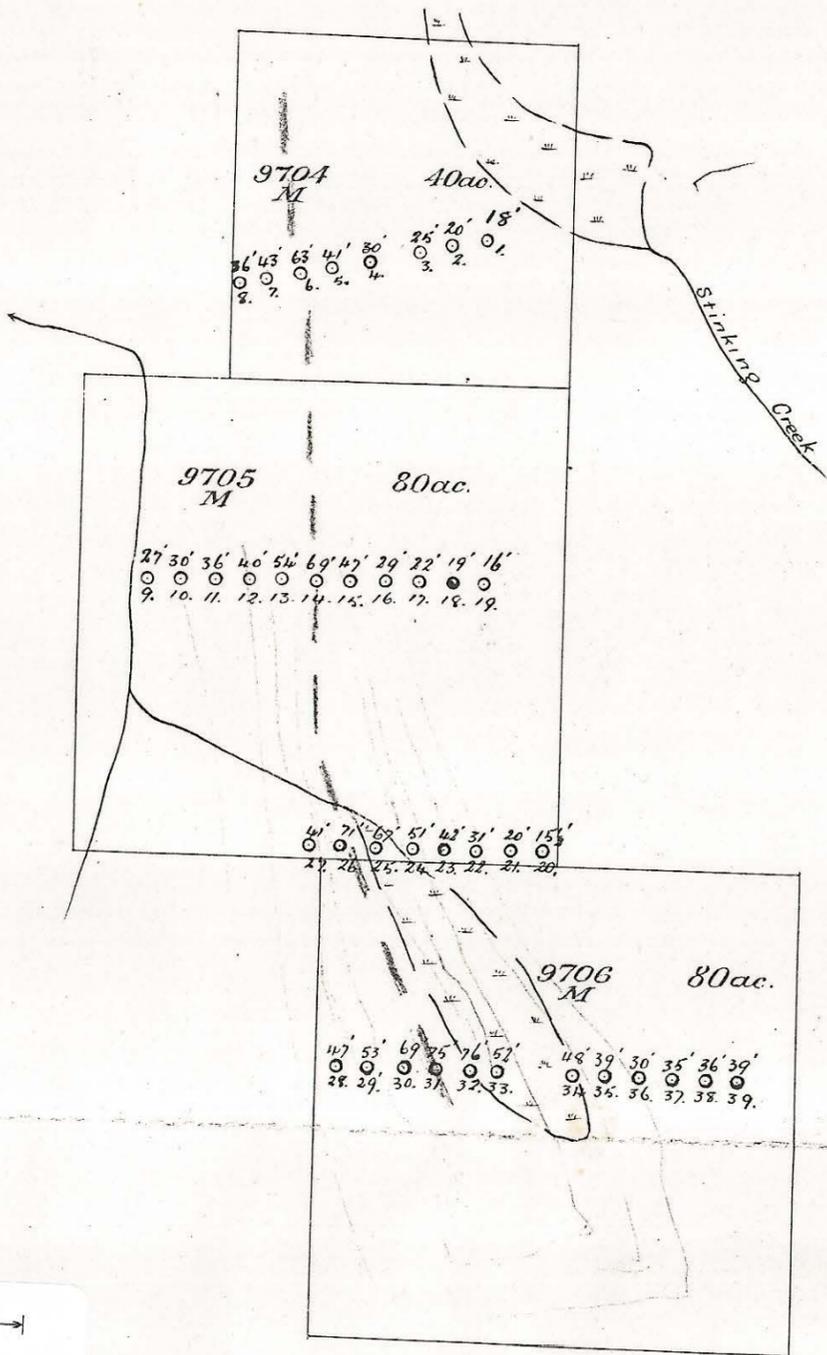

561

5 cm
0401-076

Value, trace only. Soft and hard slate bottom
It is very doubtful if these boxes were sunk
to rock bottom.