


BMI 1973

PT 2

0401-077

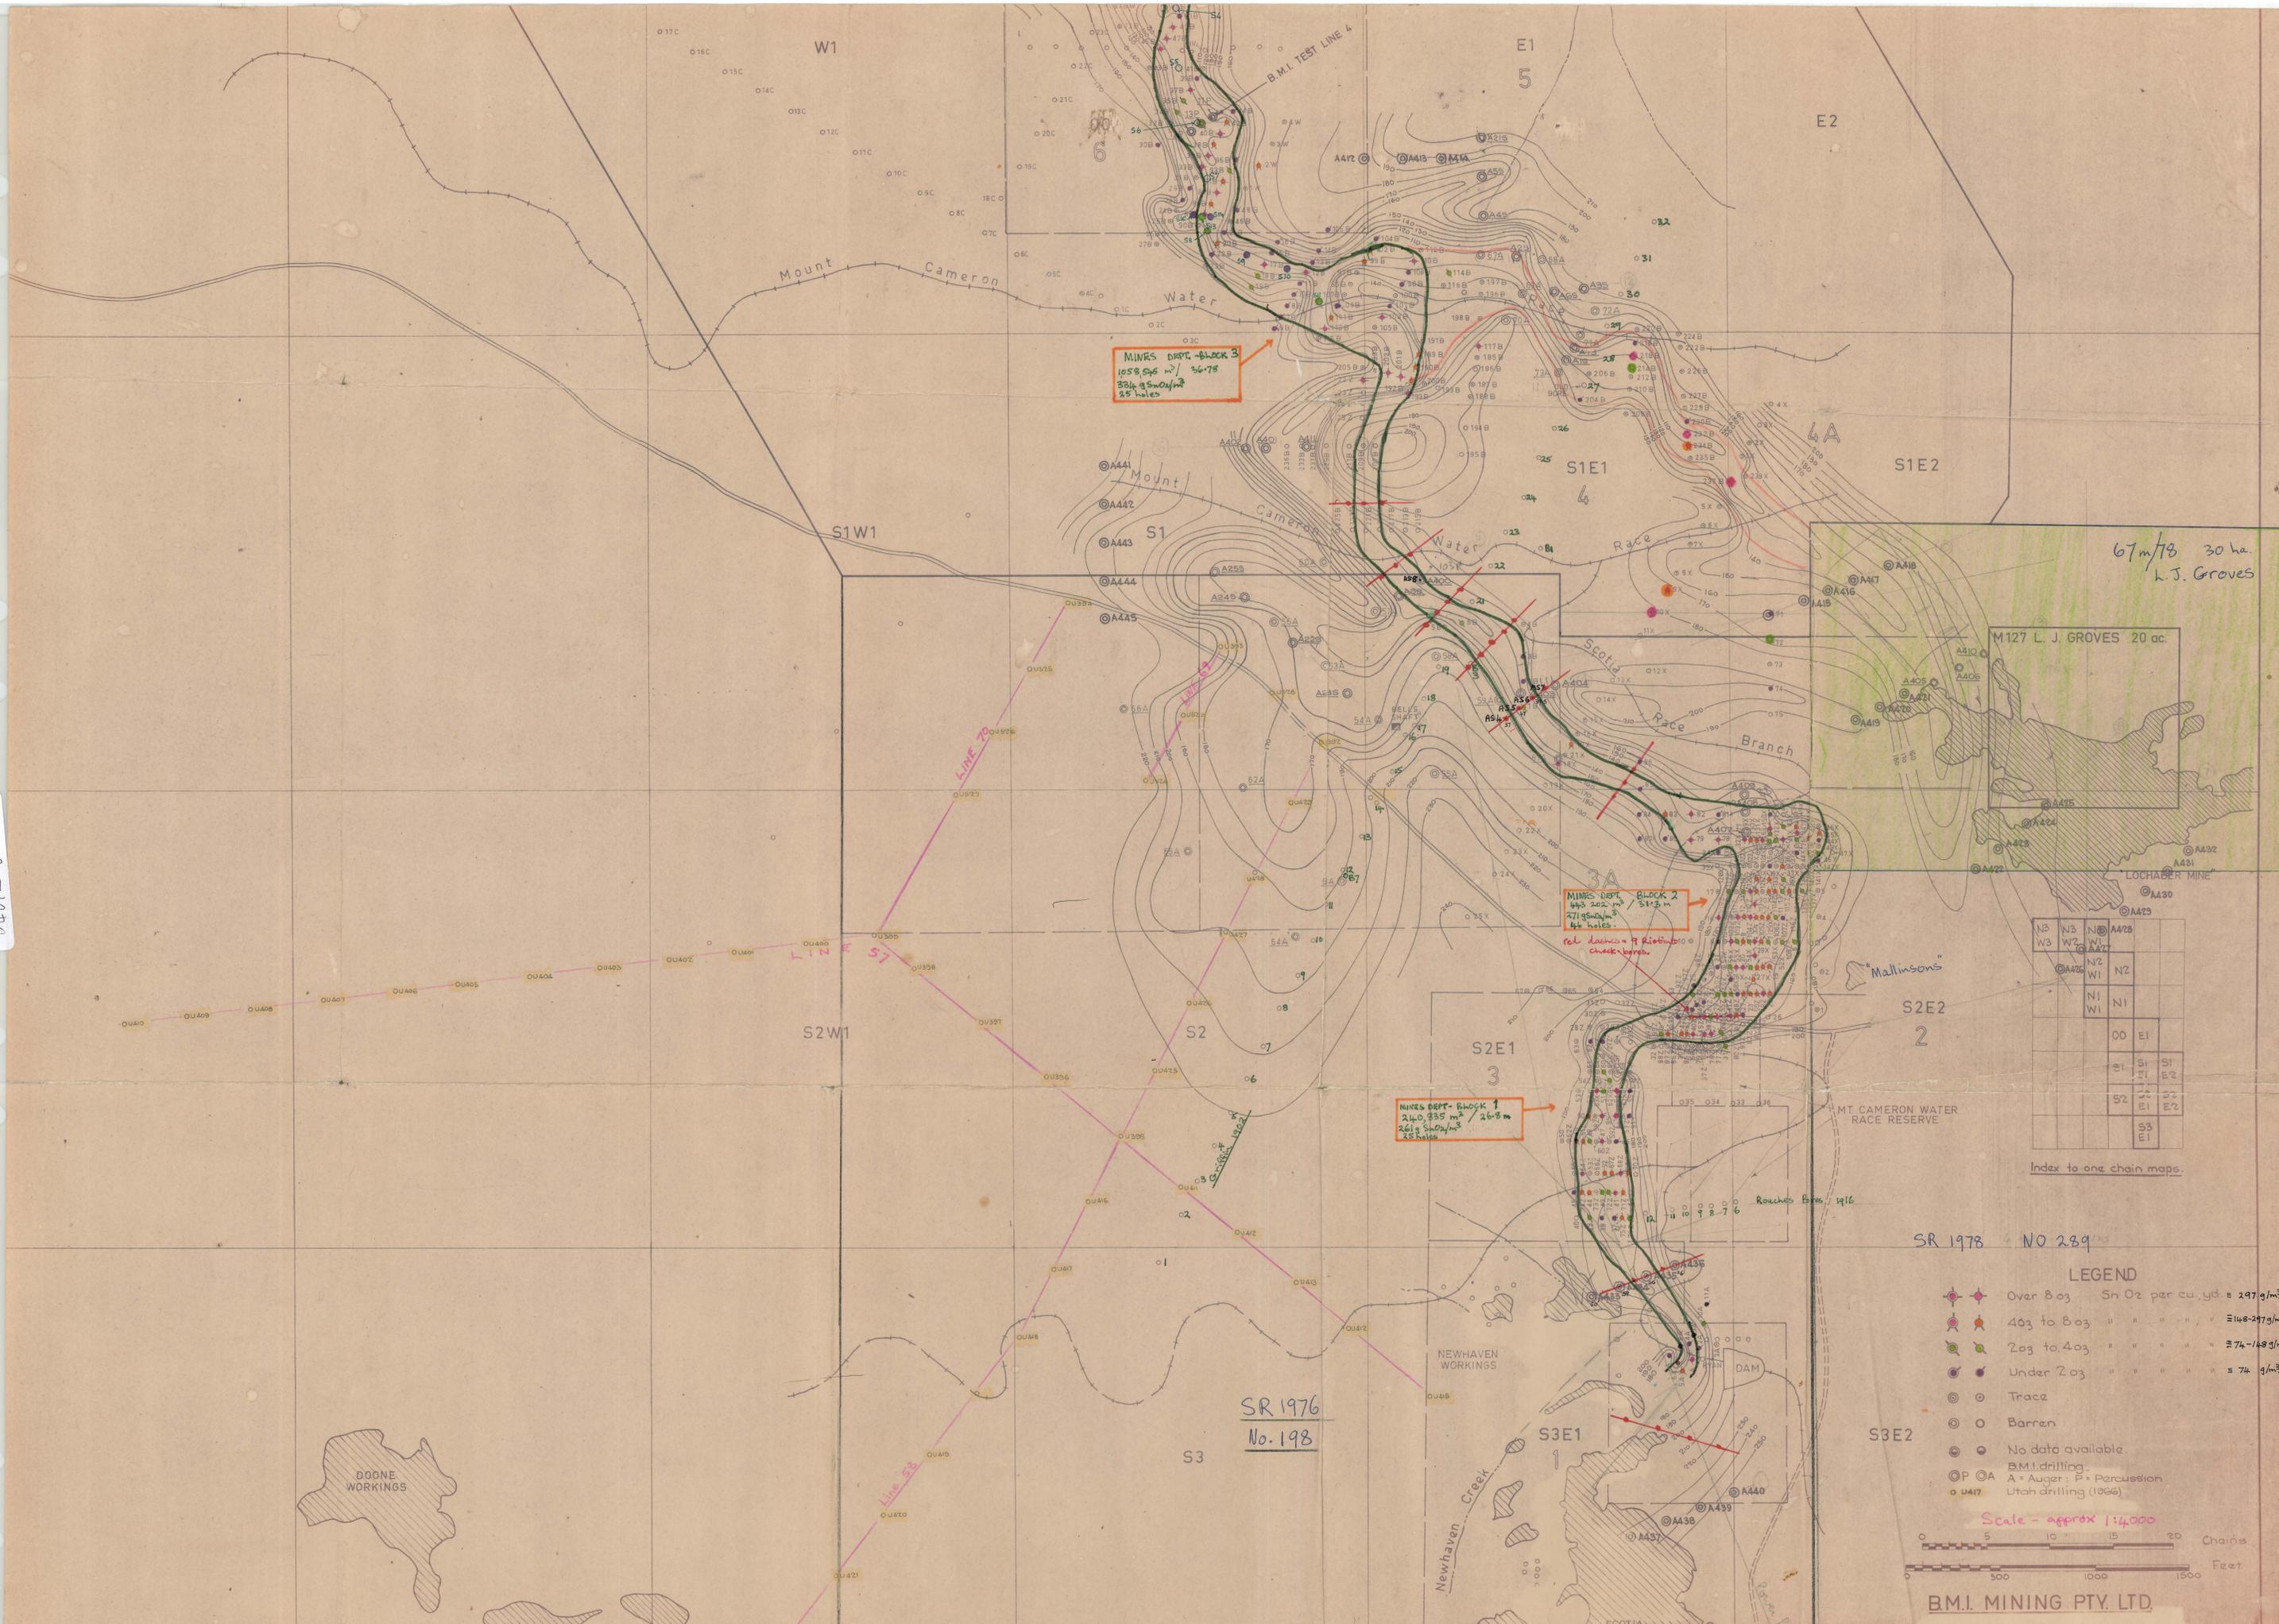

MINES DEPT. BLOCK 3  
 1058.946 m<sup>2</sup> / 26.78 ha  
 334 gsw/ha  
 25 holes

MINES DEPT. BLOCK 2  
 445.202 m<sup>2</sup> / 11.12 m  
 271 gsw/ha  
 42 holes

MINES DEPT. BLOCK 1  
 240.935 m<sup>2</sup> / 26.8 m  
 261 gsw/ha  
 25 holes

67m/78 30 ha.  
 L.J. Groves

M127 L. J. GROVES 20 ac.


N3	N3	N3	A428
W3	W3	W3	A427
	N2	W1	N2
	N1	W1	N1
		00	E1
		S1	S1
		E1	E2
		S2	E1
			E2
		S3	E1

Index to one chain maps.

SR 1976  
 No. 198

SR 1978 NO 239

- LEGEND**
- Over 803 Sn O<sub>2</sub> per cu. yd. = 297 g/m<sup>3</sup>
  - 403 to 803 " " " " = 1148-297 g/m<sup>3</sup>
  - 203 to 403 " " " " = 74-148 g/m<sup>3</sup>
  - Under 203 " " " " = 74 g/m<sup>3</sup>
  - Trace
  - Barren
  - No data available.
  - B.M.I. drilling
  - A = Auger; P = Percussion
  - U417 Utah drilling (1966)

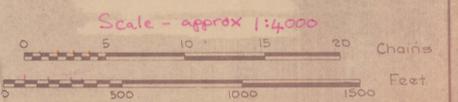

B.M.I. MINING PTY. LTD.