


0401-088

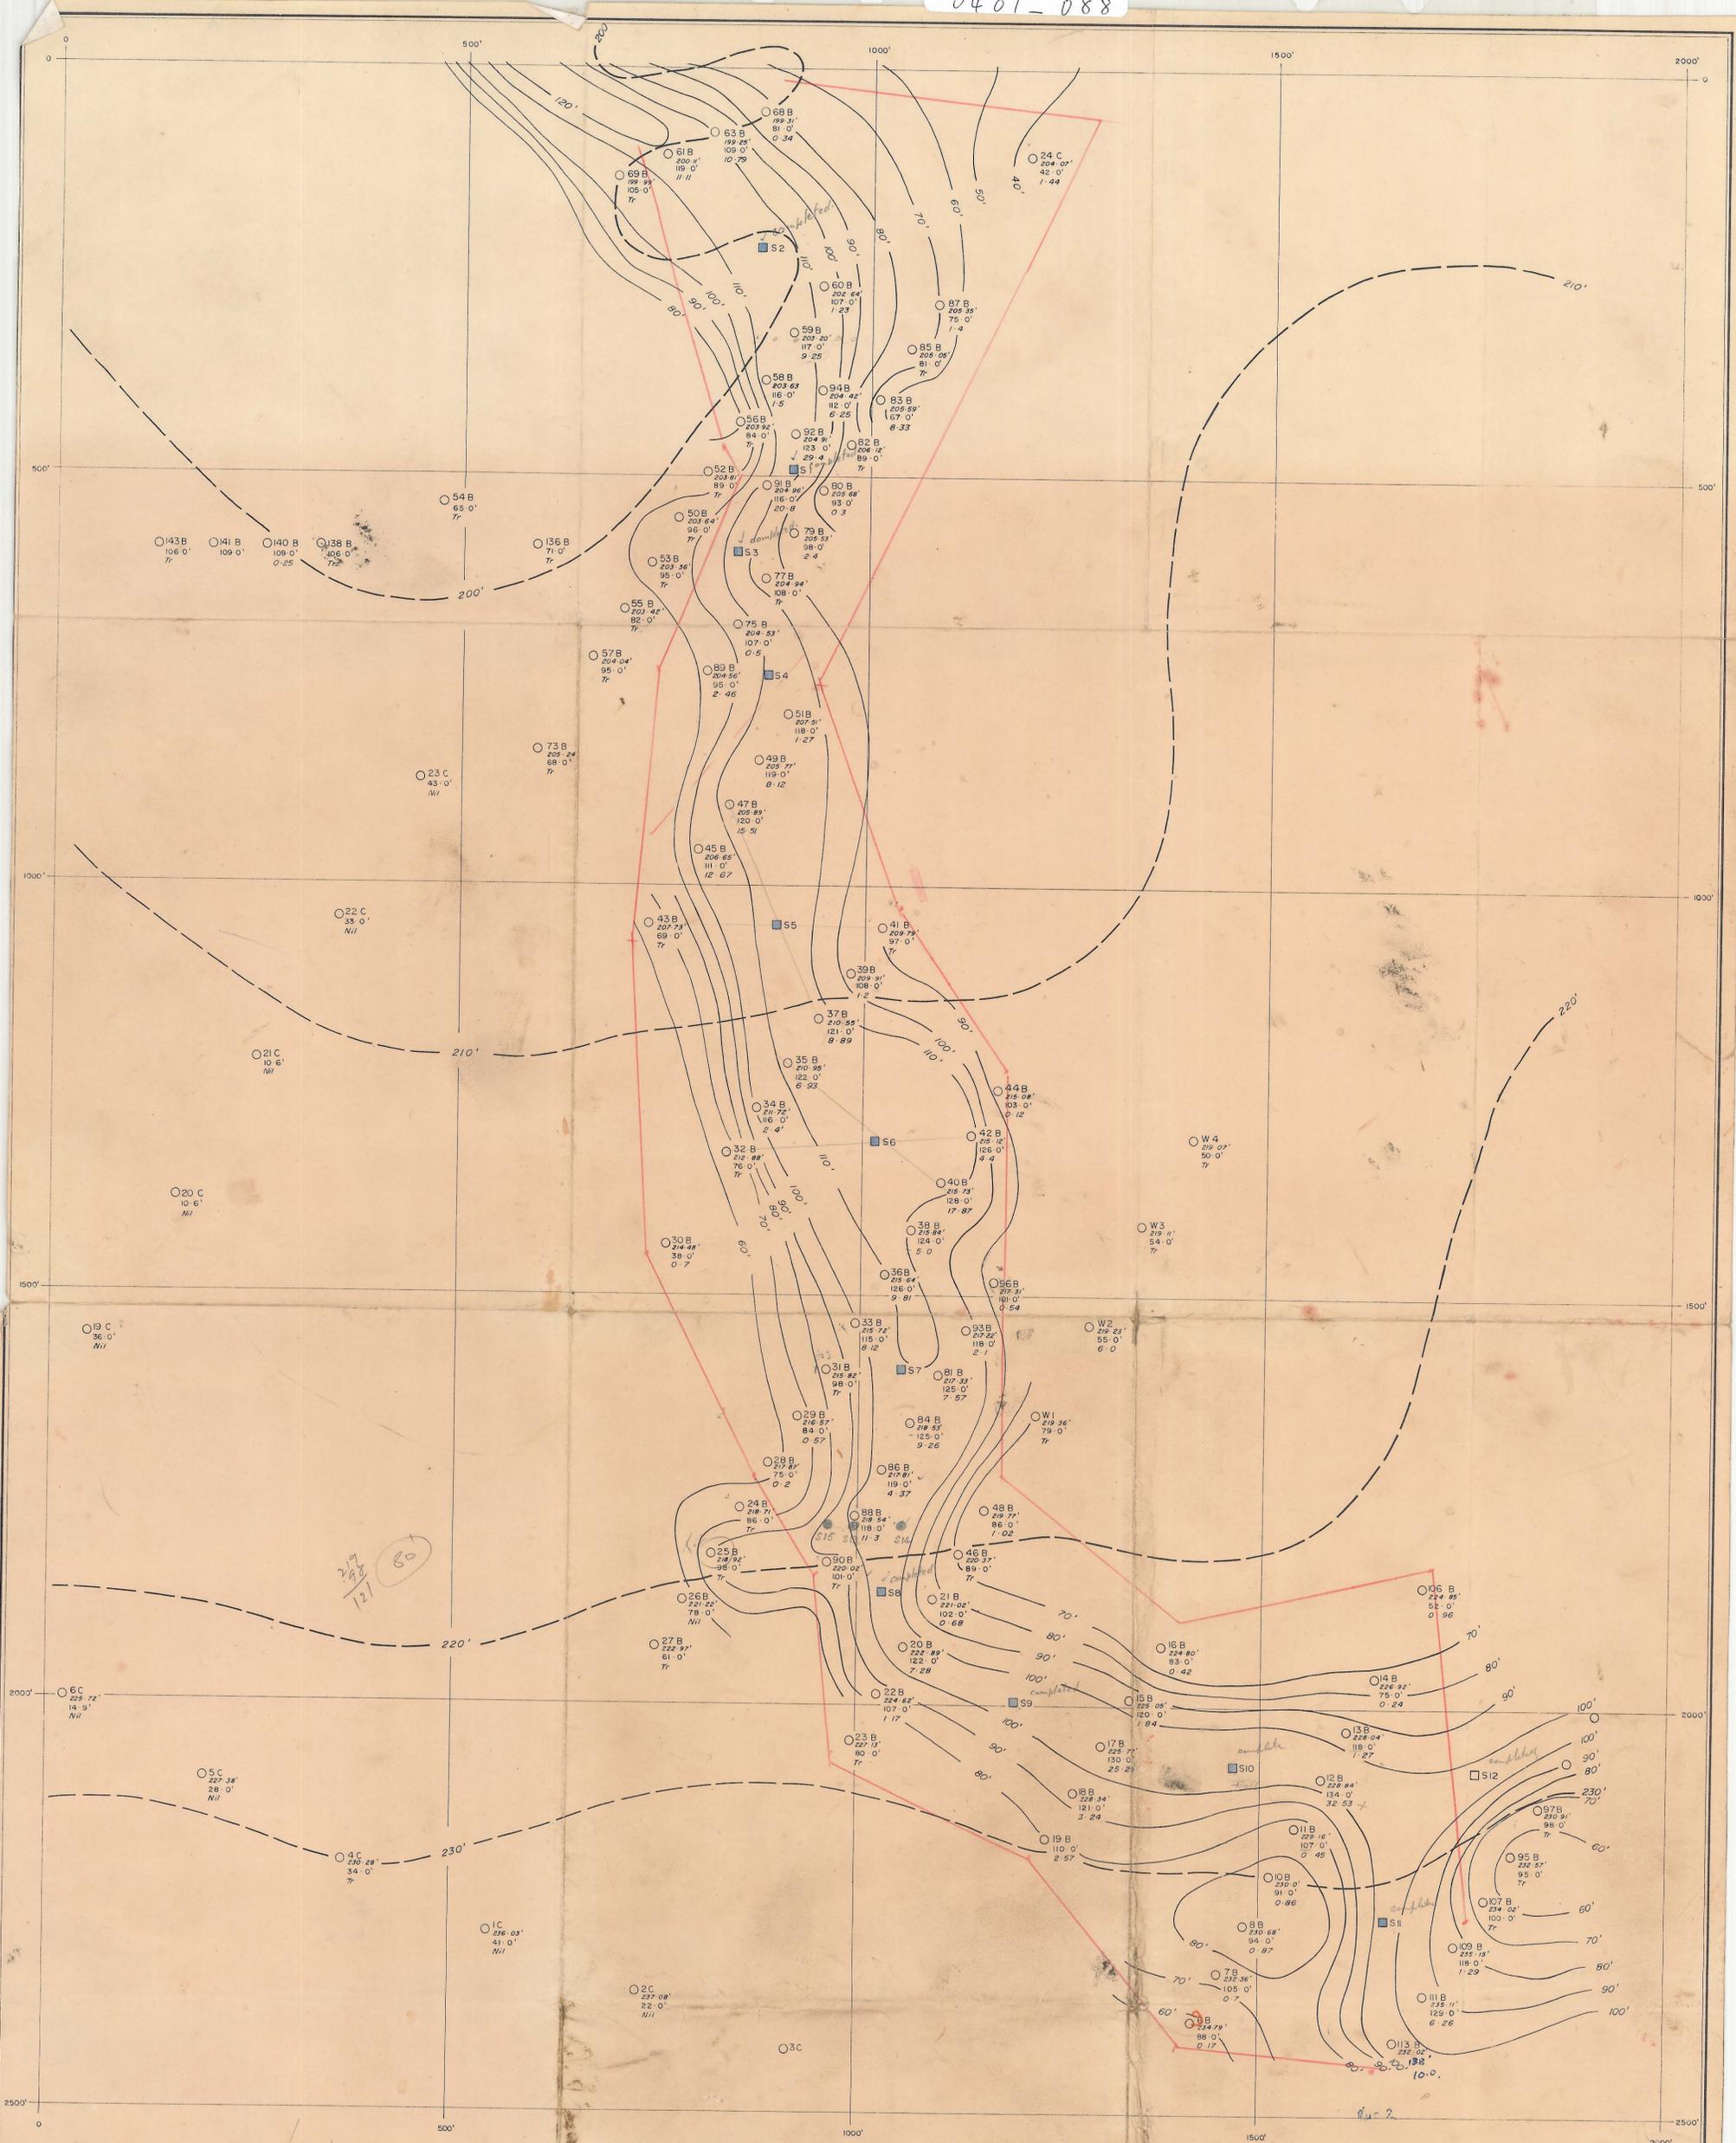

LEGEND

MINES DEPT. HOLE ○ 96 B
 Hole Number
 Relative level
 Depth below collar
 Sn value ozs/cub. yd.

DORSET HOLE ■ S7
 Hole number

— 230' — Surface contour and value

— 70' — Bottom contour and value

STOREYS CREEK TIN MINING N.L.
 DORSET TIN DIVISION

SCOTIA LEAD (BLOCK 3)
 Proposed Drilling Programme

Drafting by GEODRAFTING SERVICES	SCALE 1 Inch = 100 Feet
Drawn: B. L.	REVISION
Date: January, 1965	

5 cm

0401-088