


POINT OF ORIGIN
NORTH WEST PEG OF 9706
M

SEE NI SE CORNER PEG 9705
ASSUMED DATUM 200.00 RED.

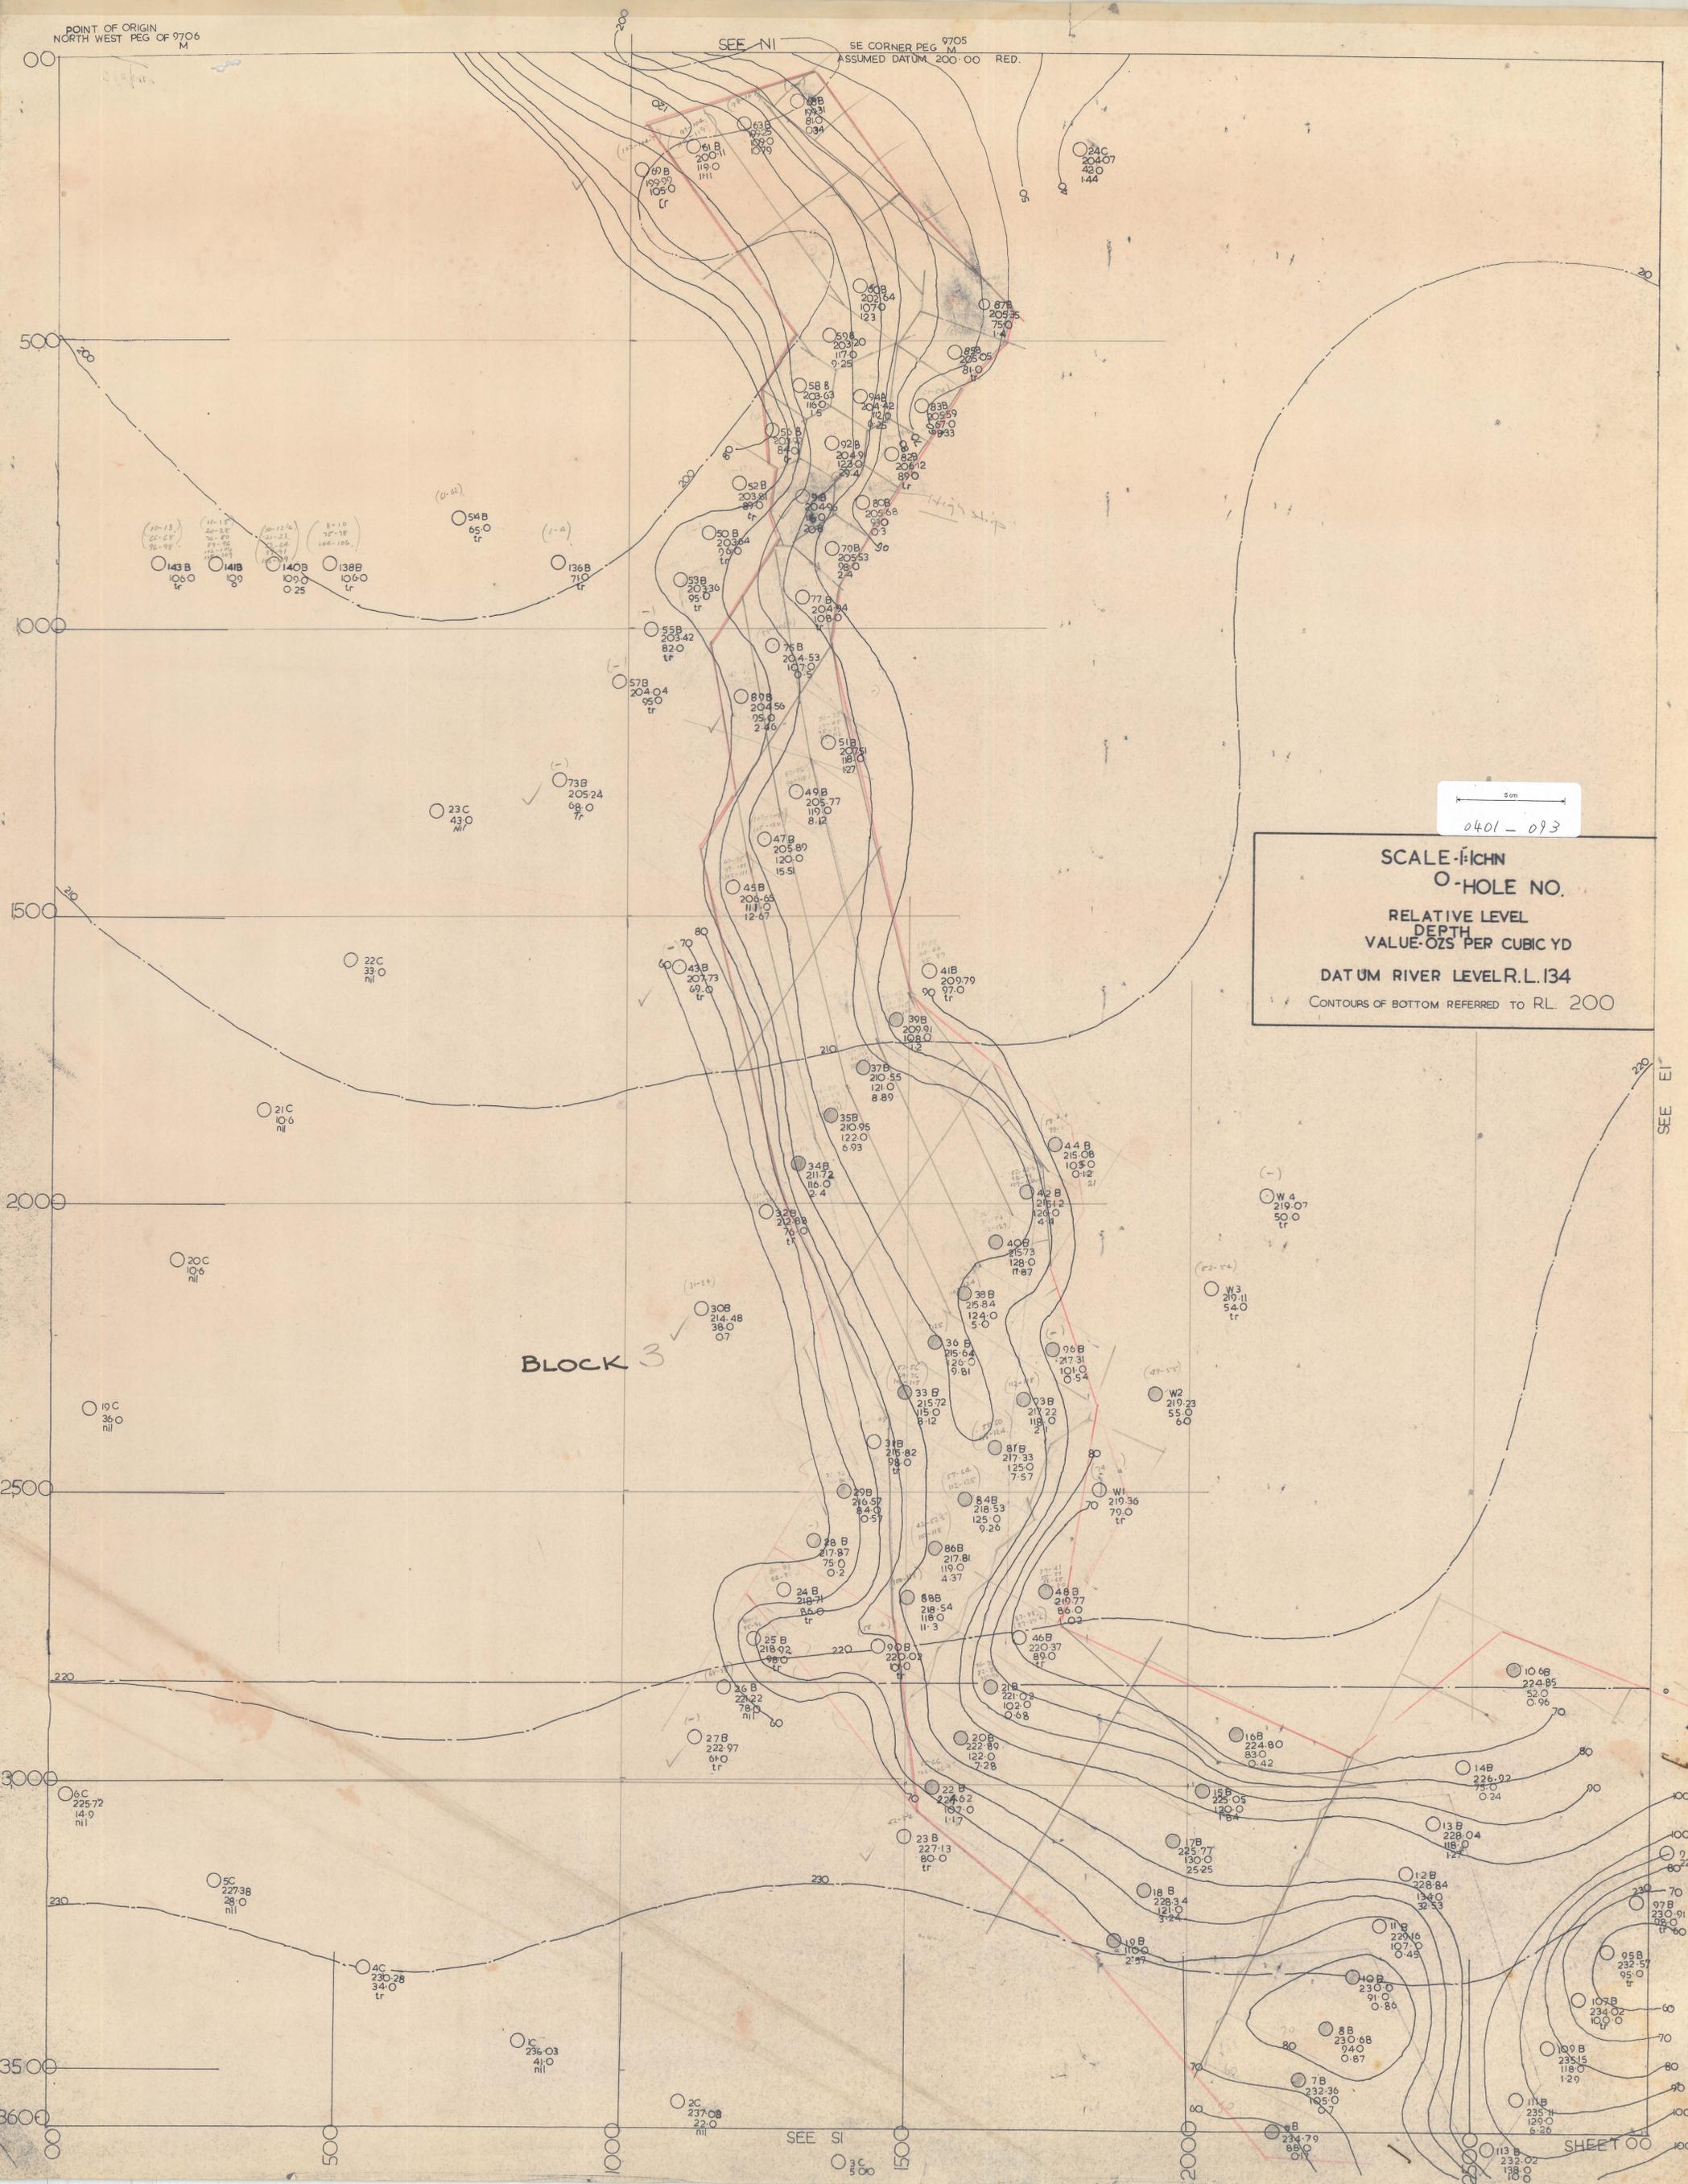

5cm
0401-093

SCALE: 1"=100'
 O-HOLE NO.
 RELATIVE LEVEL
 DEPTH
 VALUE-OZS PER CUBIC YD
 DATUM RIVER LEVEL R.L. 134
 CONTOURS OF BOTTOM REFERRED TO R.L. 200

BLOCK 3

SEE EI

SEE SI

SHEET 00