


SCOTIA

0401-09S

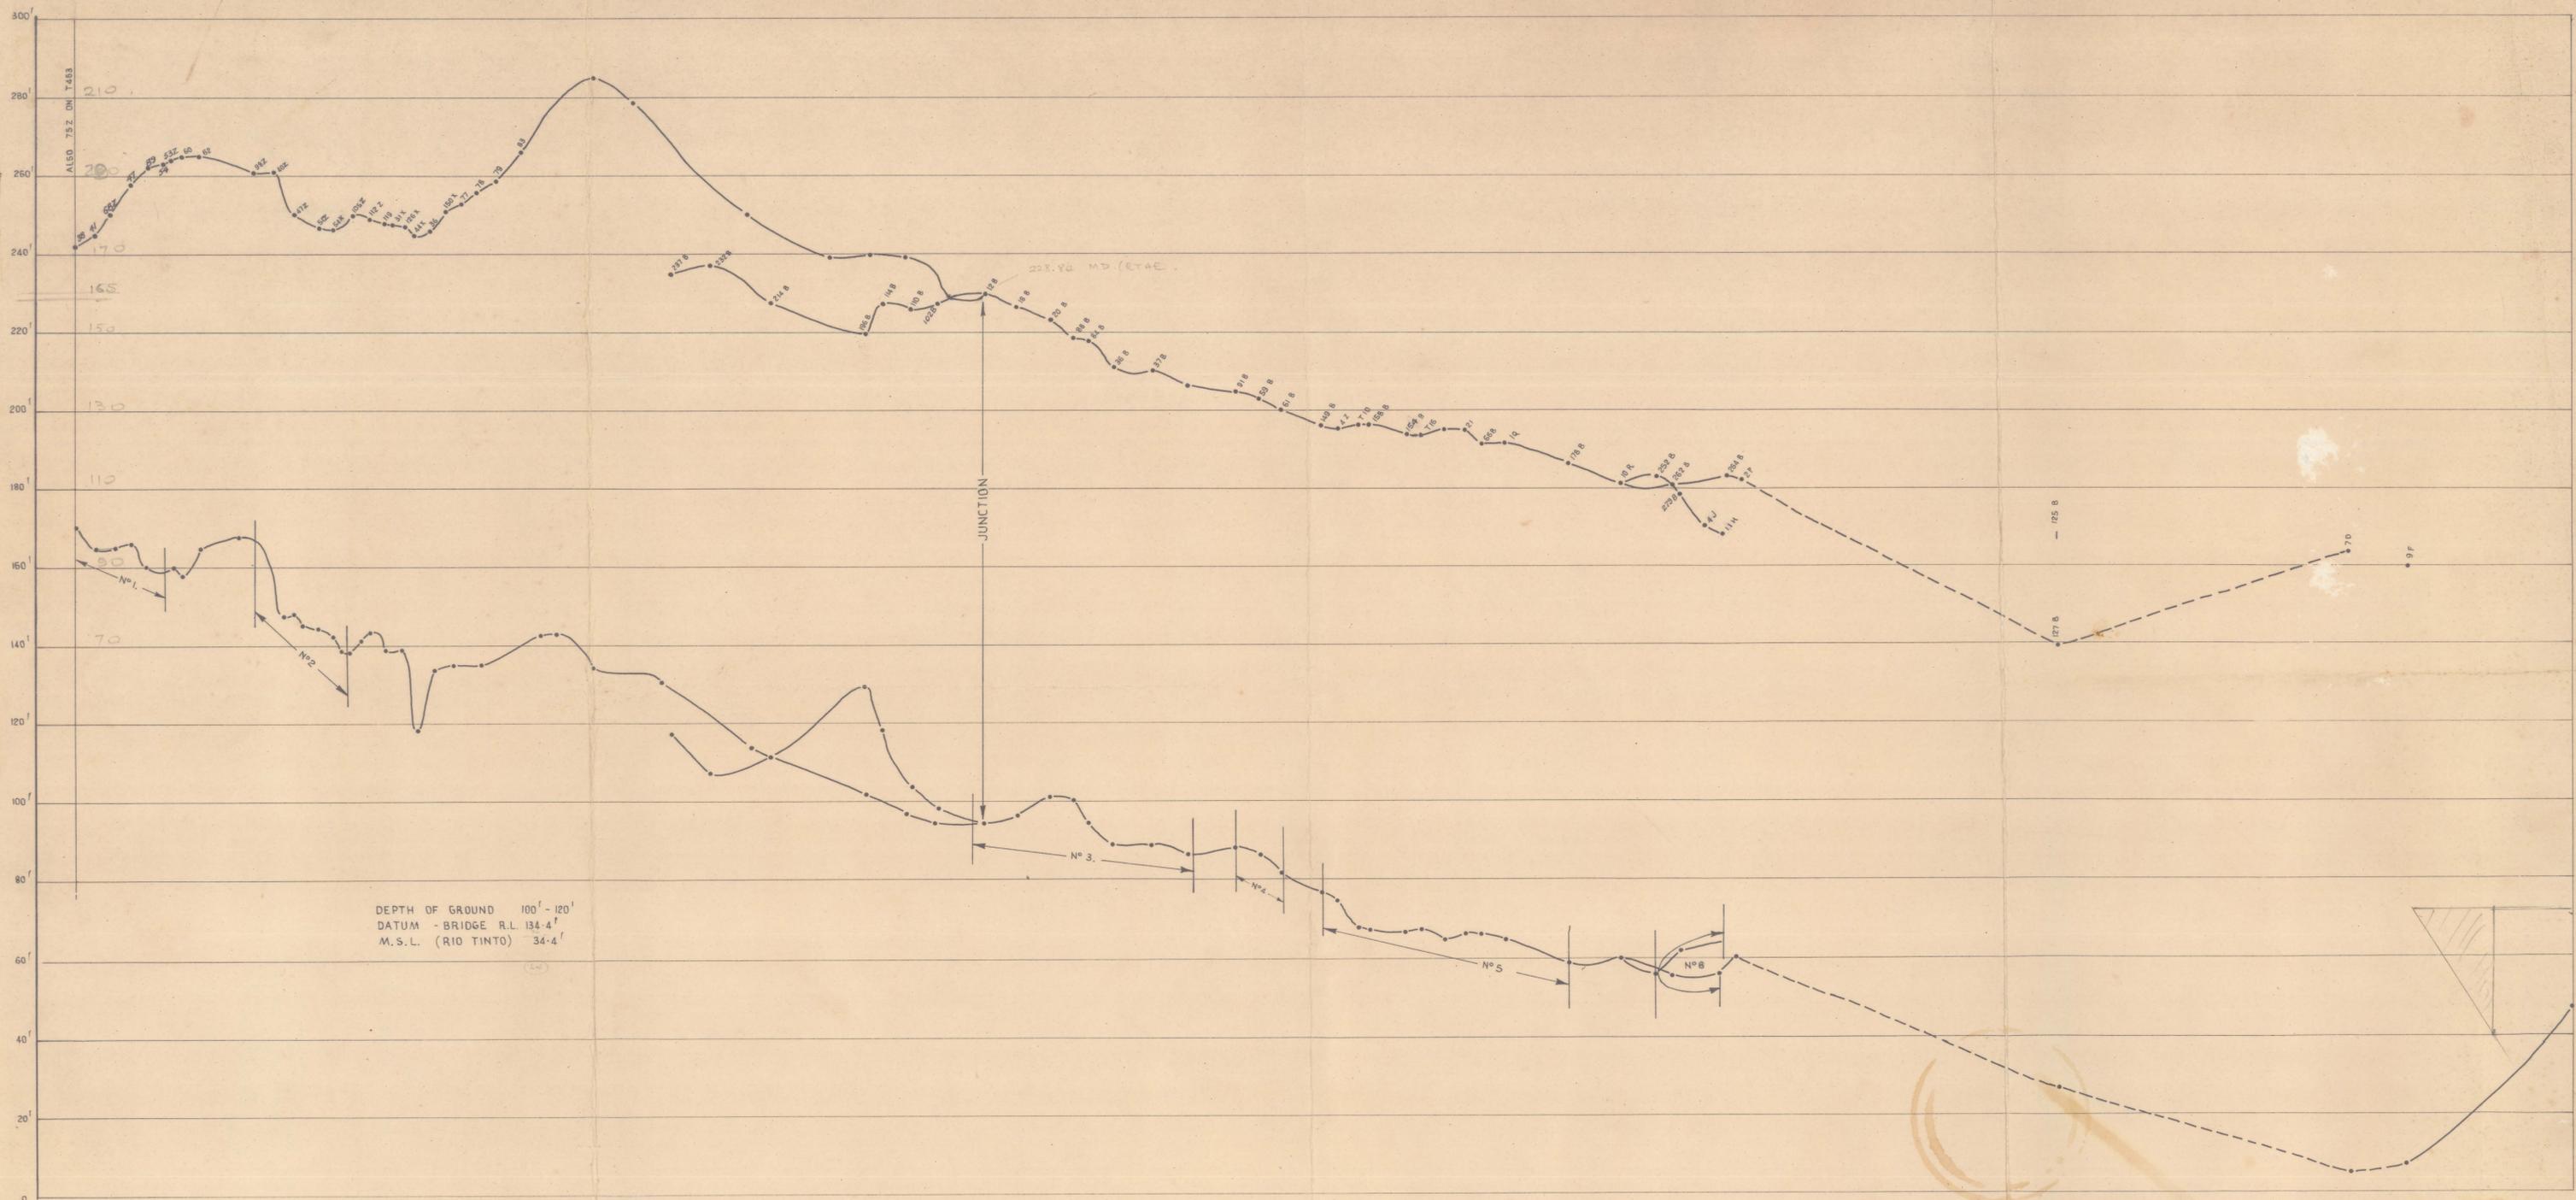

DEPTH OF GROUND 100' - 120'
 DATUM - BRIDGE R.L. 134.4'
 M.S.L. (RIO TINTO) 34.4'

LONGITUDINAL PROJECTION
SCOTIA LEAD

HORIZONTAL SCALE 1" = 10 CHNS.



0401-09S

Handwritten notes: 110 chs., 100/90 / 6/12 72, 110