


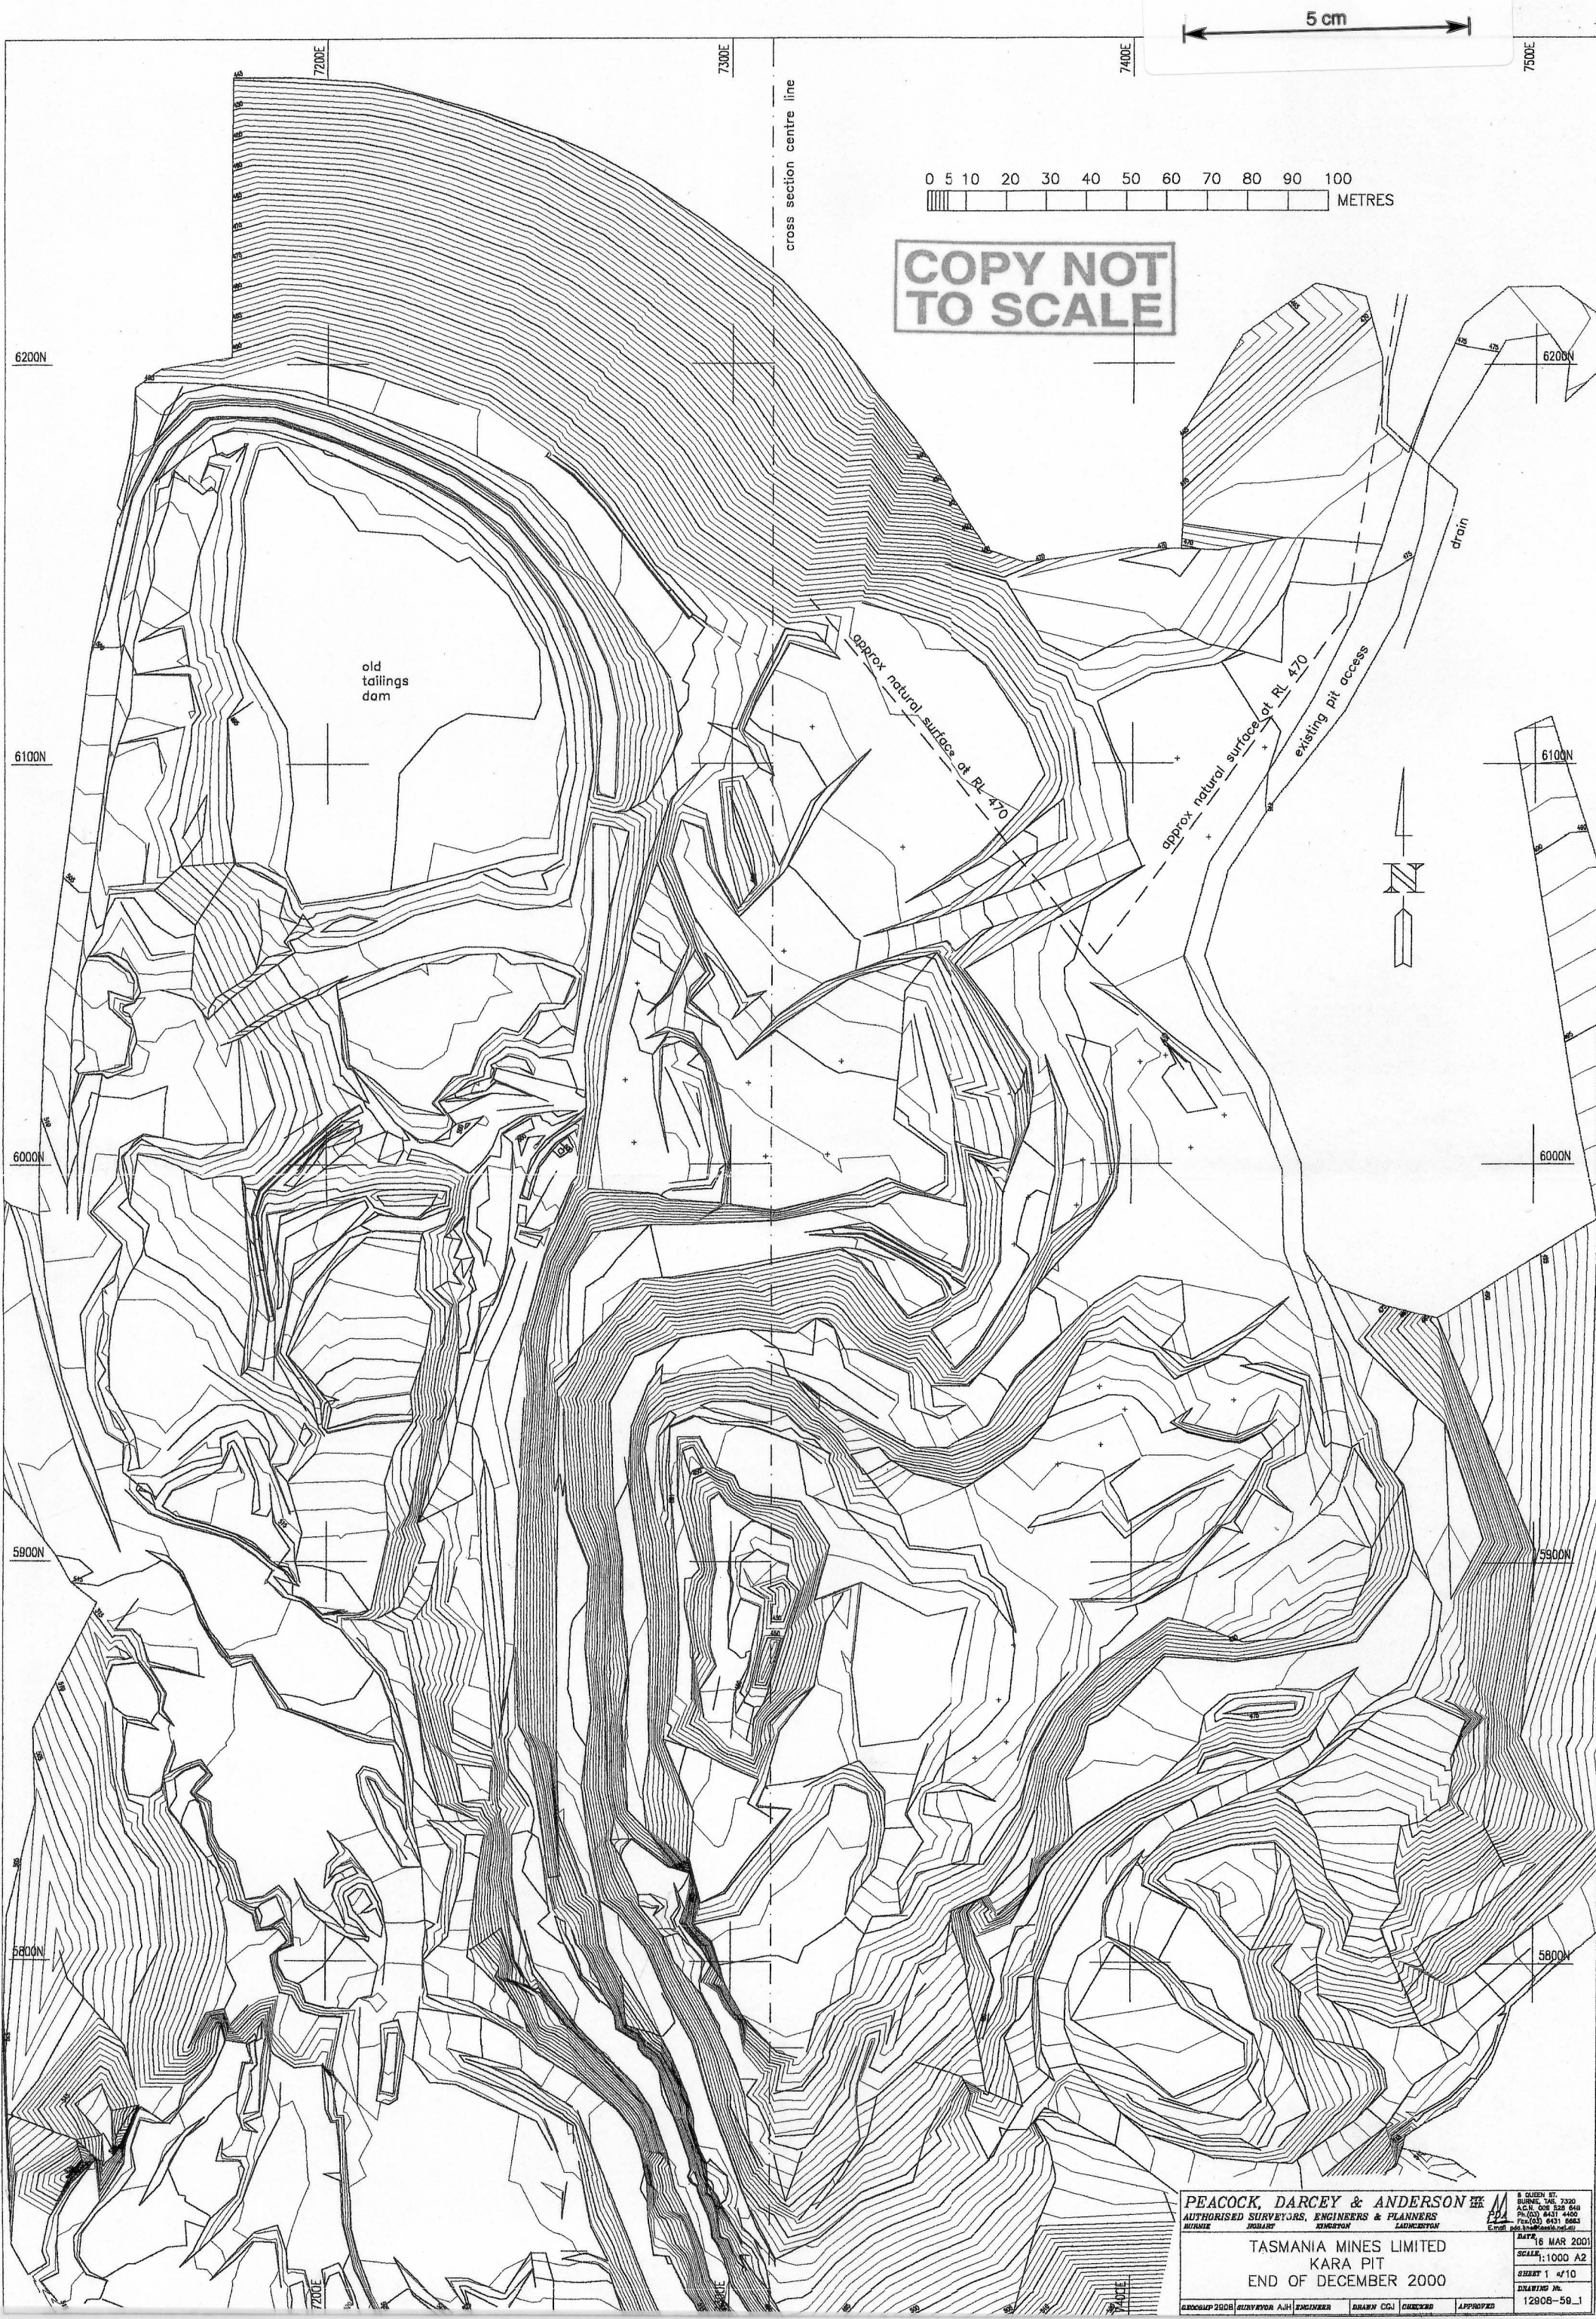

**COPY NOT
TO SCALE**

PEACOCK, DARCEY & ANDERSON		S. GARDIN, PT. SURVEY, 141, 2220 A.C.N. 008 528 848 P.O. BOX 4431 4400 Tas 7243 6431 6663 www.peacockda.com.au	
AUTHORISED SURVEYORS, ENGINEERS & PLANNERS		ESTABLISHED 1946	
SURVEY ENGINEERING PLANNING		CONSULTING	
TASMANIA MINES LIMITED KARA PIT END OF DECEMBER 2000			
PROJECT 2000	DESIGNED BY ALH	ENGINEER	DRAWN BY CGJ
CHECKED	APPROVED	DATE: 16 MAR 2001	
SCALE: 1:1000 A2		SHEET 1 of 10	
DRAWING NO.		12806-59.1	

0402-016