

0404-004

5,401,000 m.N.

5,400,000 m.N.

5,399,000 m.N.

DEPT OF MINES
SURVEYED 1972
COMPILED AND DRAWN BY G.BENN



592,000 m.E.

593,000 m.E.



68 M/78
162 ha.

29 M/74
130 ha.

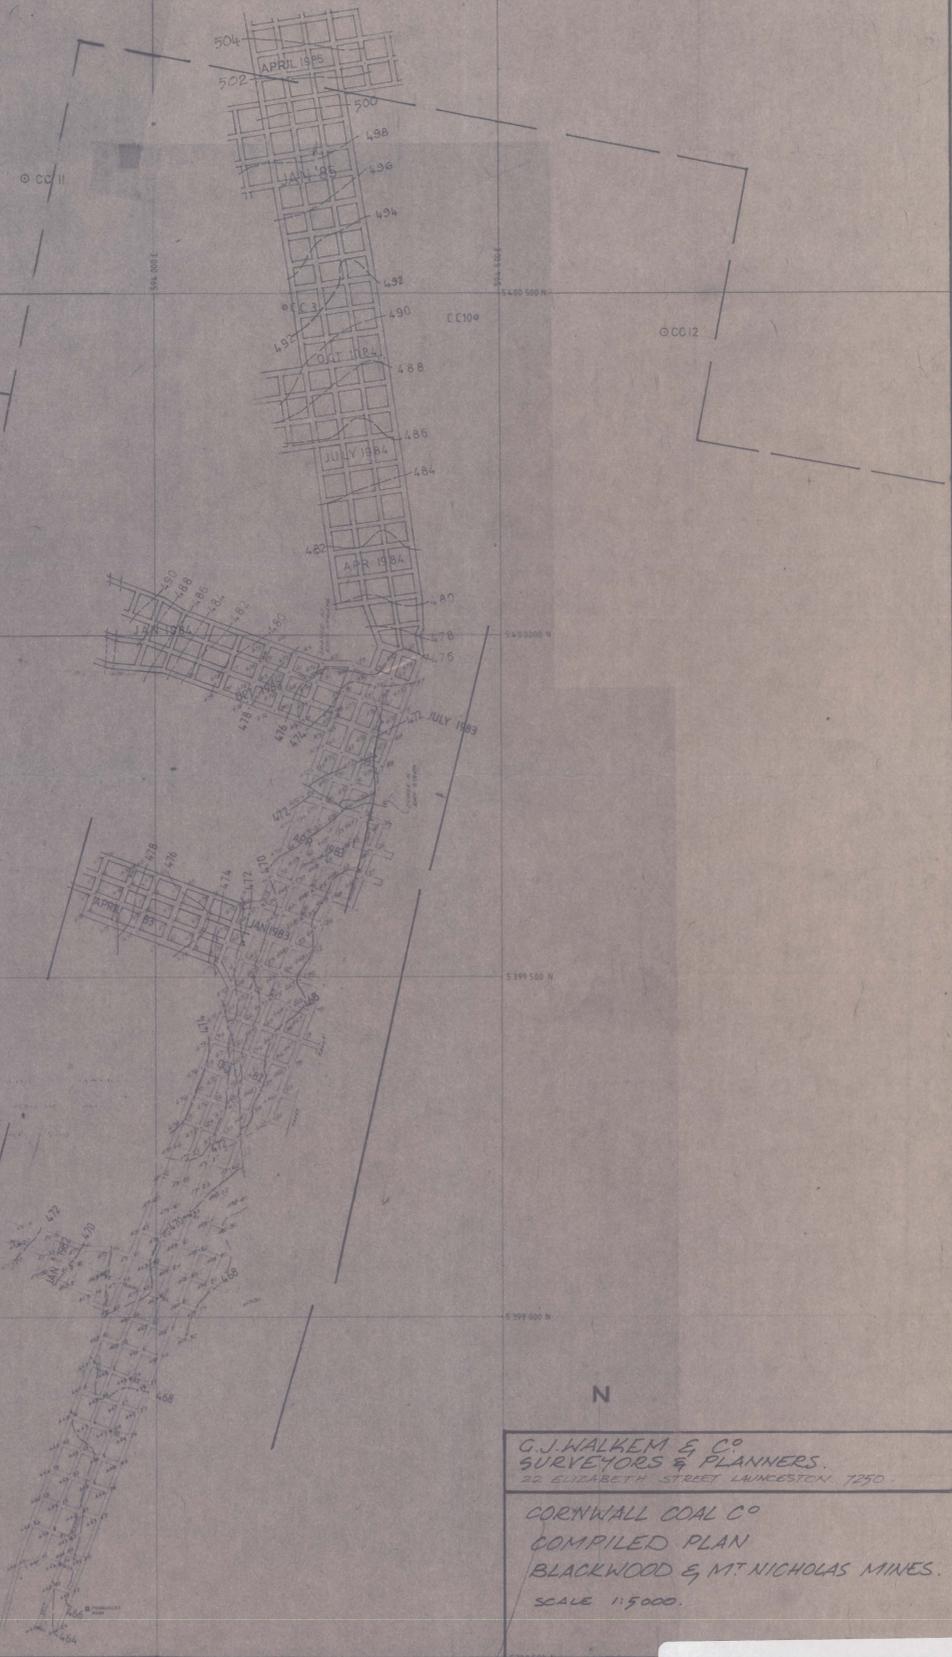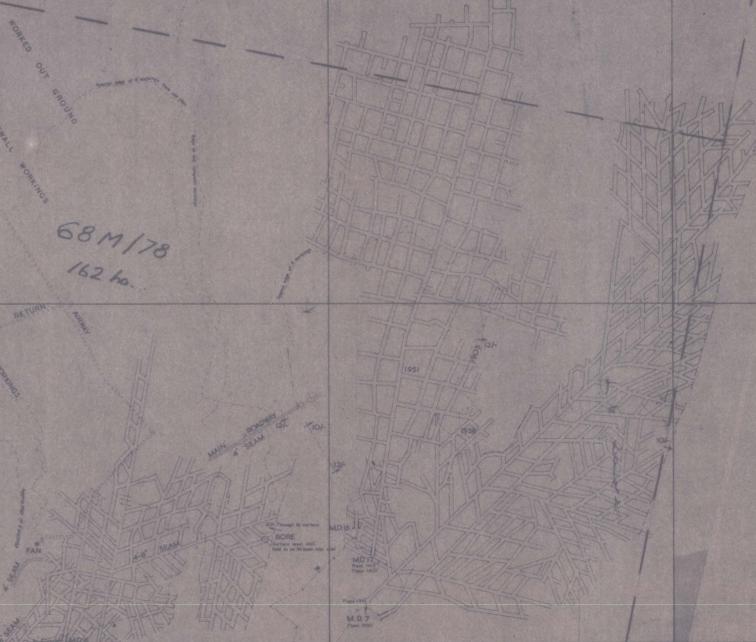

G.J. WALKER & CO
SURVEYORS & PLANNERS
22 ELIZABETH STREET LAUNCESTON, T.S.O.
CORNWALL COAL CO
COMPILED PLAN
BLACKWOOD & MT. NICHOLAS MINES.
SCALE 1:5000.

DEPARTMENT OF MINES TASMANIA
PLANS RECEIVED UNDER (SECTION 31) MINES INSPECTION ACT
A/CARD No. 85008
THE CORNWALL COAL CO. NO LIABILITY
BLACKWOOD BLACKWOOD & MT. NICHOLAS MINES
Co. Ref. WORKINGS AT 82/85