

0404-004

|                |             |         |          |
|----------------|-------------|---------|----------|
| NO.            | DATE        | BY      | REVISION |
| 1              | 17 FEB 1983 |         |          |
| DEPT. OF MINES |             | E. & L. |          |


NEW PLAN/REV.  
 DATE: 17 FEB 1983  
 SCALE: 1:2500  
 NO. 2058

83010

C. J. WALKEM & CO. SURVEYORS & PLANNERS.

BLACKWOOD COLLIERY.

C.C.12

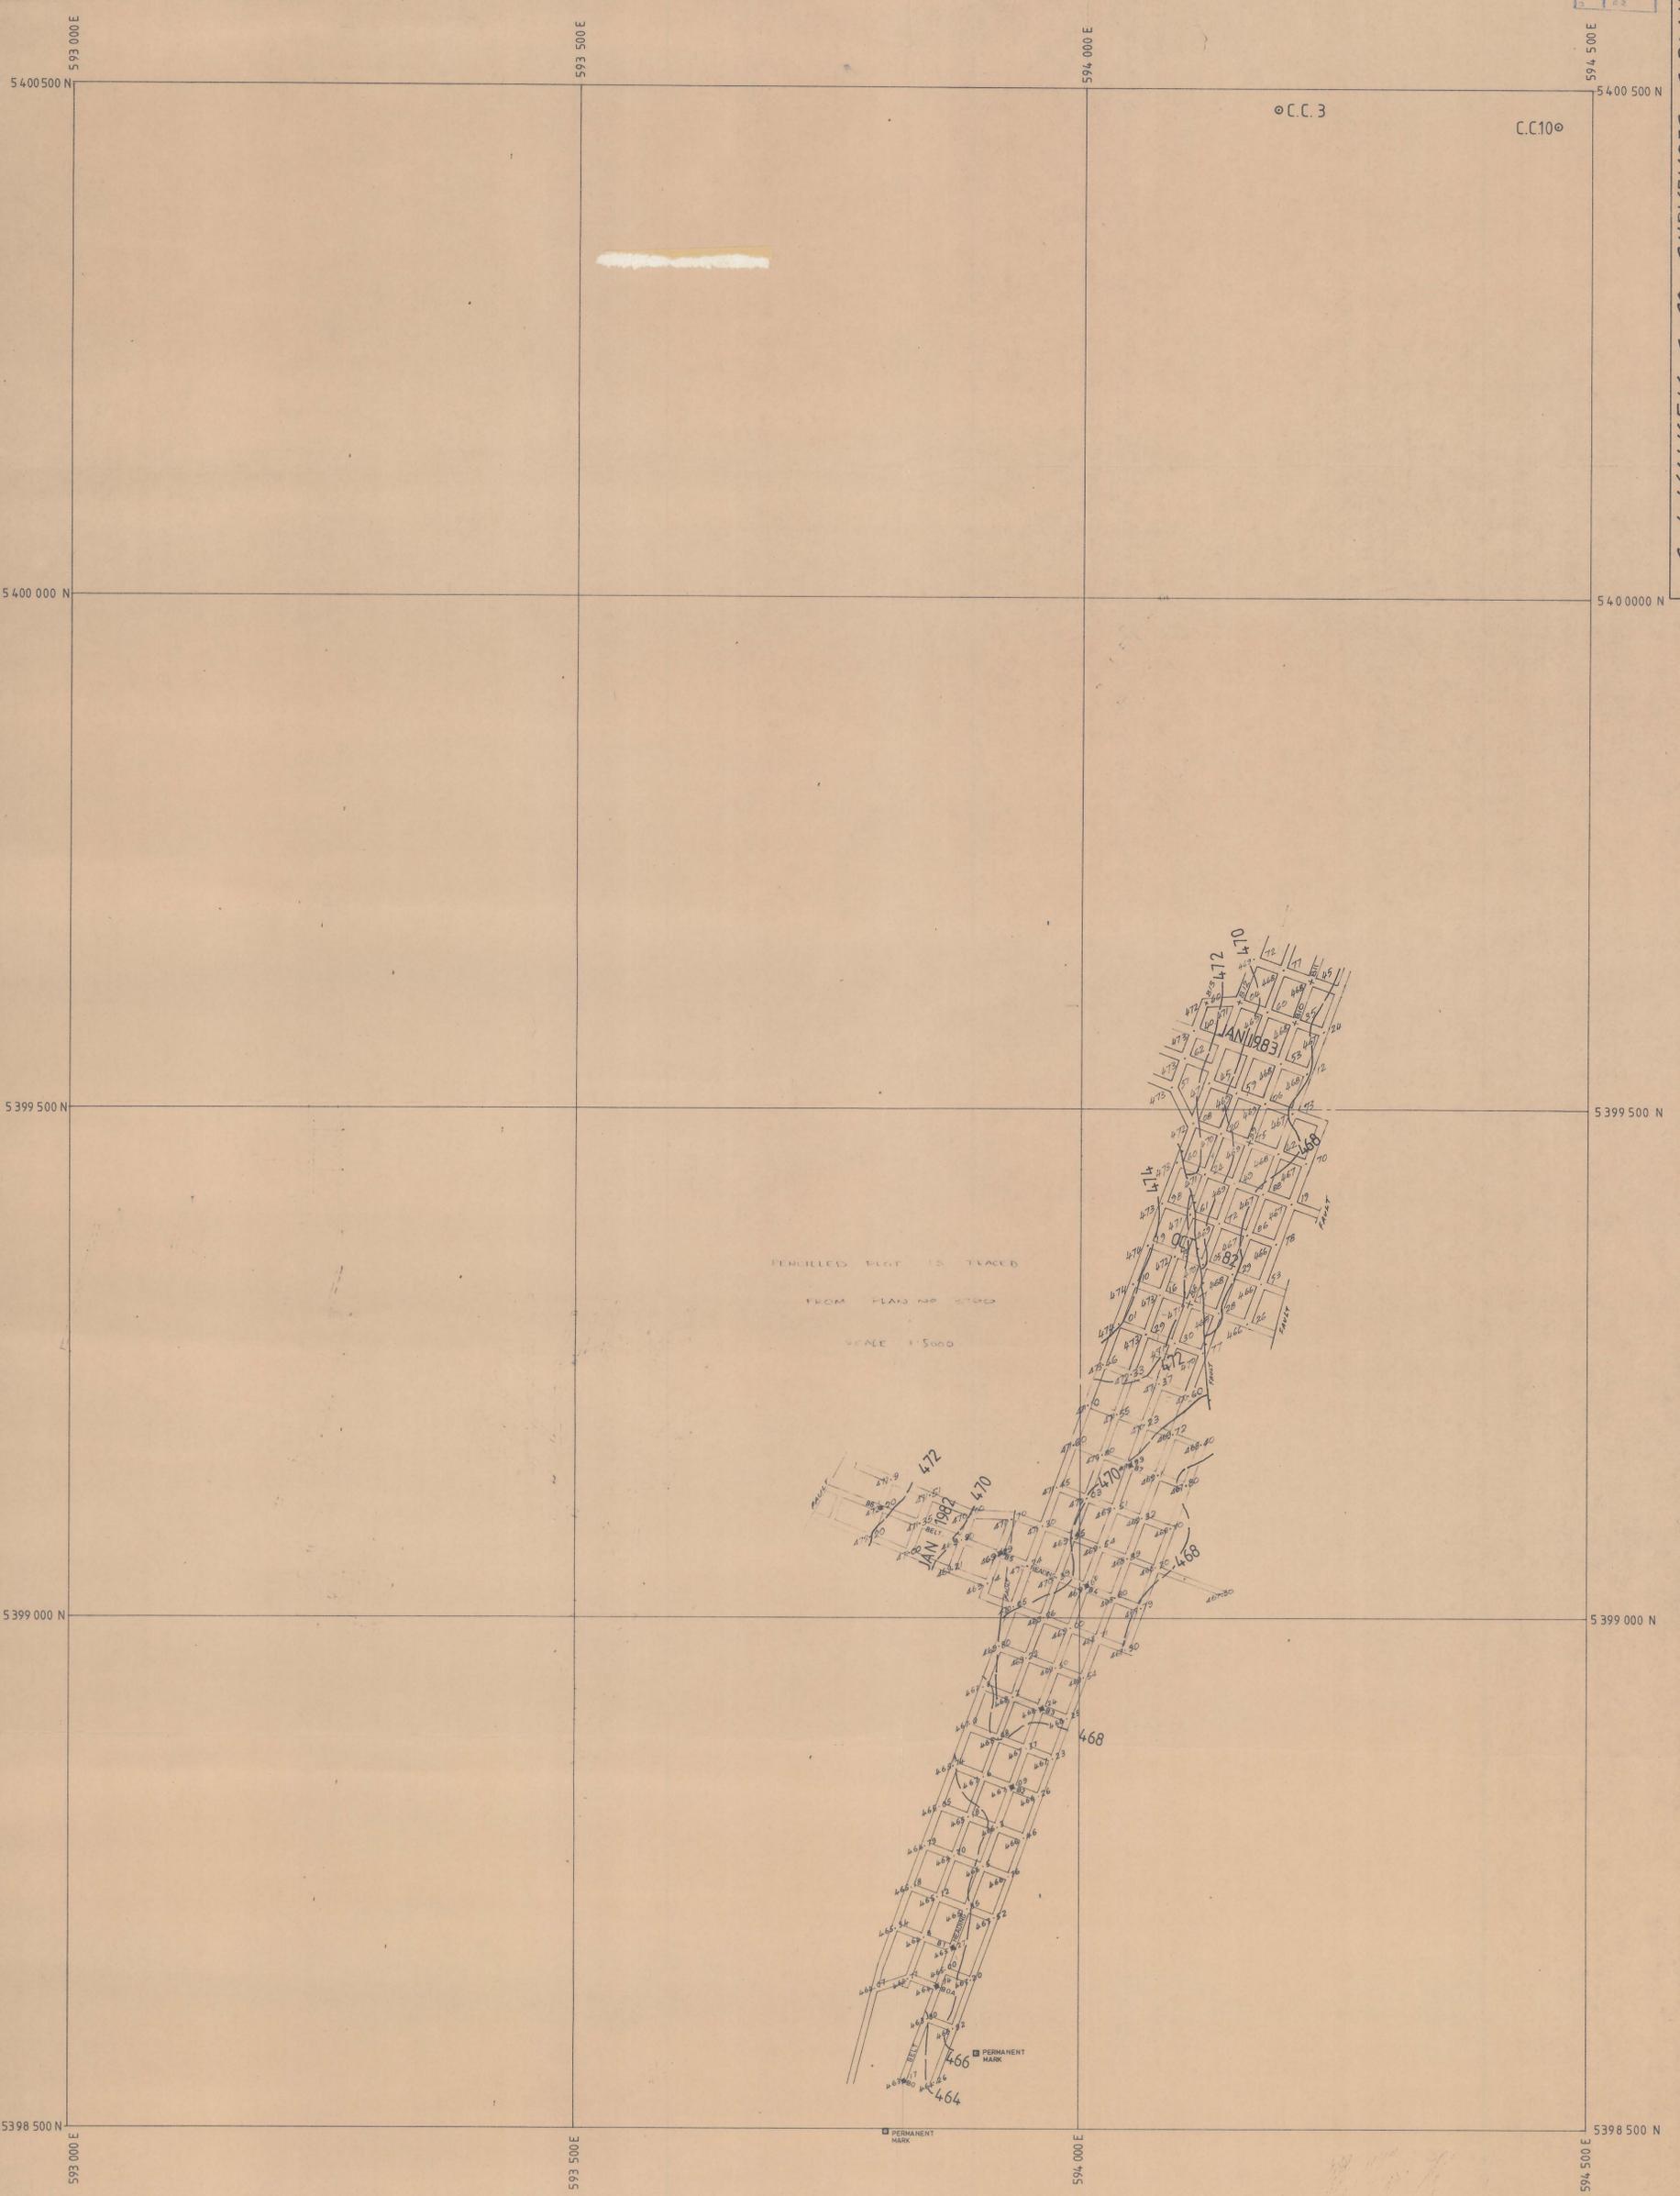

REPLICATED FROM ORIGINAL  
 FROM PLAN NO. 2058  
 SCALE 1:5000

BLACKWOOD MINE  
 SCALE 1:2500