


0404 - 008

CC.11

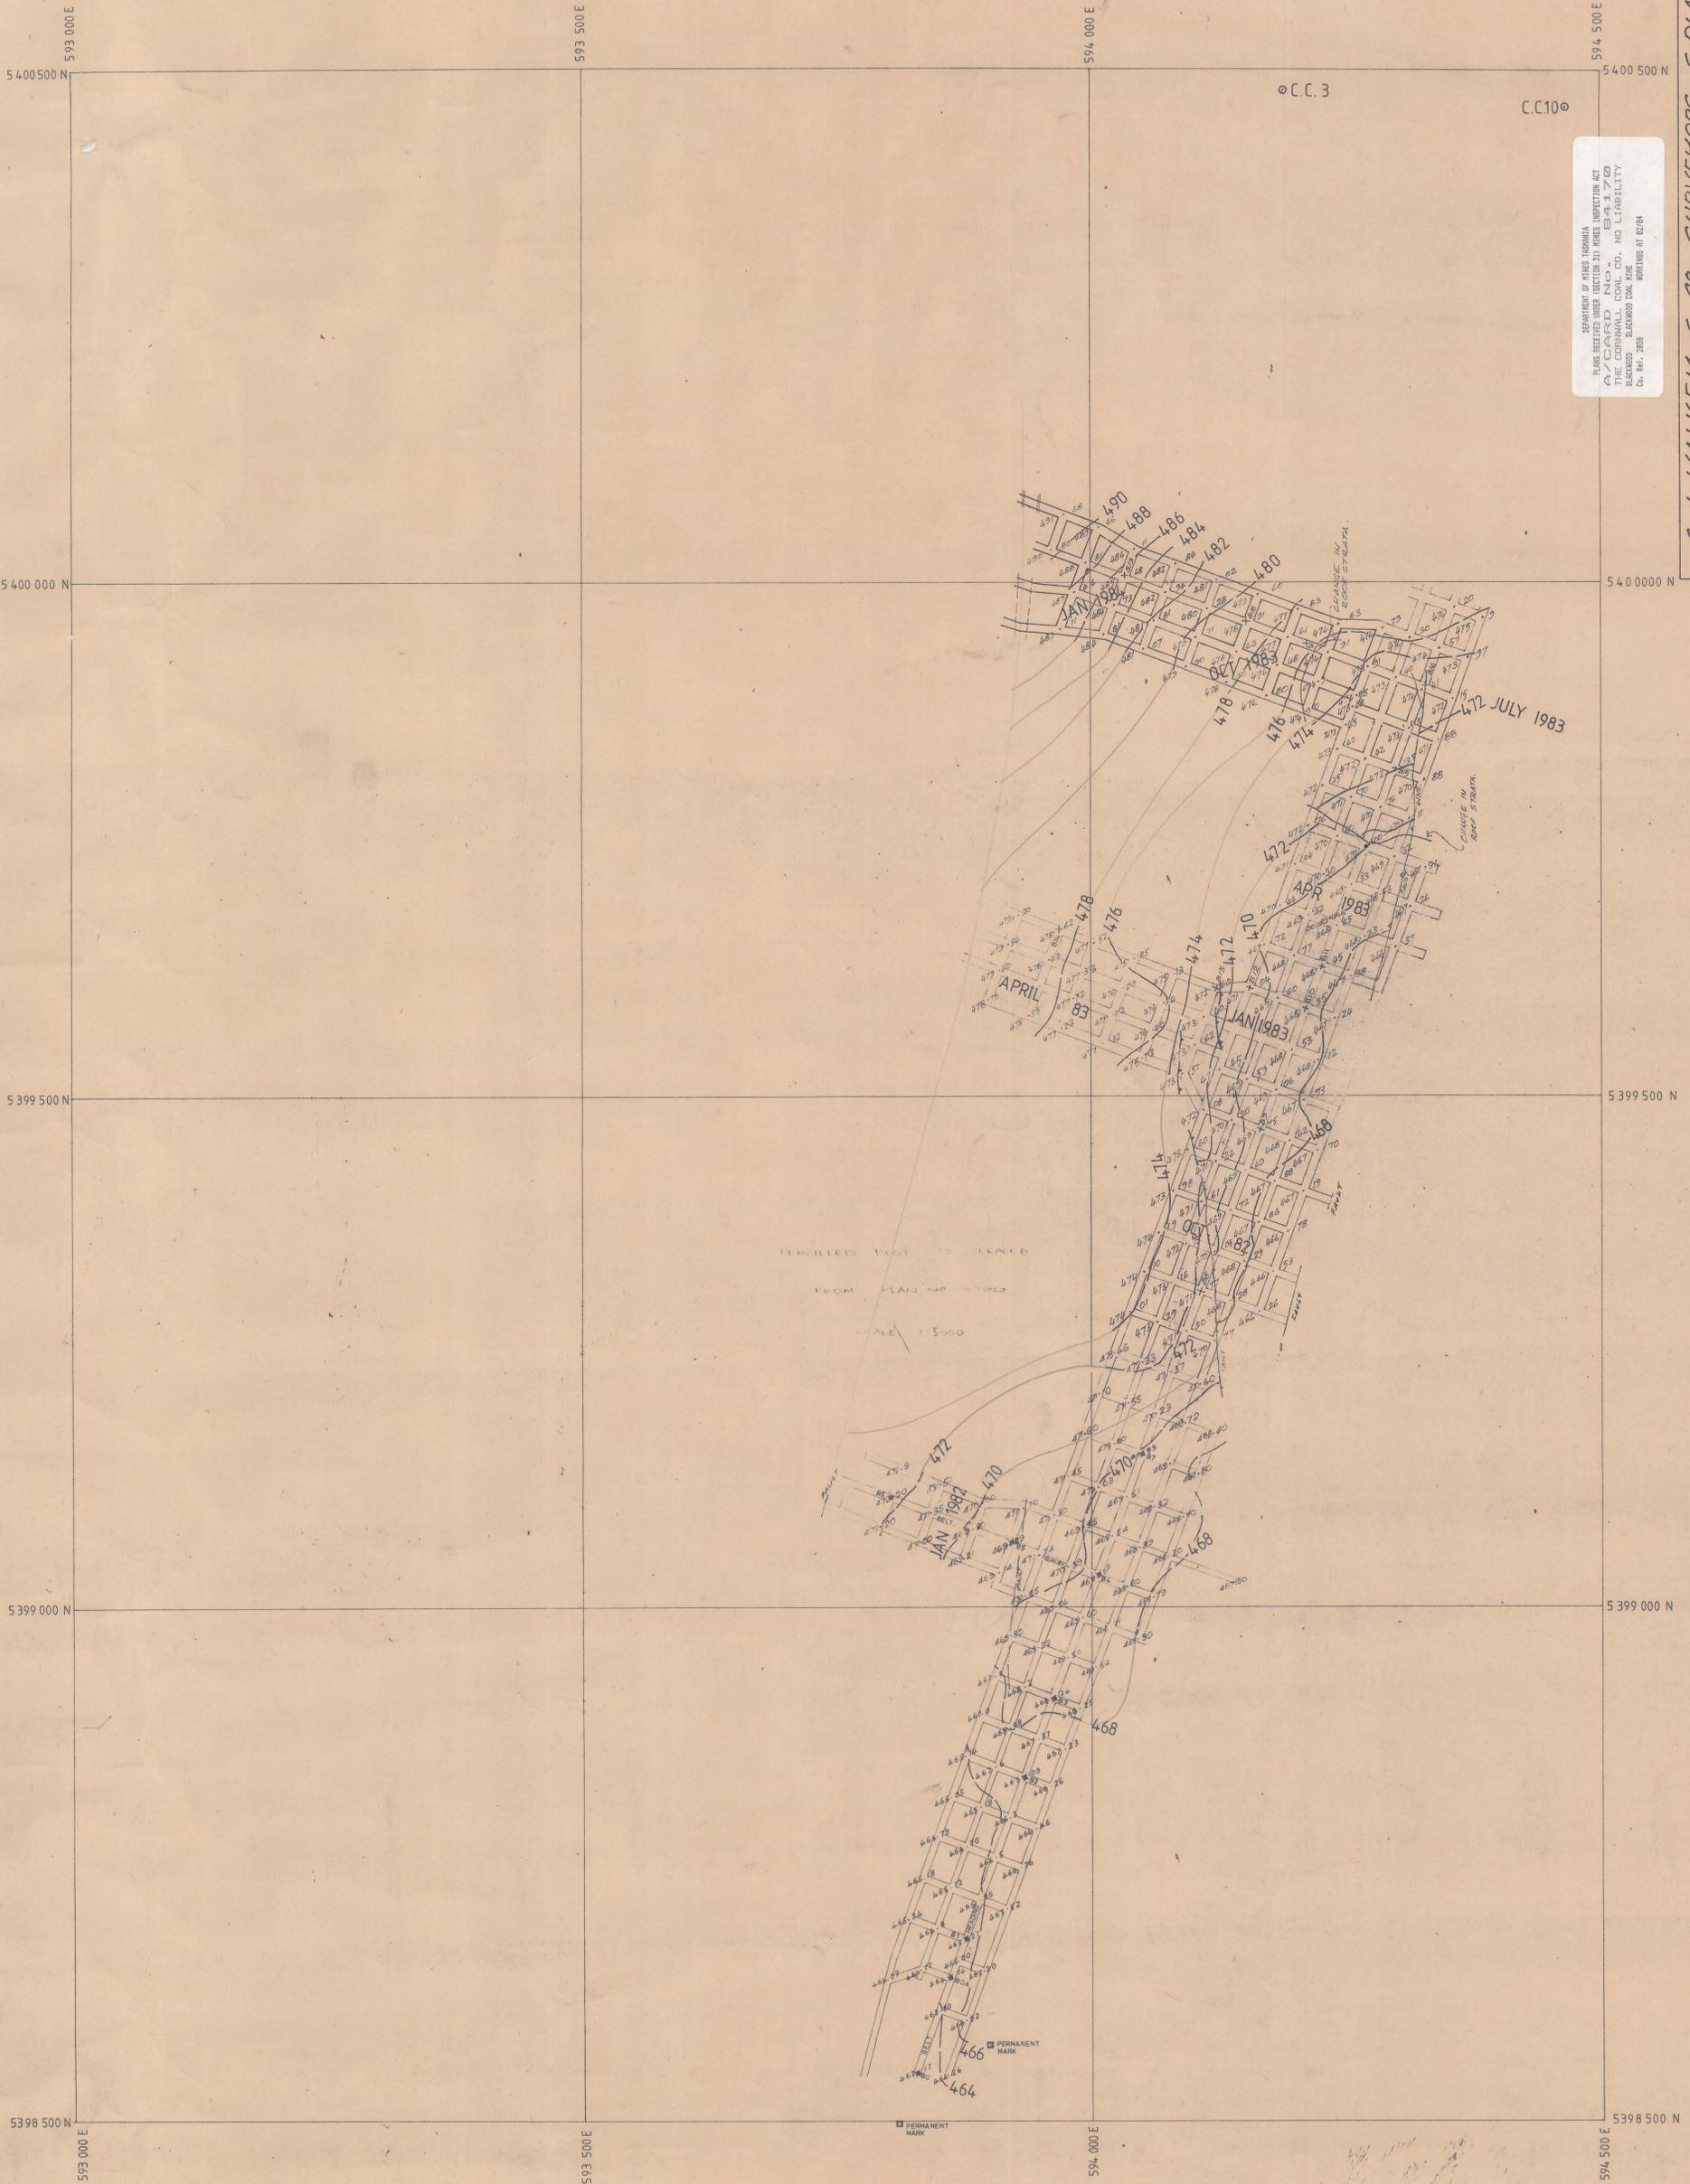

DEPARTMENT OF MINES, TASMANIA
 PLAN RECEIVED UNDER SECTION 31, MINES INSPECTION ACT
 IN THE CORNWALL COAL CO., NO LIABILITY
 BLACKWOOD, BLACKWOOD COAL MINE
 CO. 1947, 1953
 REVISIONS AT 12/84

C. J. WALKEM & CO. SURVEYORS & PLANNERS.
 BLACKWOOD COLLIERY.

REVISED 9-11-1981
 DATE 29-10-1982
 SCALE 1:500
 NO 2058

BLACKWOOD MINE
 SCALE 1:2500

