



0404-011

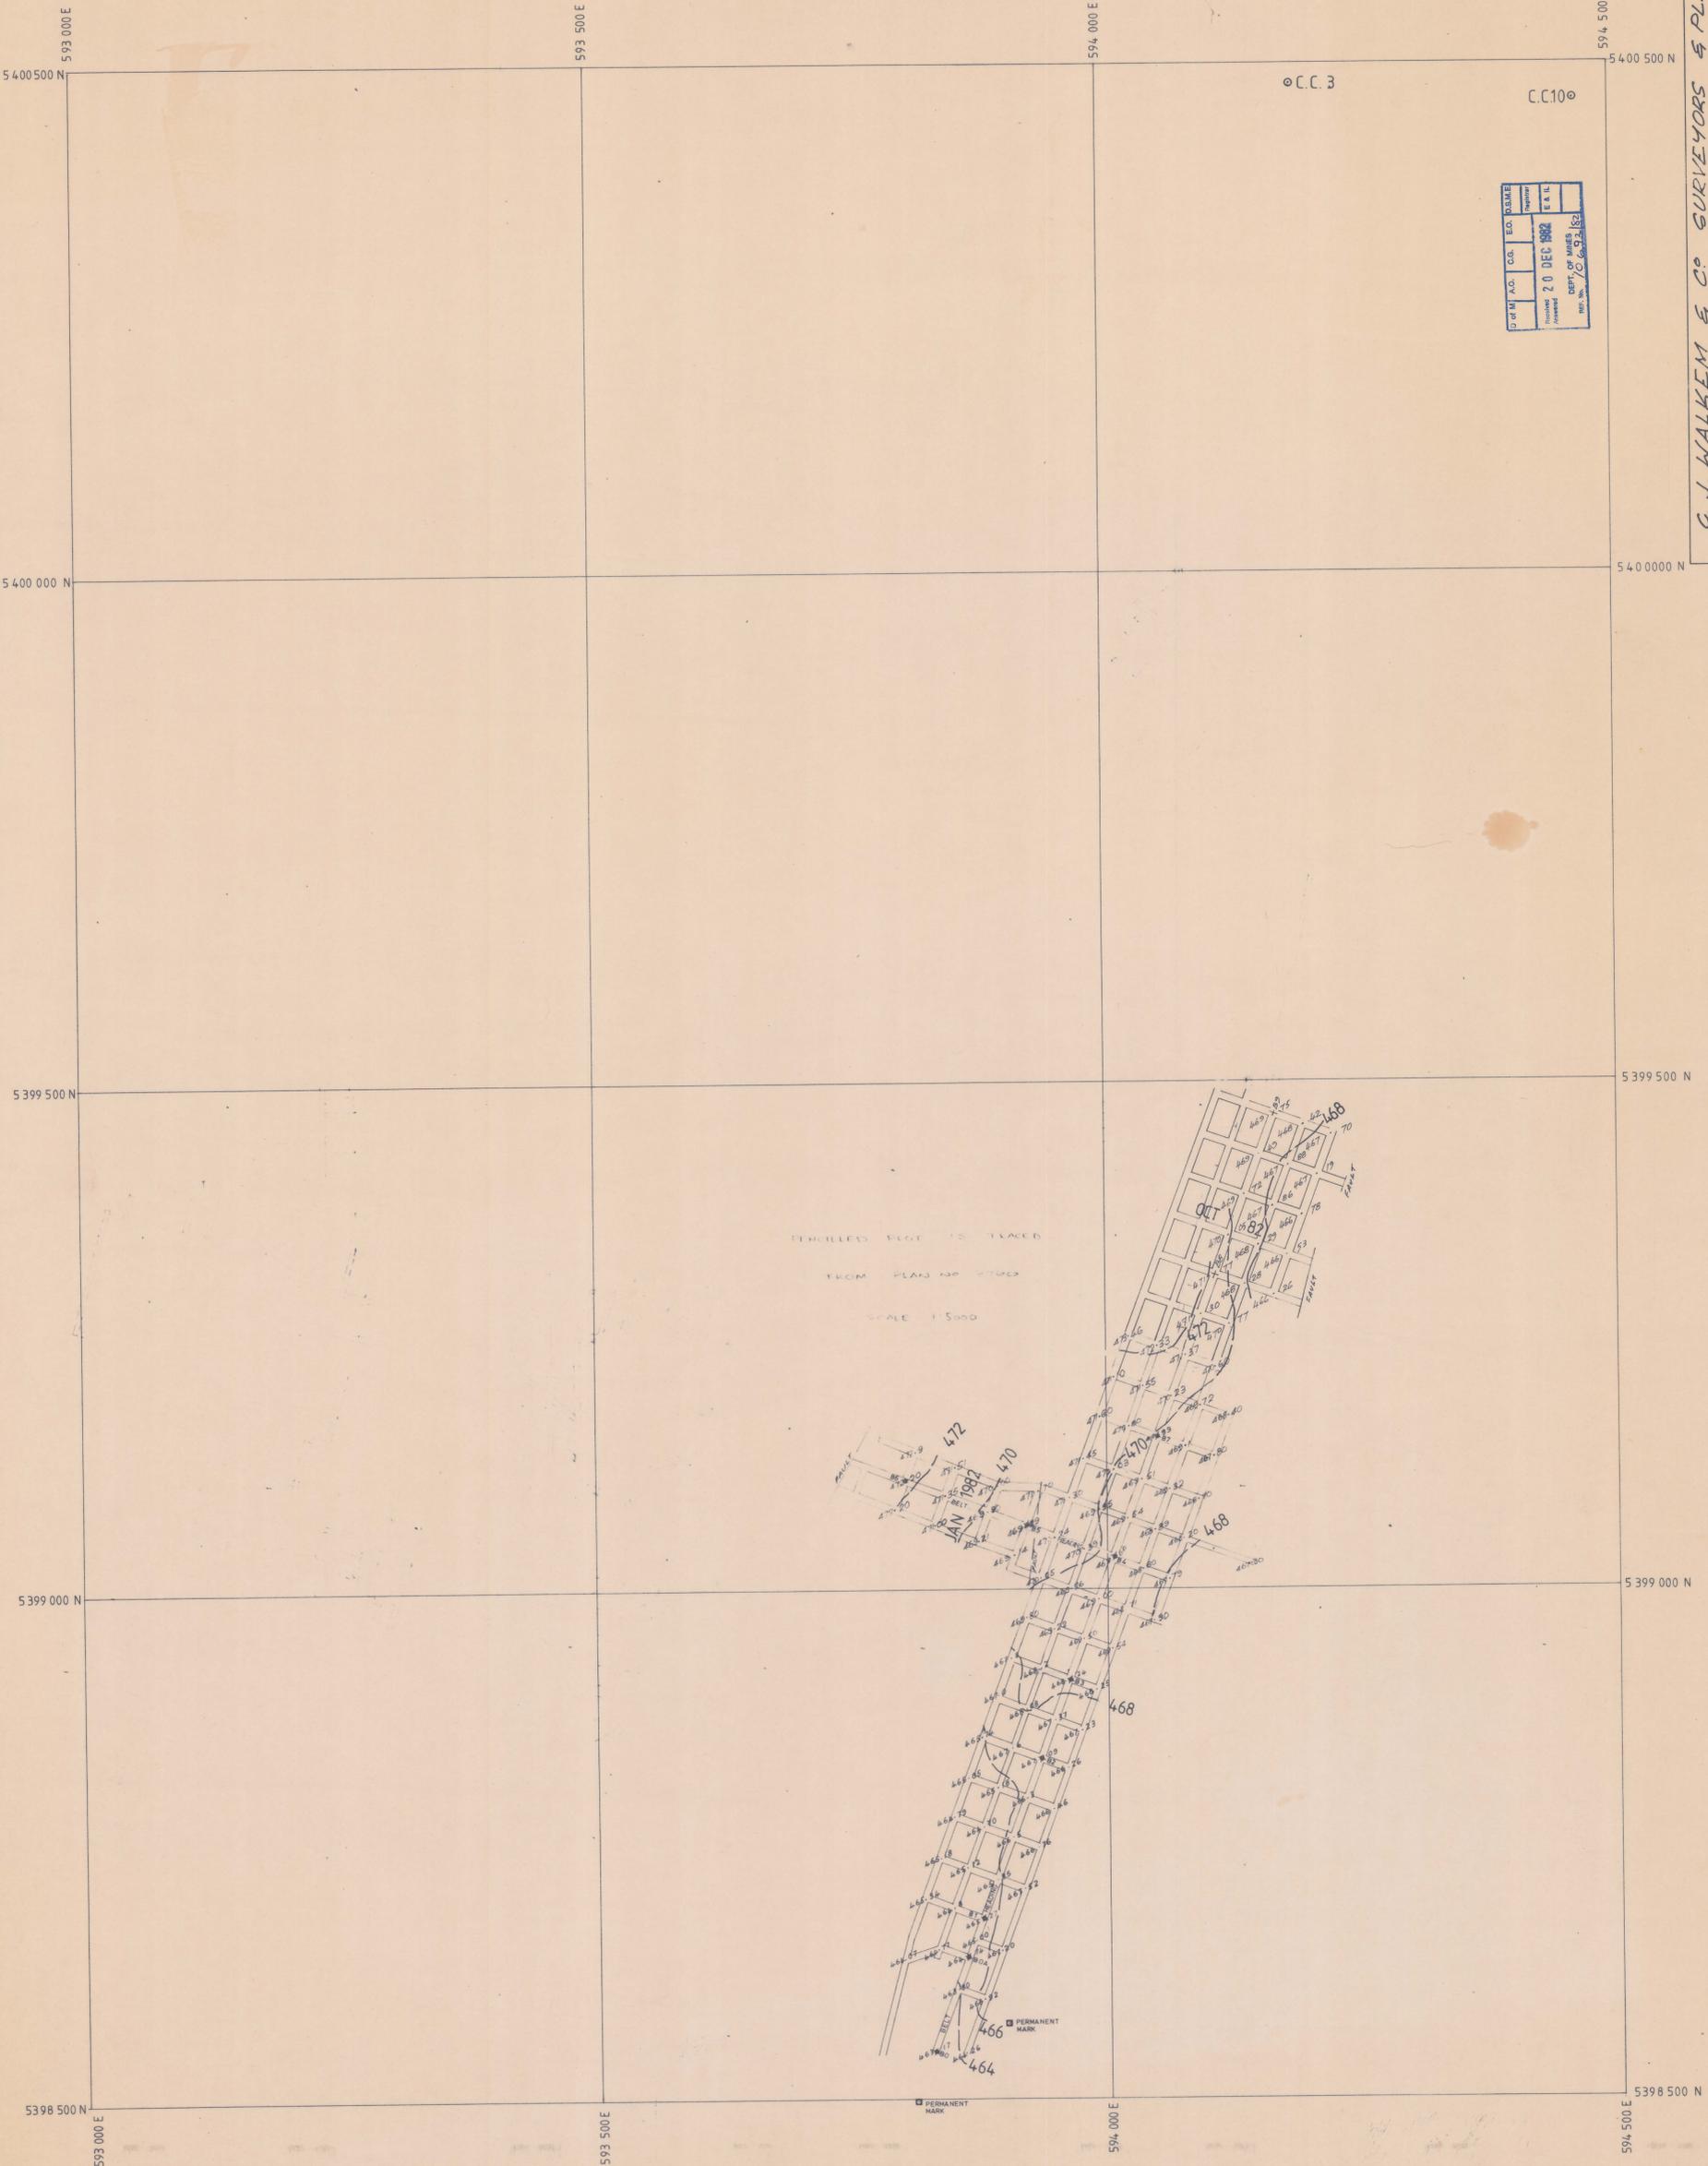

BLACKWOOD MINE  
SCALE 1:2500

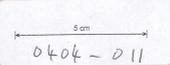

DATE	20 DEC 1982
BY	DEPT. OF MINES
PROJECT	100/100/100
SCALE	1:2500

C. J. WALKEM & CO SURVEYORS & PLANNERS.  
BLACKWOOD COLLIERY.

DATE 9 JUL 1981  
DATE 25 10 1982  
SCALE 1:2500  
NO 2058

C.C.12

C.C.11

C.C.3

C.C.10

5400500 N  
5400000 N  
5399500 N  
5399000 N  
5398500 N

593 000 E  
593 500 E  
594 000 E  
594 500 E