



5 cm

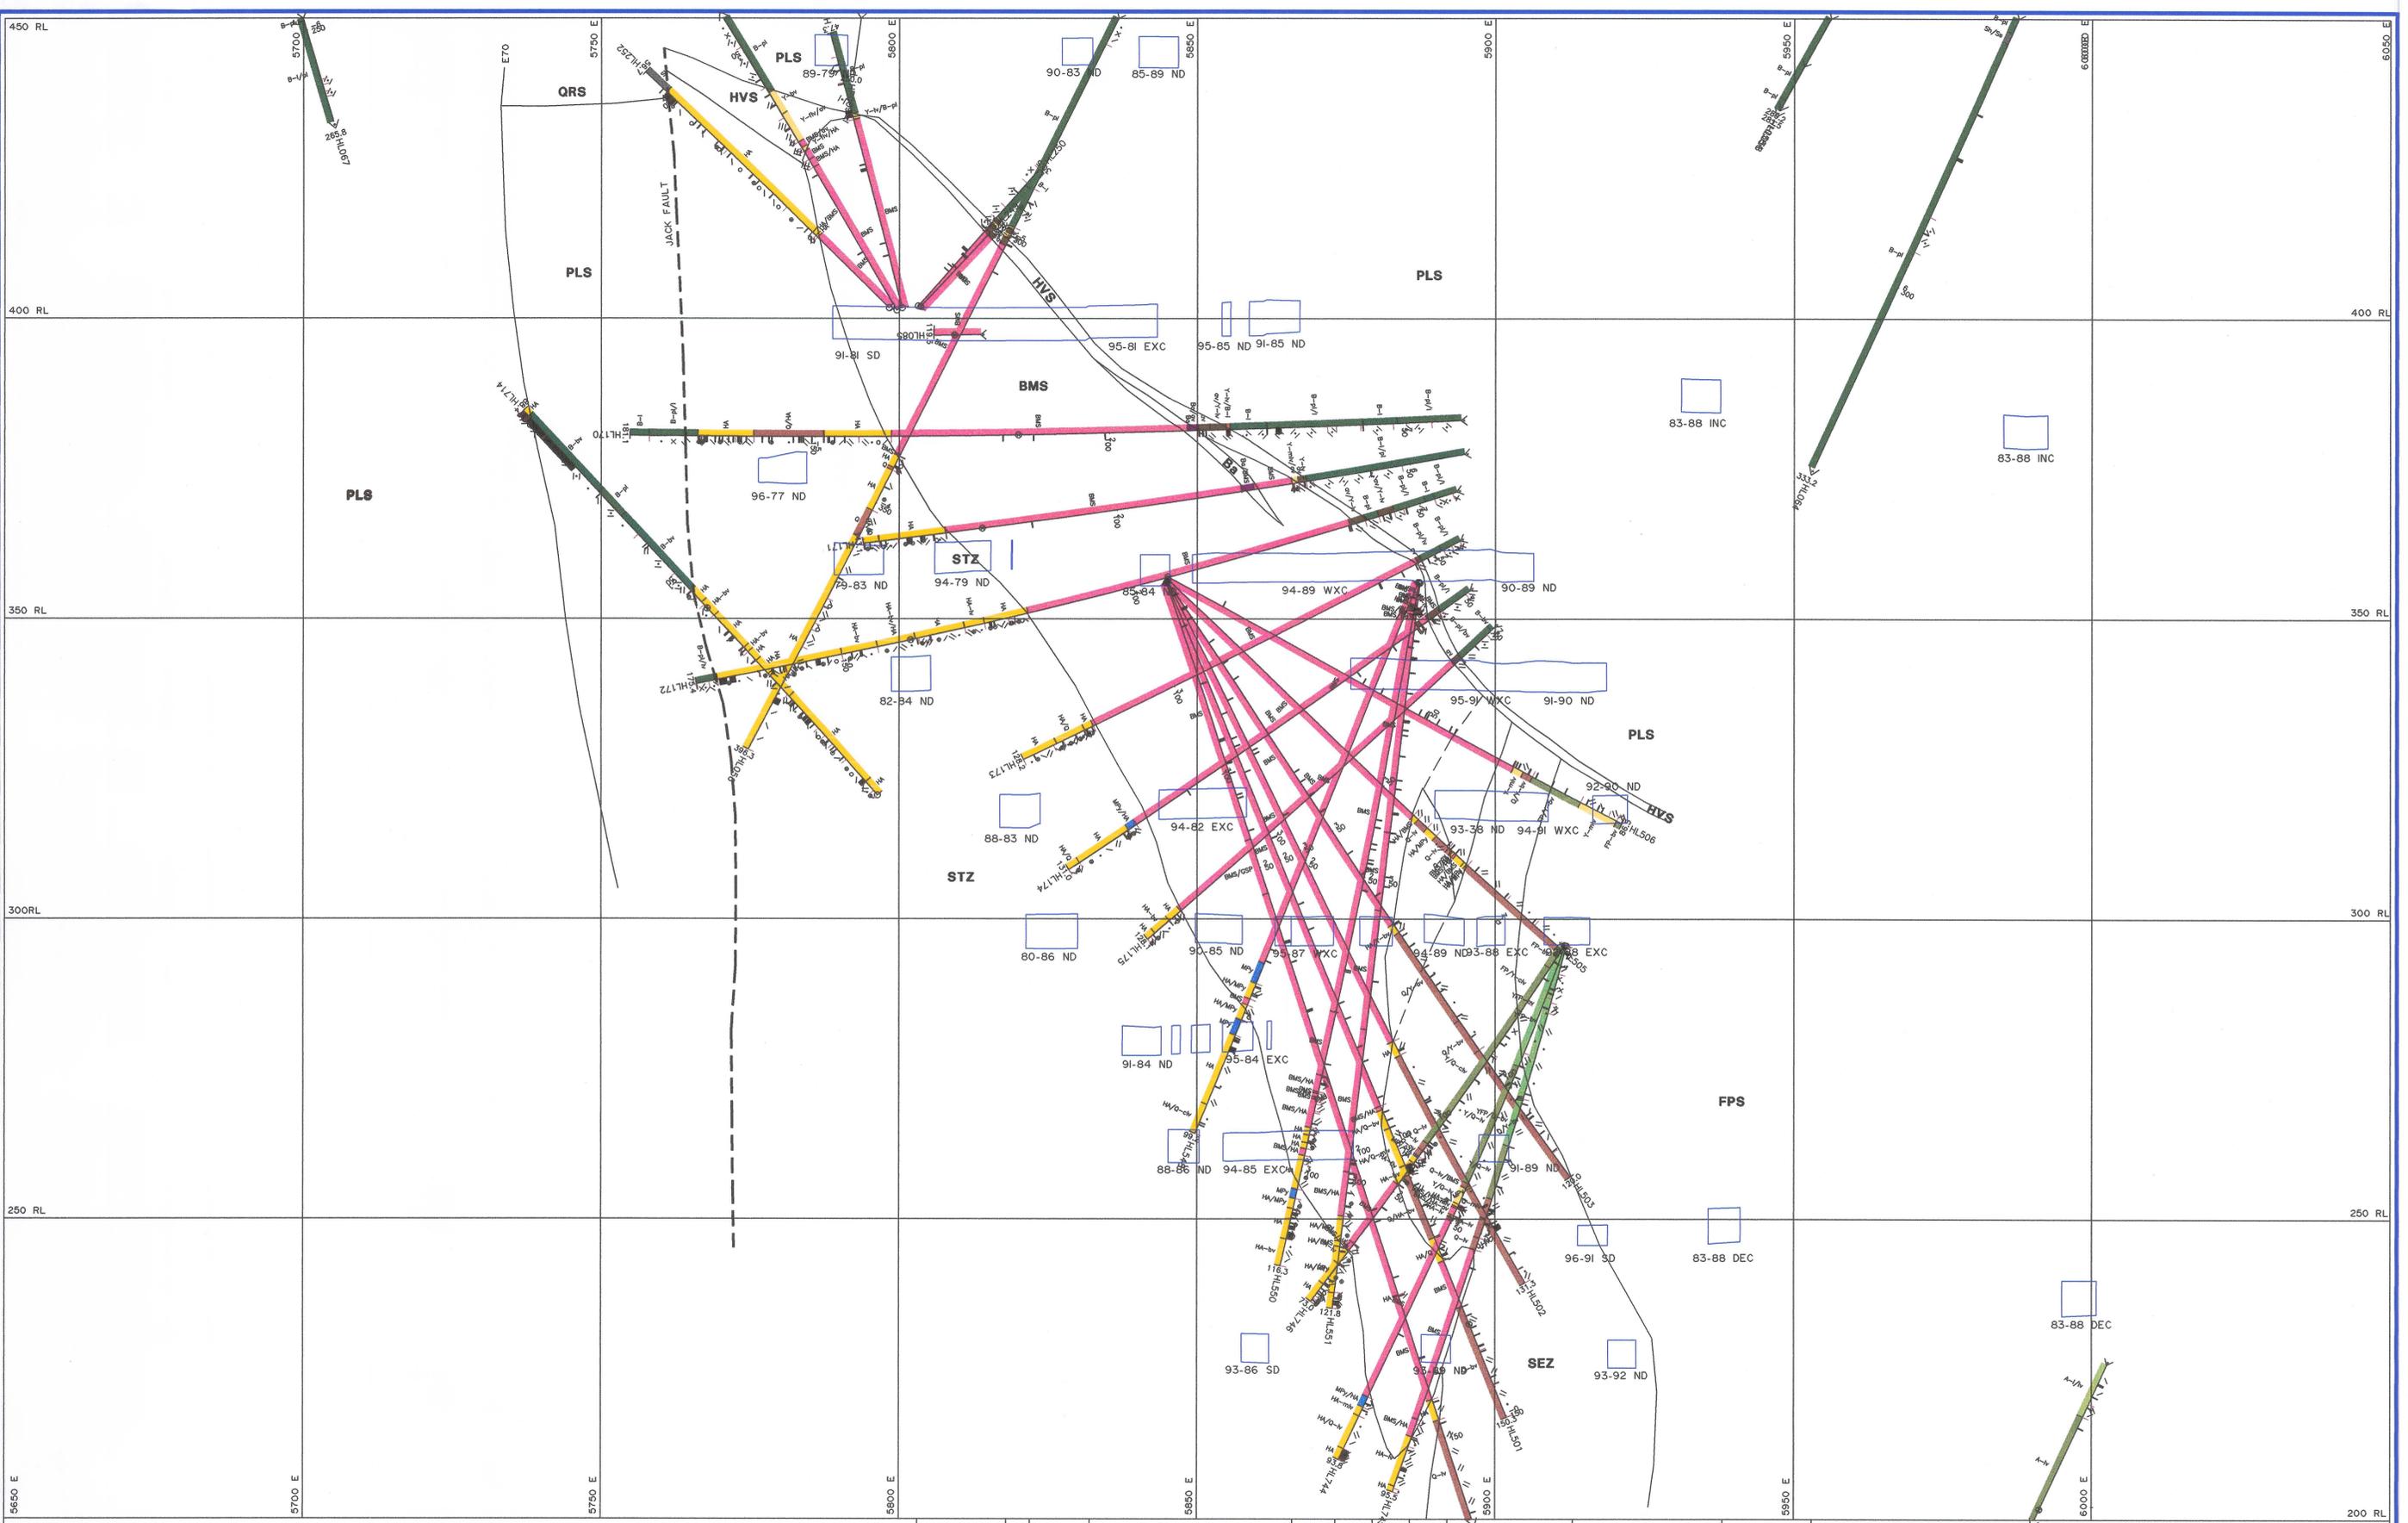

| ALTERATION | A | 10/9/96 | ADDED INTERPRETATION | DLL | | |
|------------|---|----------|---------------------------|-----|--|--|
| Albite | B | 14/10/96 | CHANGES TO INTERPRETATION | MCB | | |
| Chlorite | | | | | | |
| Carbonate | | | | | | |
| Epidote | | | | | | |
| Feldspar | | | | | | |
| Fuchsite | | | | | | |
| Hemolite | | | | | | |
| Illite | | | | | | |
| Pyrite | | | | | | |
| Sericite | | | | | | |
| Silica | | | | | | |
| Tremolite | | | | | | |

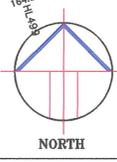

| | | |
|-------------|-------|----------|
| SCALE | 1:500 | |
| DRAWN | SFM | 24/05/96 |
| CHECKED | AM | 18/10/96 |
| DESIGNED | RDH | |
| DESIGN CKD | | |
| DESIGN APP | | |
| PROJECT APP | | |

Aberfoyle Resources Limited
HELLYER DIVISION
A.C.N. 004 664 108

GEOLOGY SECTION
10 947.5 N
SECTION LIMITS 10940.0 TO 10955.0

| | |
|-------------|-----------|
| DRAWING No. | GS-950-01 |
| REVISION | |