



0406-042

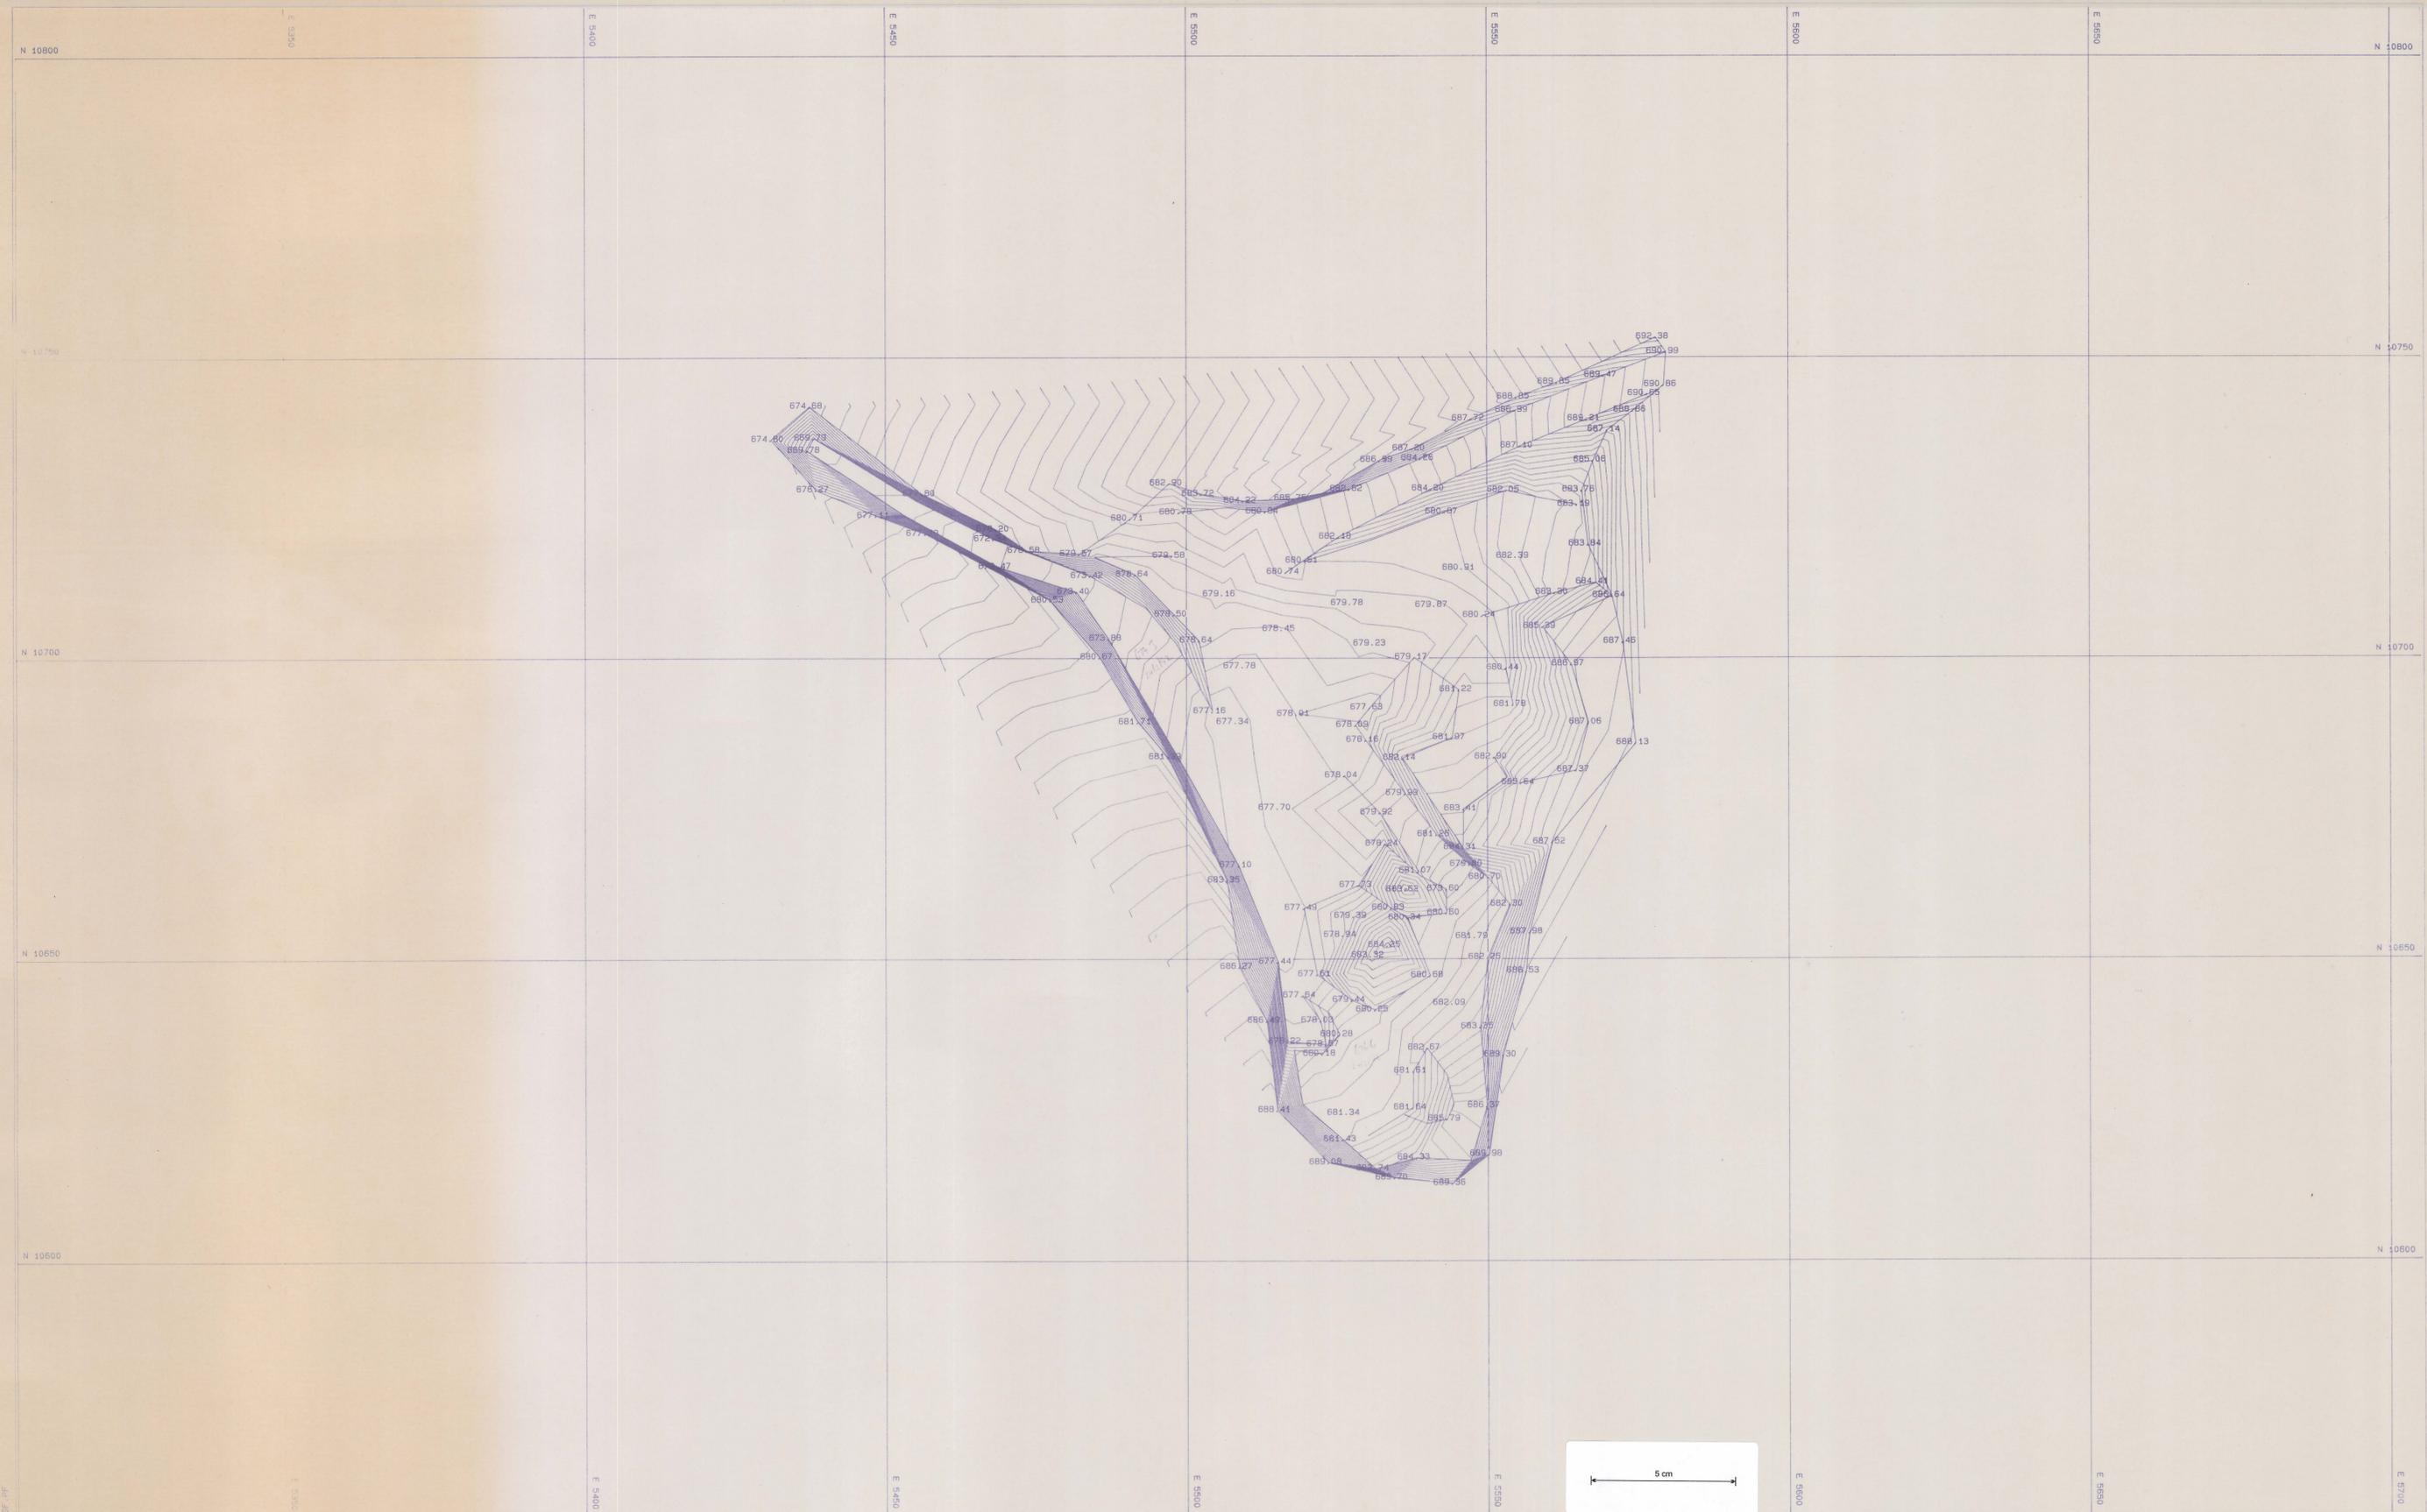

SURFAC SOFTWARE INTERNATIONAL AUSTRALIA

REV	DATE	REVISION	DRAWN	CHKD	APP	APP
1	24-2-92	NEW FLOOR SURVEY	DAS	PL	20e92	

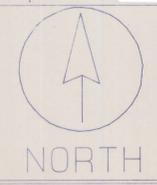

SCALE 1:500		
DRAWN	DAS	24-JUL-91
CHECKED	PL	
DESIGNED		
DESIGN CKD.		
DESIGN APP.		
PROJECT APP.		

ABERFOYLE RESOURCES LTD.
 HELLYER DIVISION
 SHALE PIT
 EXCAVATION SURVEY
 LEN MCKENZIE - 17/7/91

Drawing No. 0.5m CONT'S
 REVISION