



0406-051

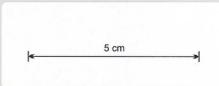

REV	DATE	REVISION	DRAWN	CKD	APP	APP
1	17-1-88	UPDATE TO 1988	C.P.			
2	14-2-92	" " 1992	D.S.			
3	14-4-93	" " 1993	D.S.			

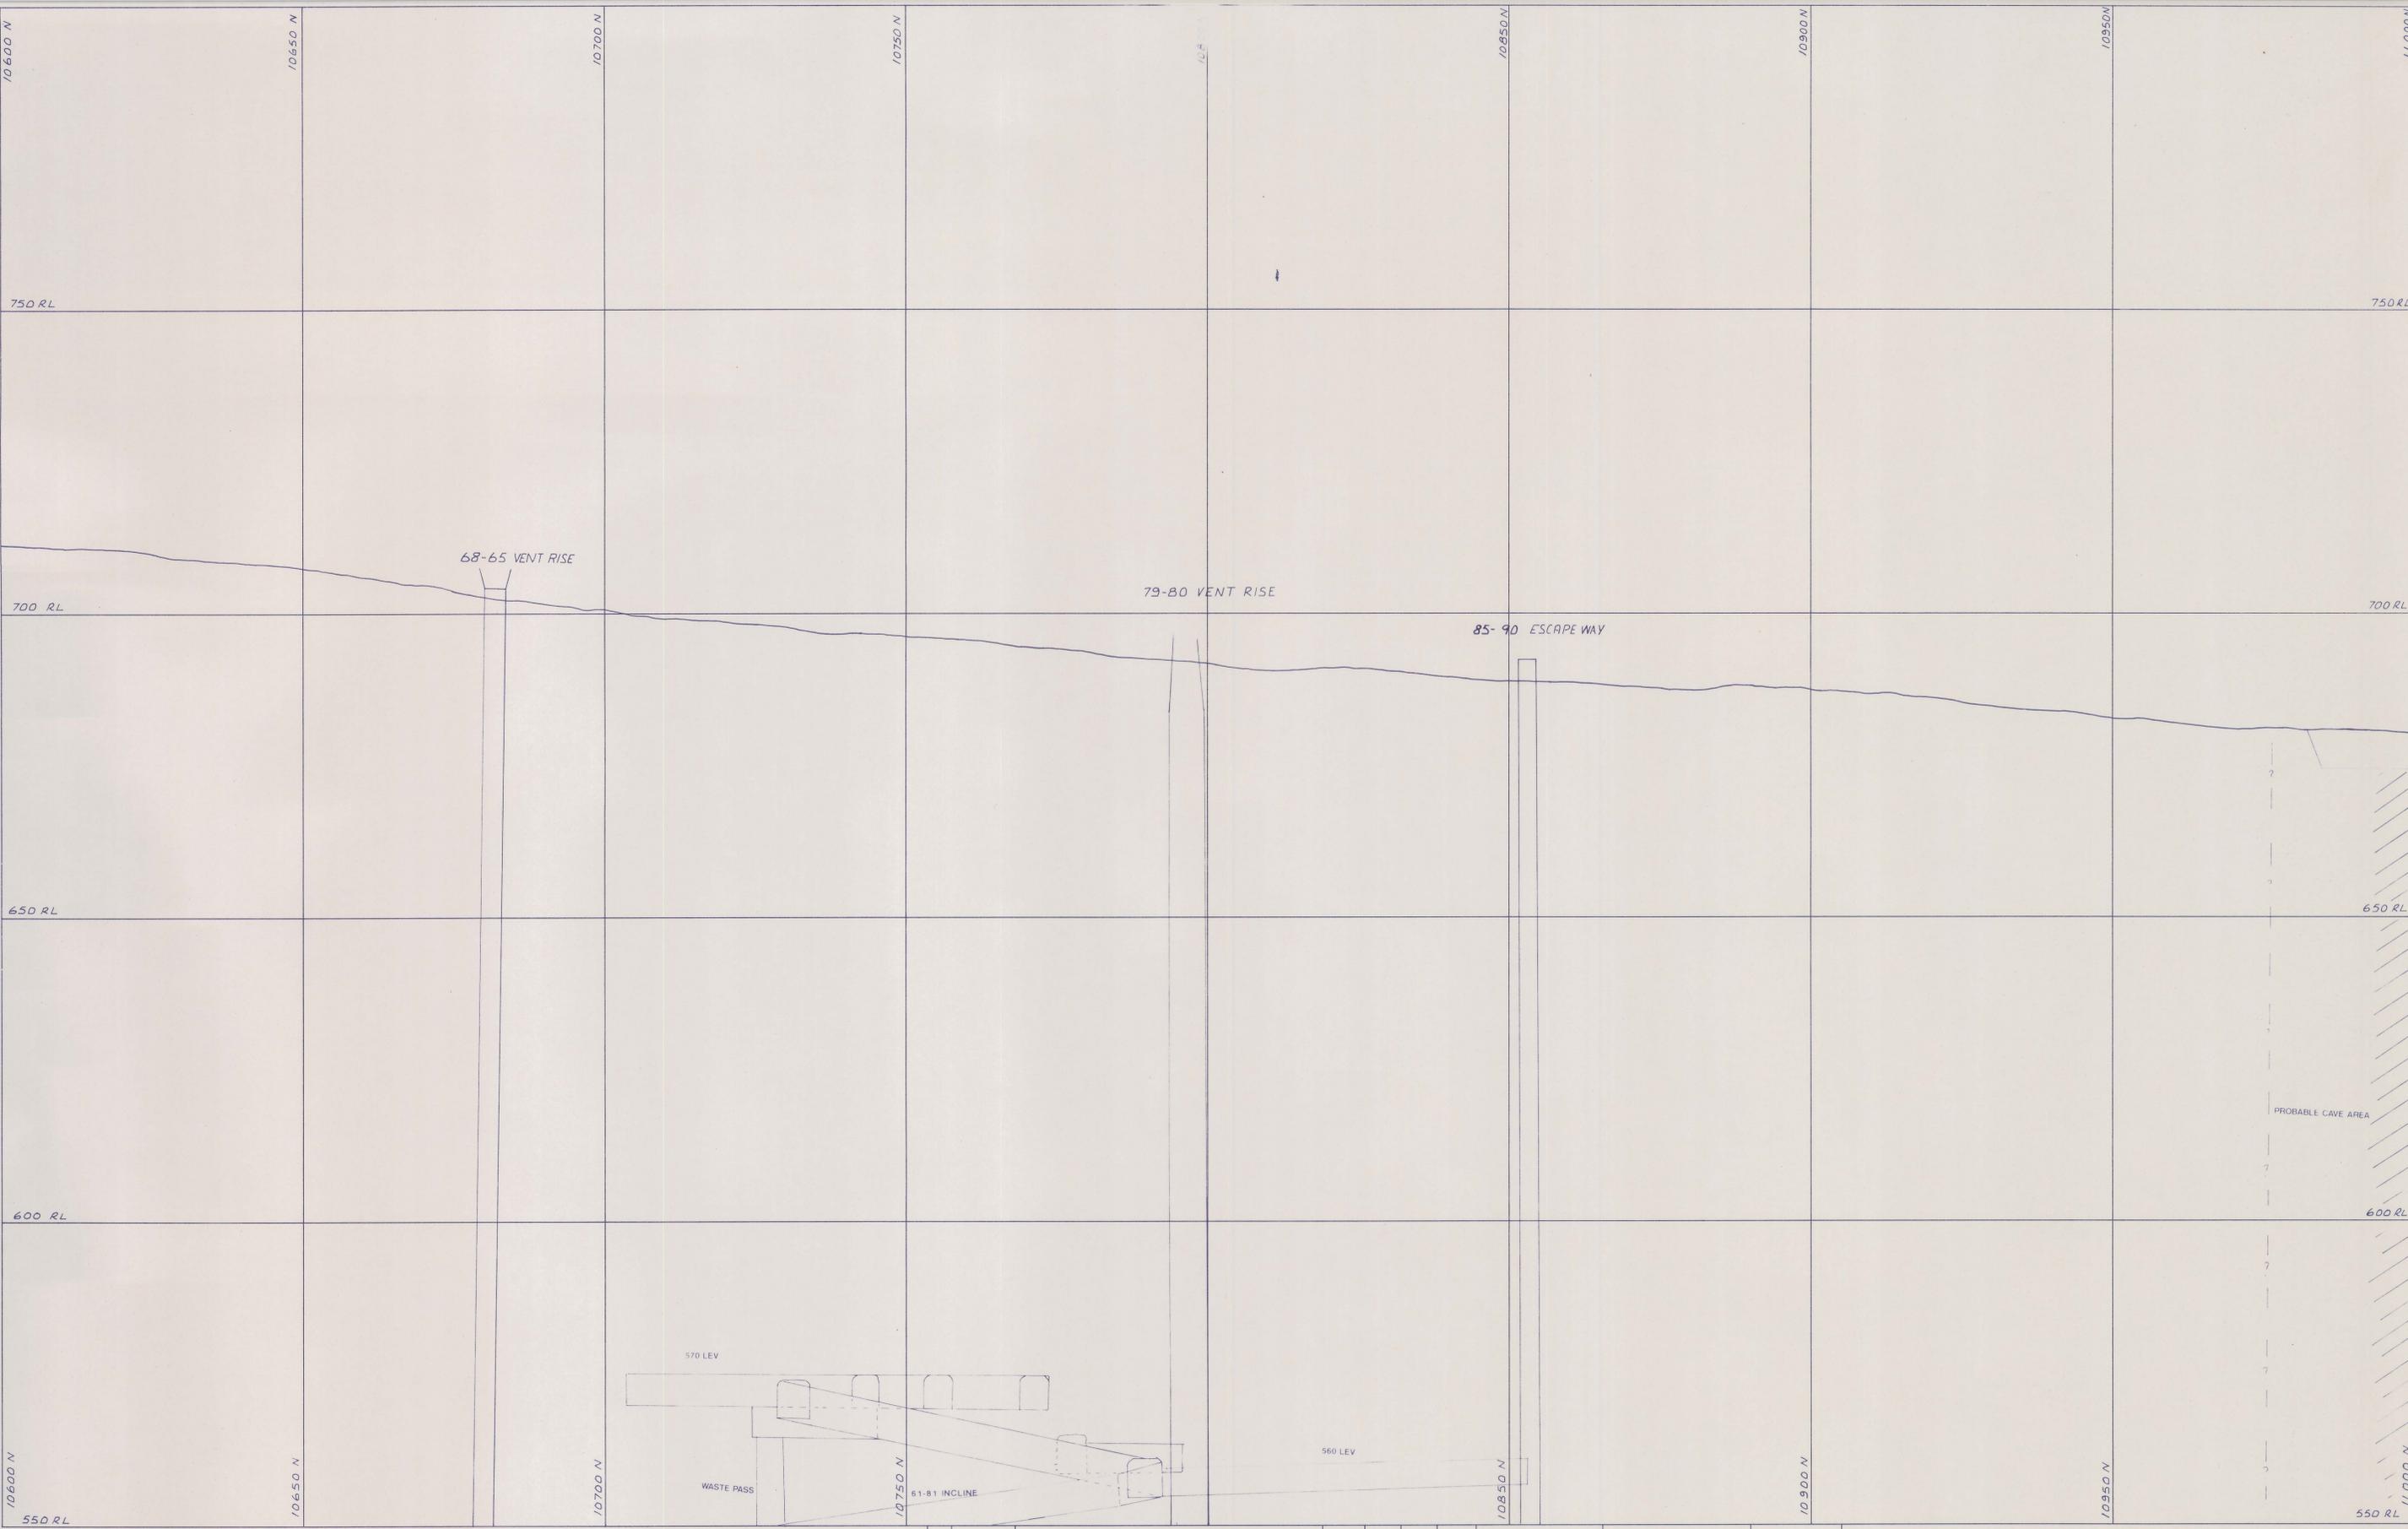

SCALE 1:500		
DRAWN	C.P.	FEB '87
CHECKED		
DESIGNED		
DESIGN CKD		
DESIGN APP		
PROJECT APP		

Aberfoyle Resources Limited
HILLYER DIVISION

LONGITUDINAL SECTION

DRAWING NO. HEL-010-1143	REVISION
------------------------------------	----------