


0406 - 052

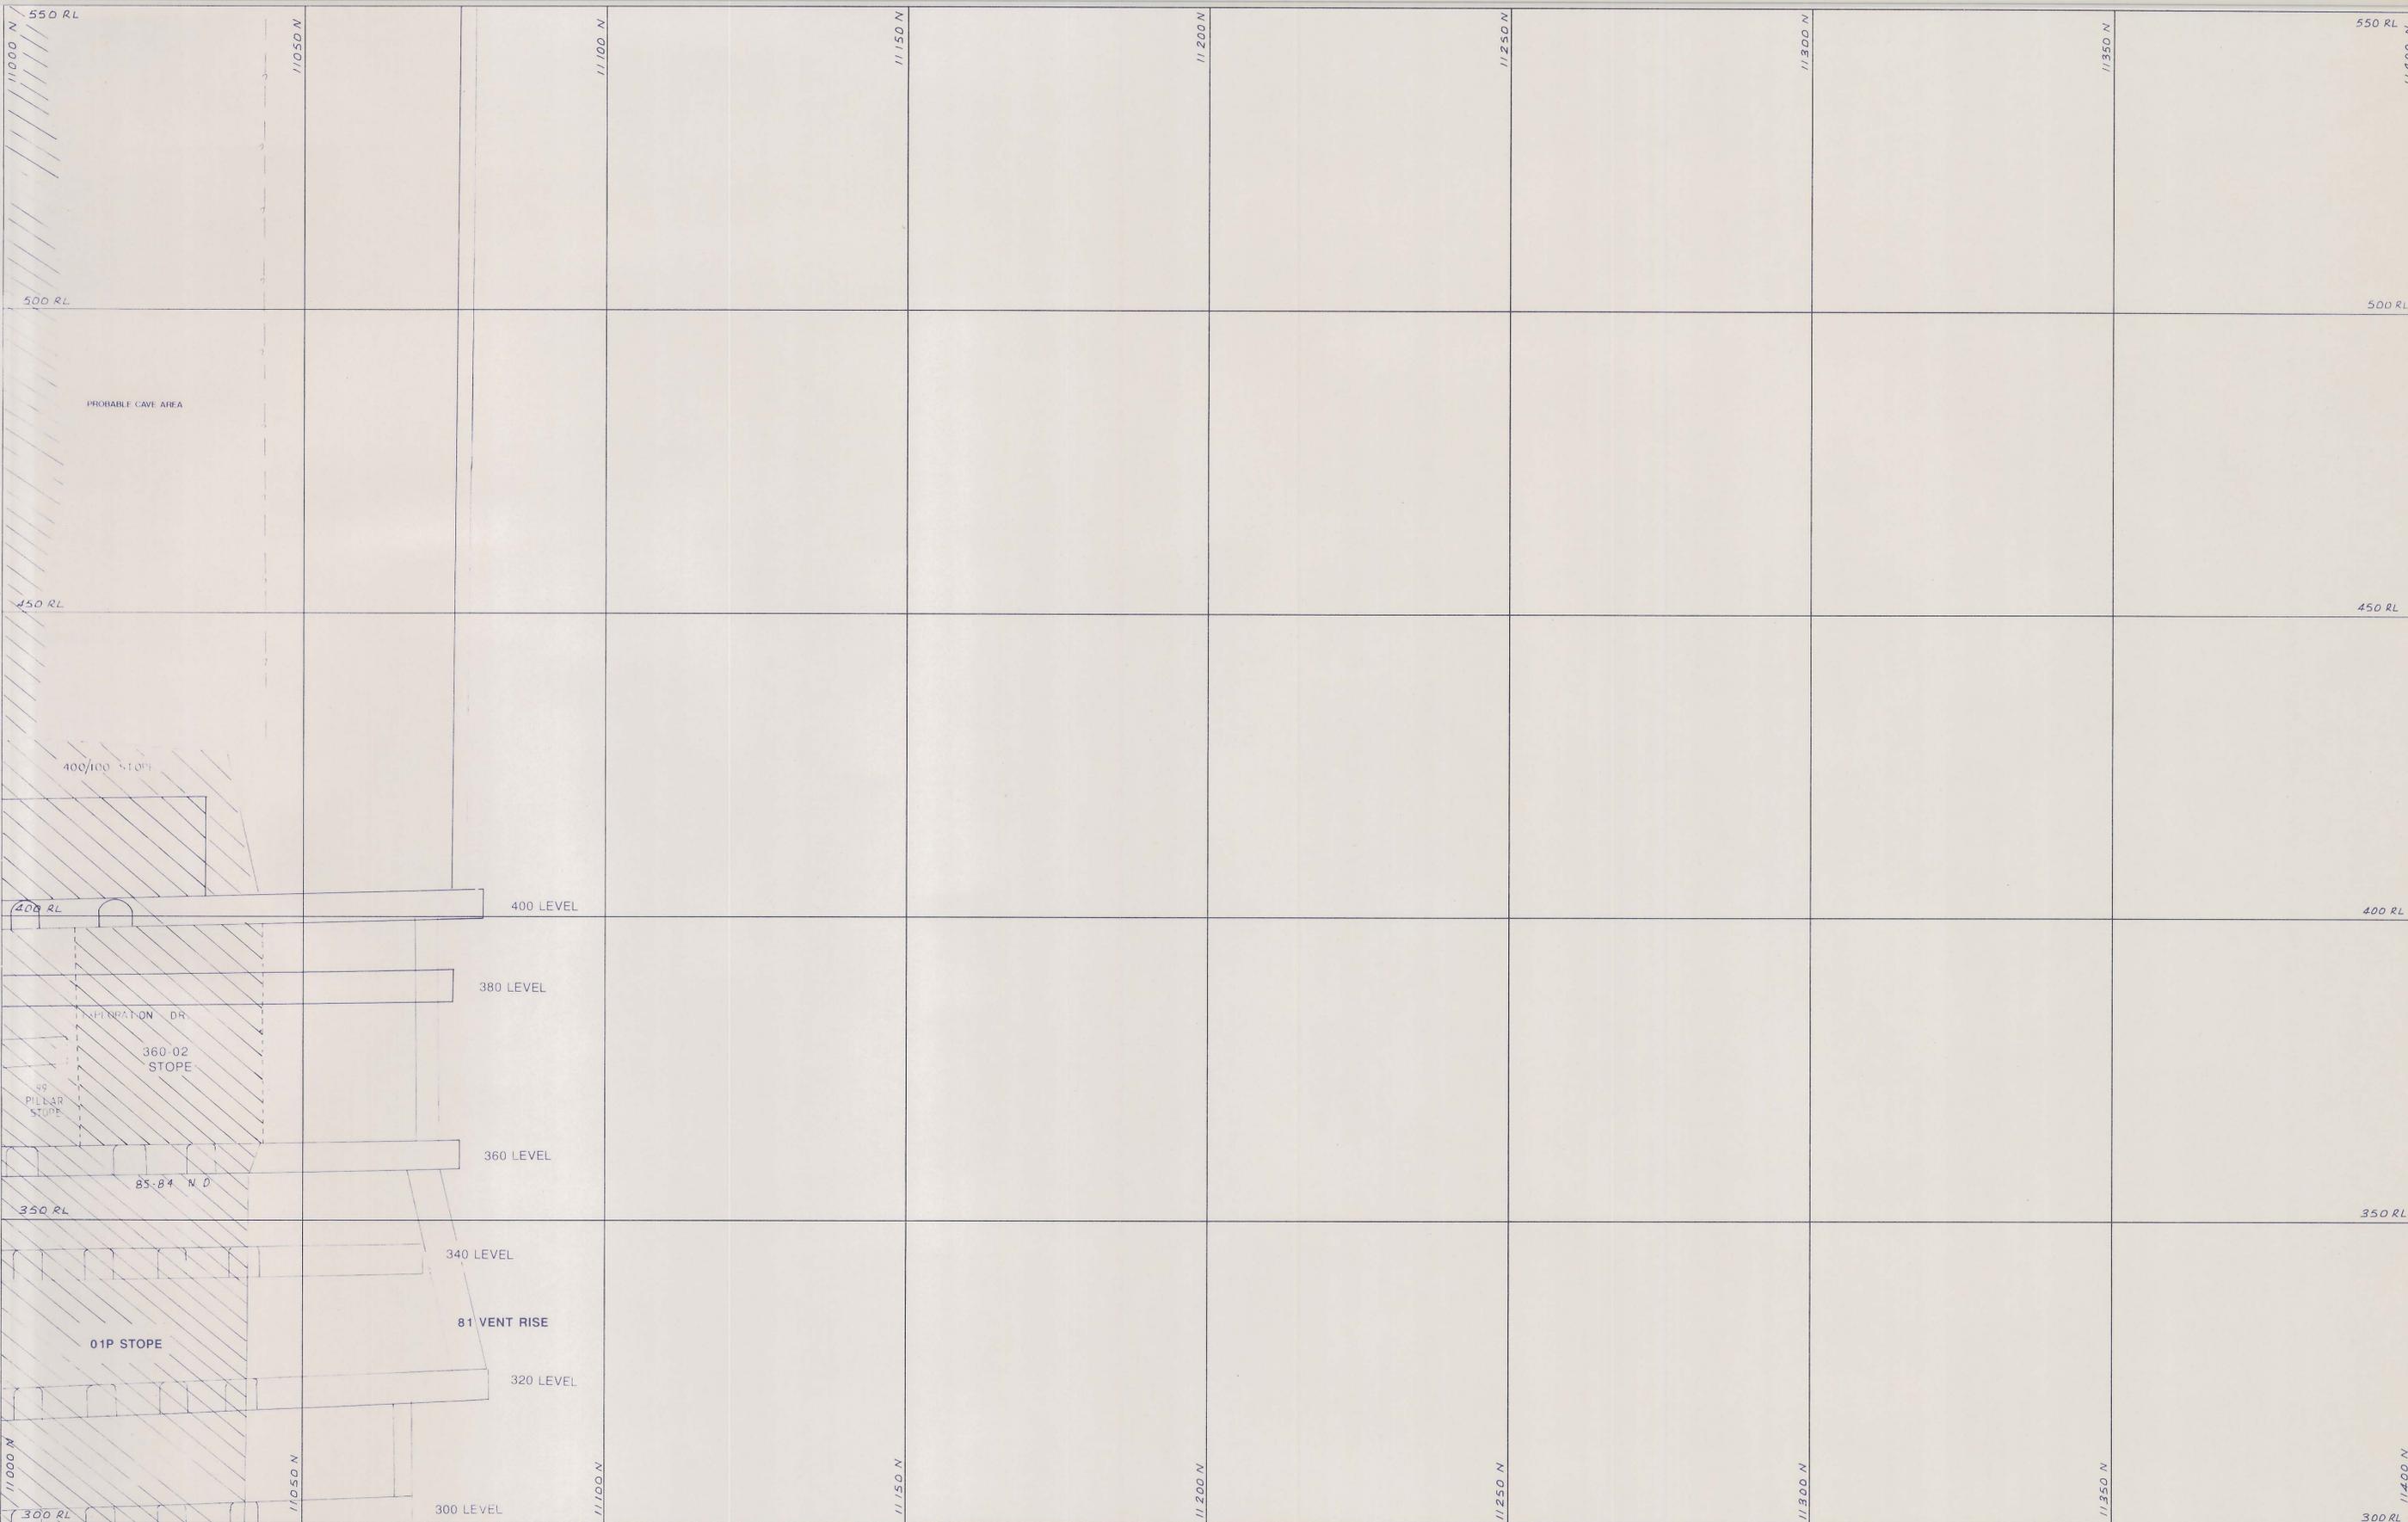


REV	DATE	REVISION	DRAWN	CKD	APP	APP
1	17-1-88	UPDATE TO 1988	C.P.			
2	29-3-89	" " 1989	C.P.			
3	28-12-89	" " 1990	C.P.			
4	13-4-91	" " 1991	D.S.			
5	4-2-92	" " 1992	D.S.			
6	14-4-93	" " 1993	D.S.			

SCALE 1:500

DRAWN	C.P.	FEB '87
CHECKED		
DESIGNED		
DESIGN APP		
PROJECT APP		

NORTH

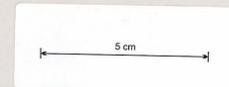

Aberfoyle Resources Limited
HULLYER DIVISION

LONGITUDINAL SECTION

DRAWING NO. HEL-010-1149

REVISION