


0406-059

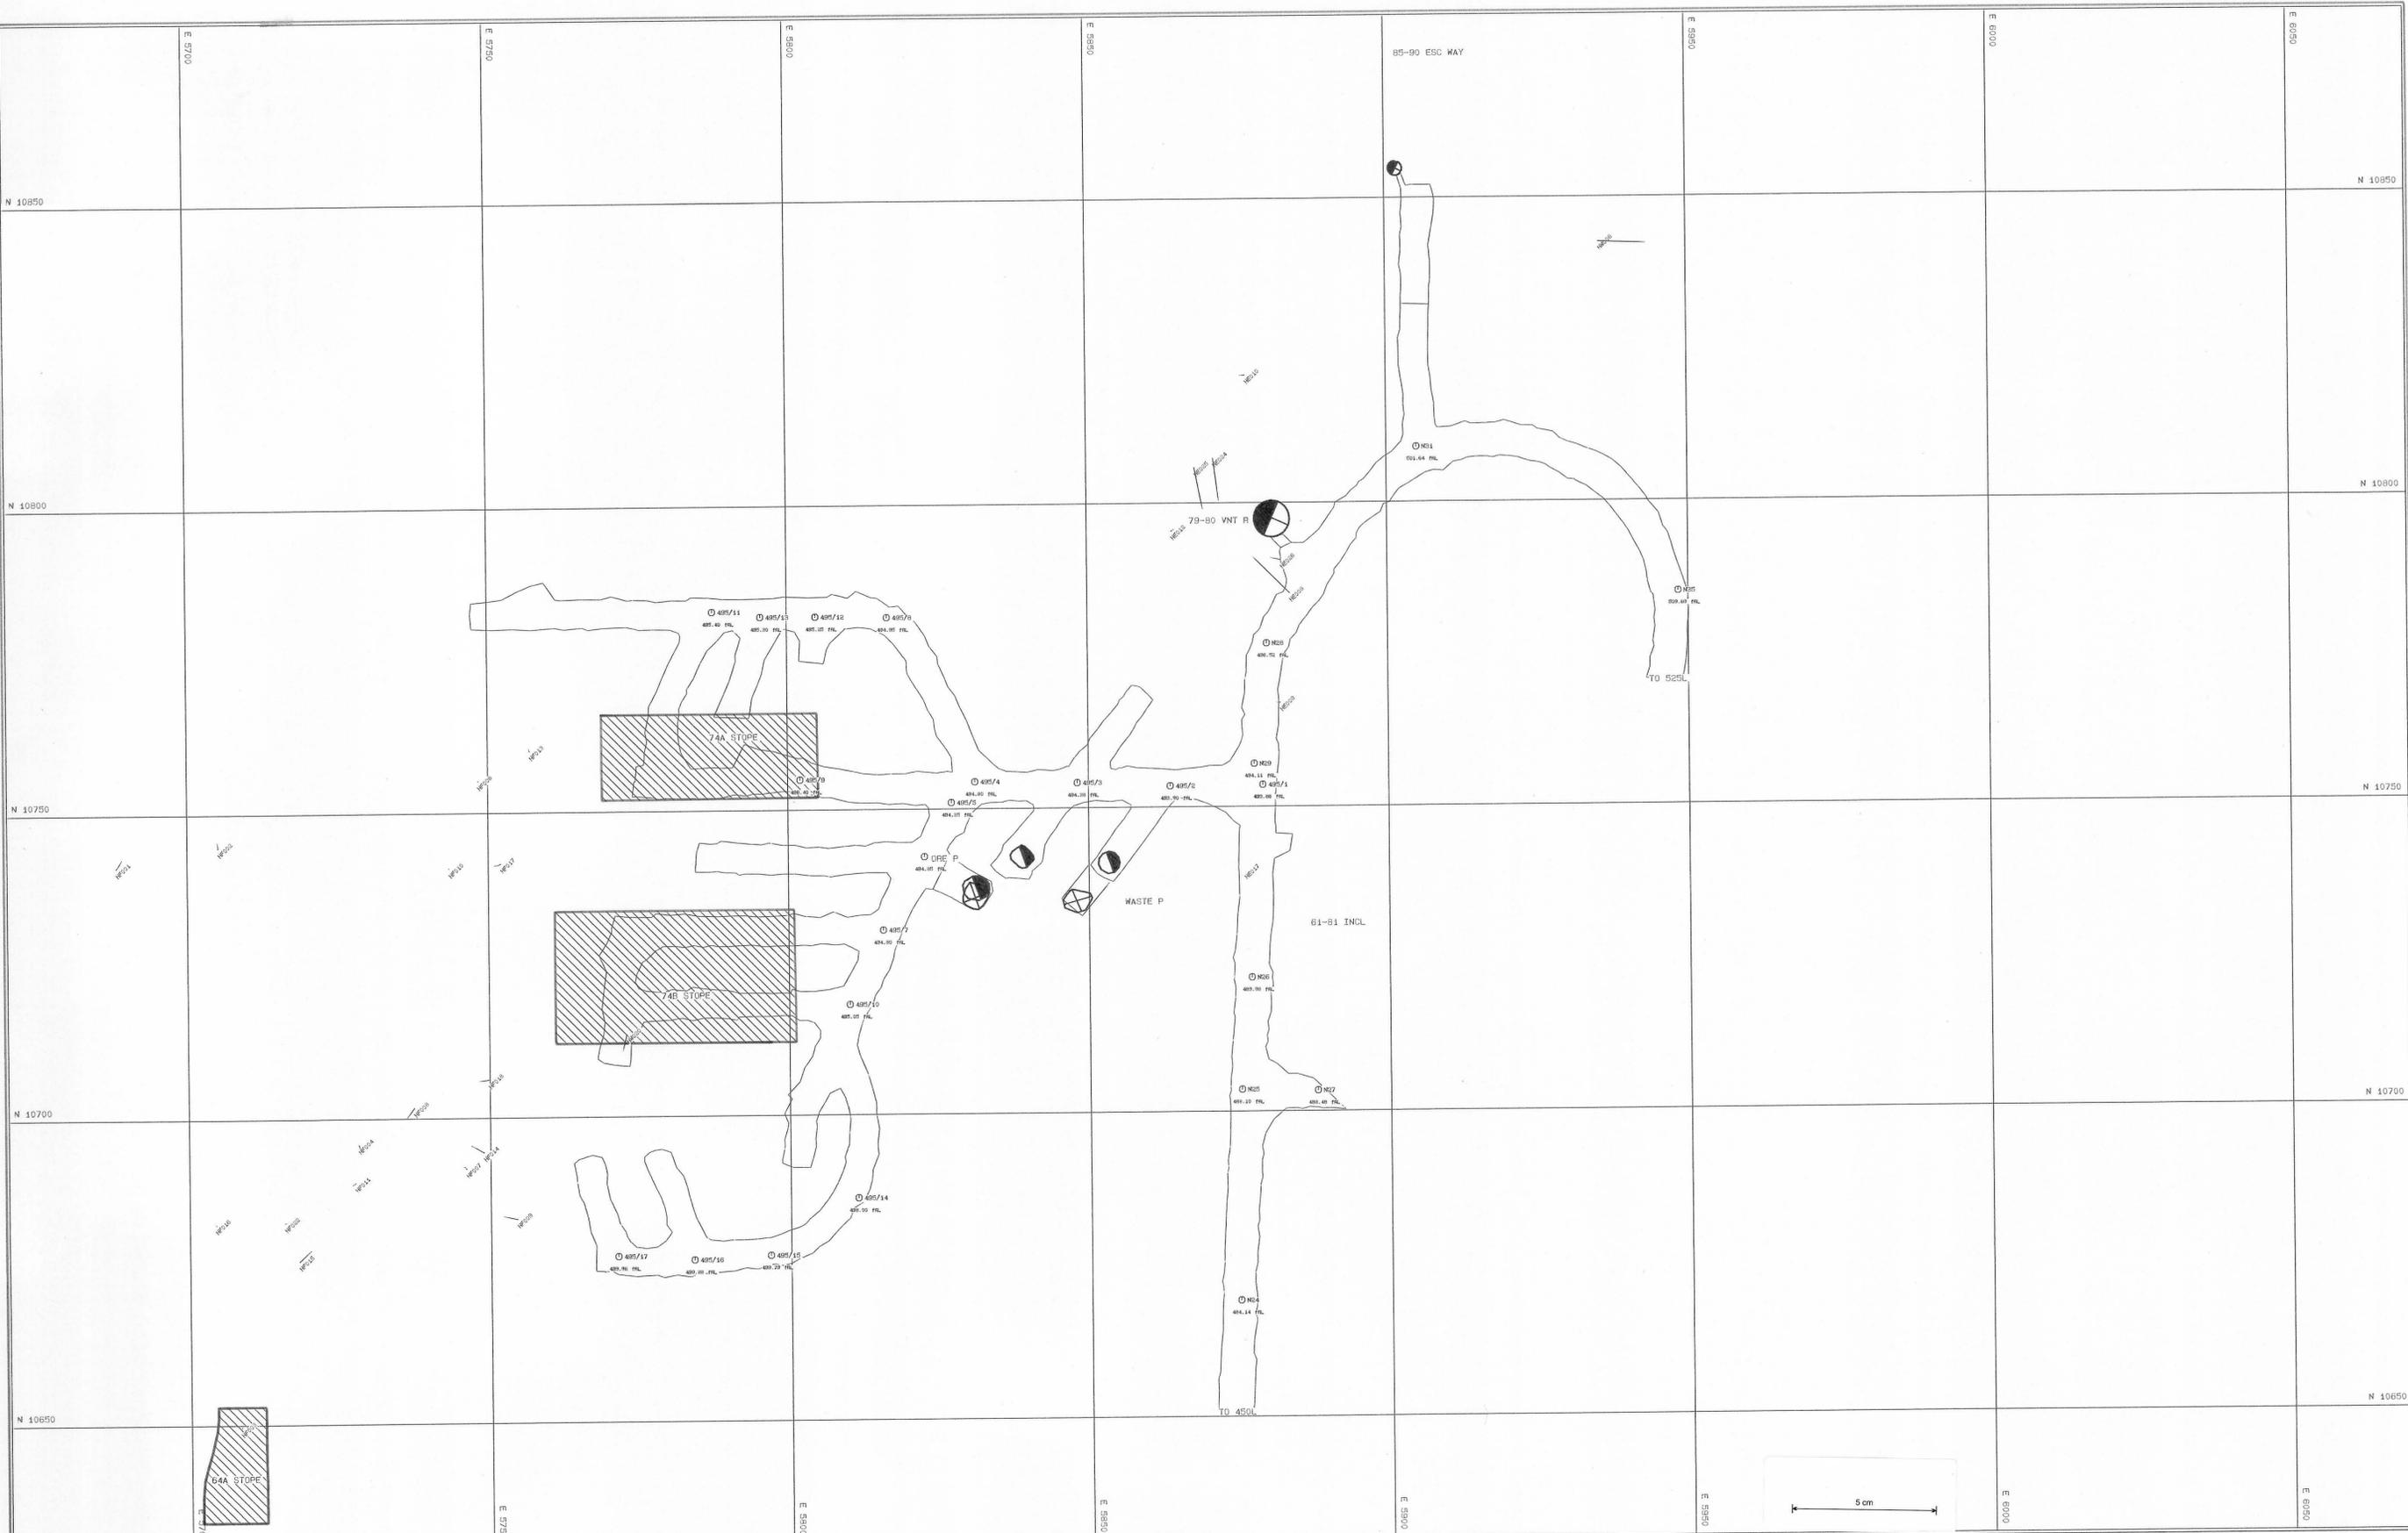

KEY

- HP = PROBE HOLE
- HA = COMP. AIR HOLE
- HV = VENT HOLE
- HE = ELECTRICAL HOLE
- HW = WATER HOLE
- HF = FILL HOLE

REV	DATE	REVISION	DRAWN	CHK	APP	APP



SCALE 1: 500

DRAWN	DS-AS	15-MAR-93
CHECKED	<i>[Signature]</i>	5-3-93
DESIGNED		
DESIGN CRD.		
DESIGN APP.		
PROJECT APP.		

**ABERFOYLE RESOURCES LTD.**  
**HELLYER DIVISION**

**HELLYER MINE**  
**LEVEL PLAN**  
**495m HORIZON**

Drawing No. HEL  
 REVISION