


0406-060

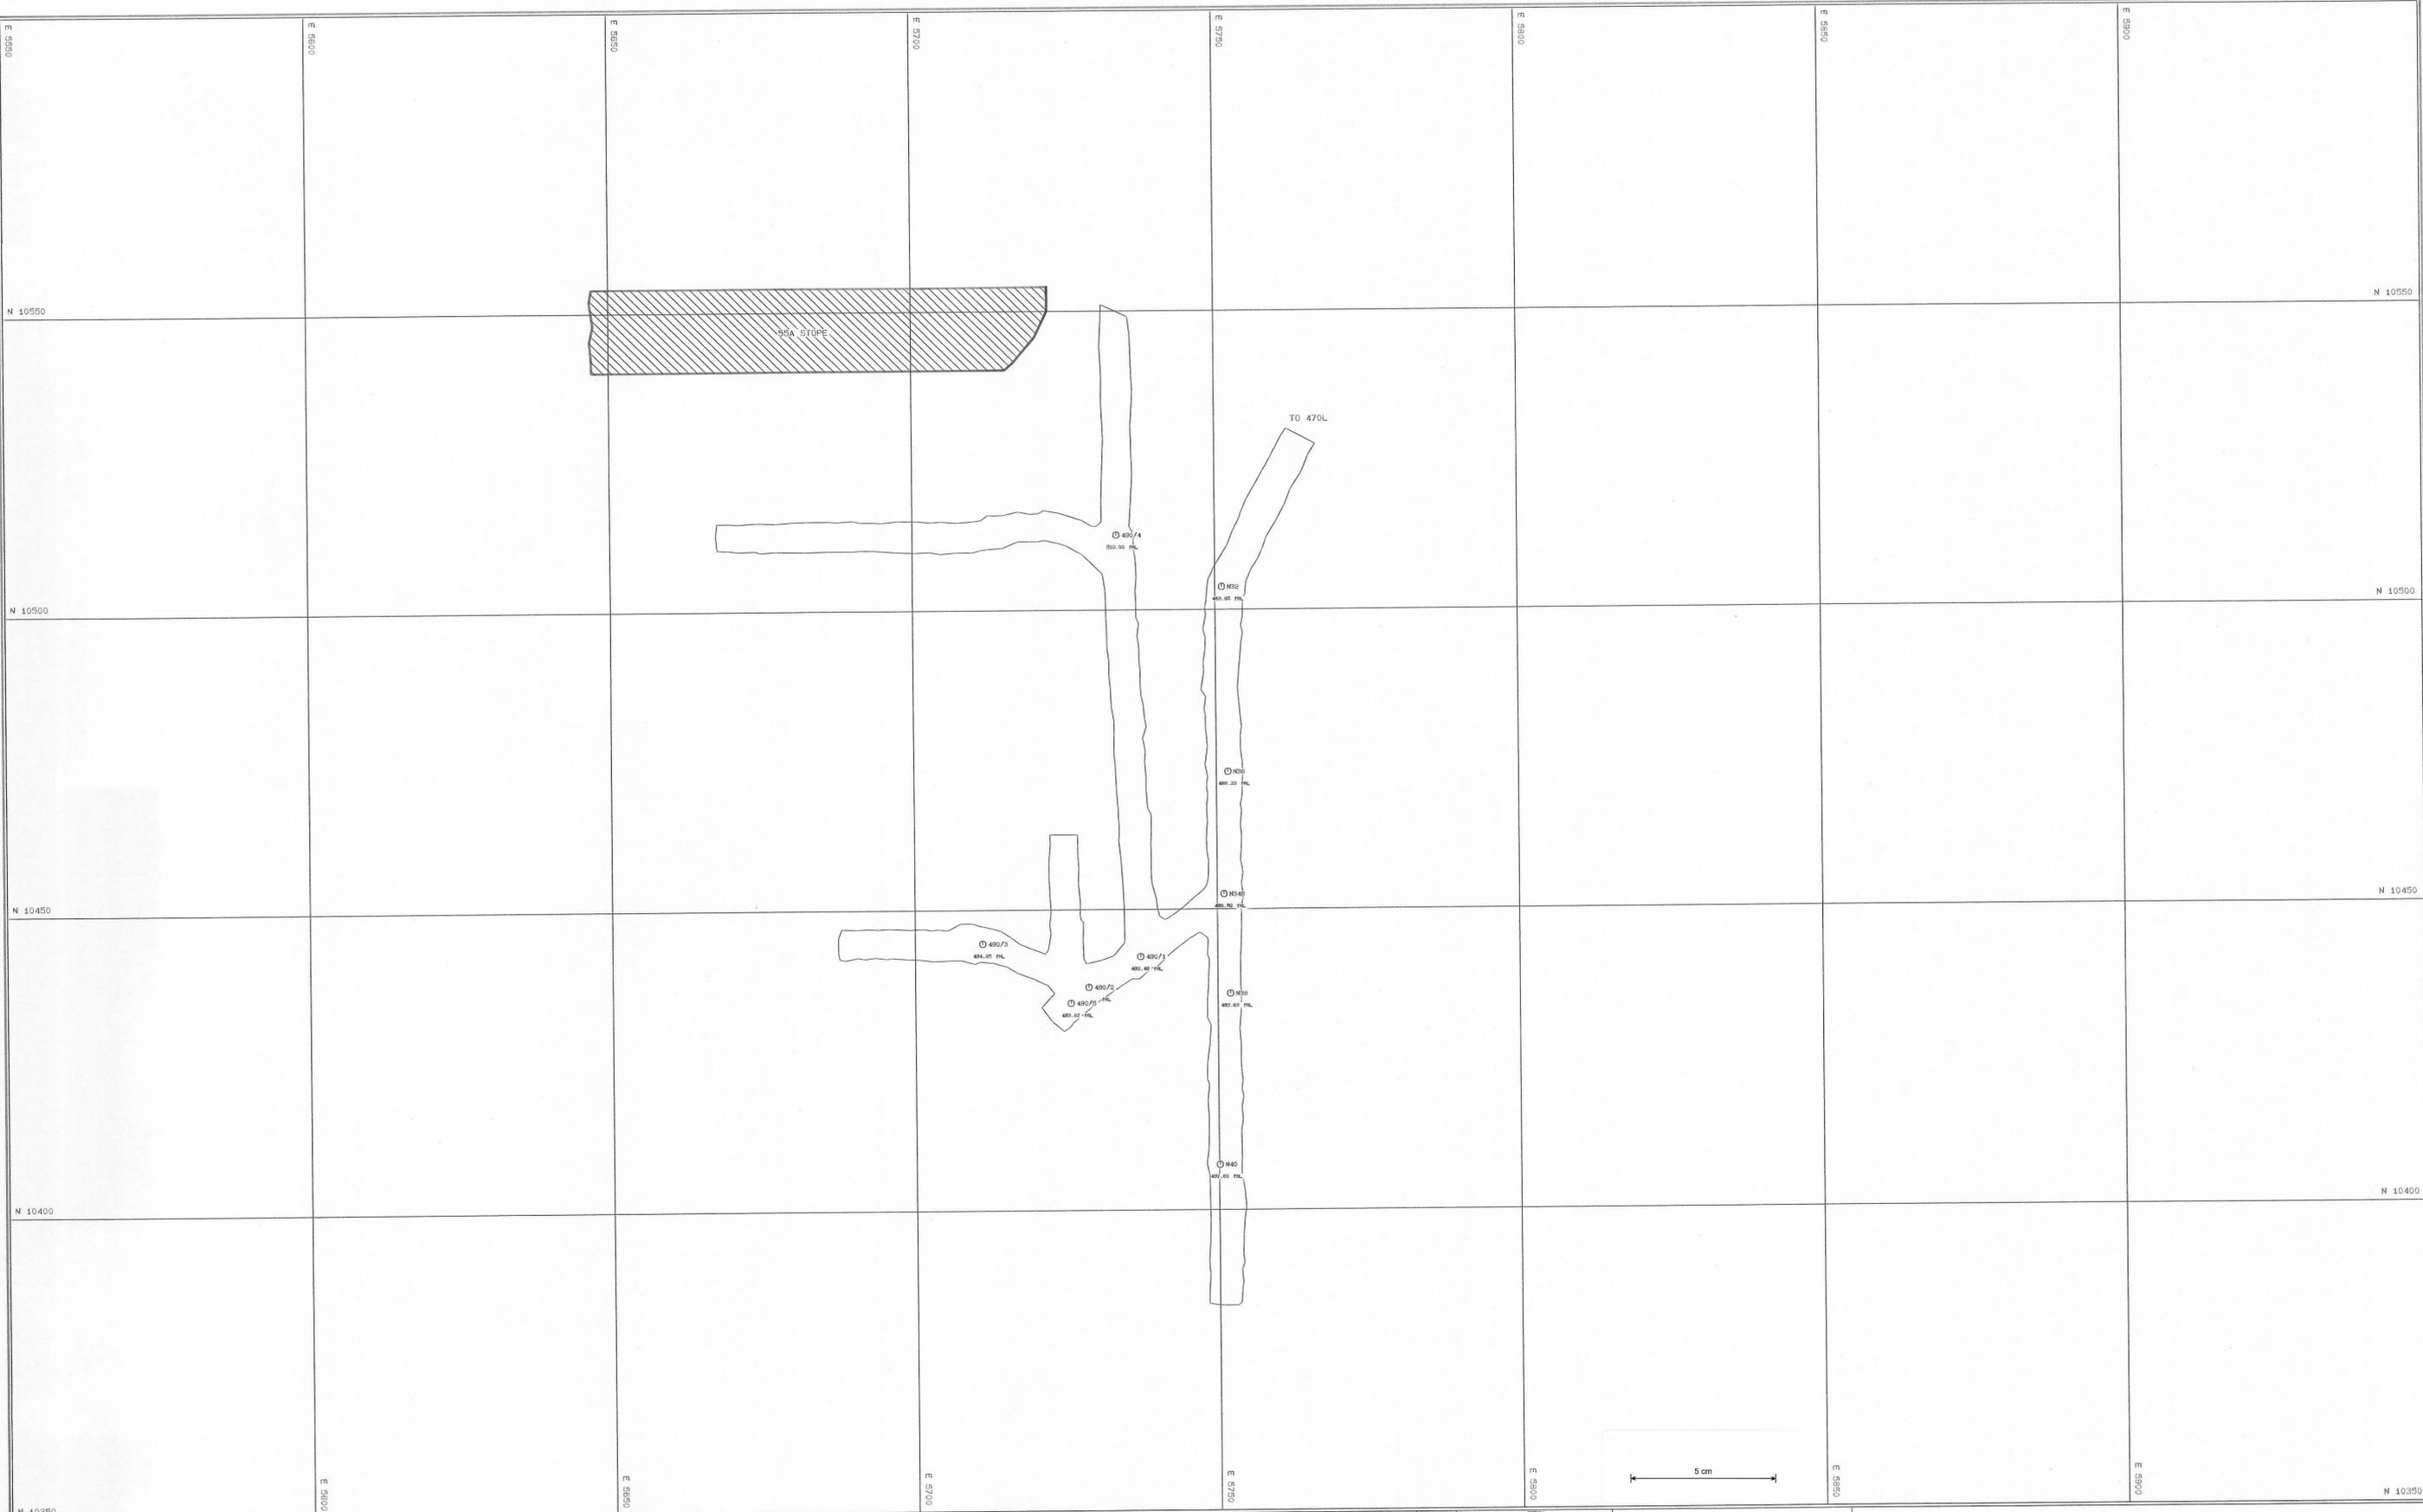

- KEY**
- HP = PROBE HOLE
 - HA = COMP. AIR HOLE
 - HV = VENT HOLE
 - HE = ELECTRICAL HOLE
 - HW = WATER HOLE
 - HF = FILL HOLE

REV	DATE	REVISION	DRAWN	CHKD	APP	APP



SCALE 1: 500

DRAWN	AKS	5-MAR-93
CHECKED	<i>PH</i>	5-3-93
DESIGNED		
DESIGN CKD.		
DESIGN APP.		
PROJECT APP.		

ABERFOYLE RESOURCES LTD.
HELLYER DIVISION

HELLYER MINE
 LEVEL PLAN
 490m HORIZON

Drawing No. HEL
 REVISION