


0406-068



- HP - PROBE HOLE
- HA - COMP. AIR HOLE
- HV - VENT HOLE
- HE - ELECTRICAL HOLE
- HW - WATER HOLE
- HF - FILL HOLE

REV	DATE	REVISION	DRAWN	CHKD	APP	APP

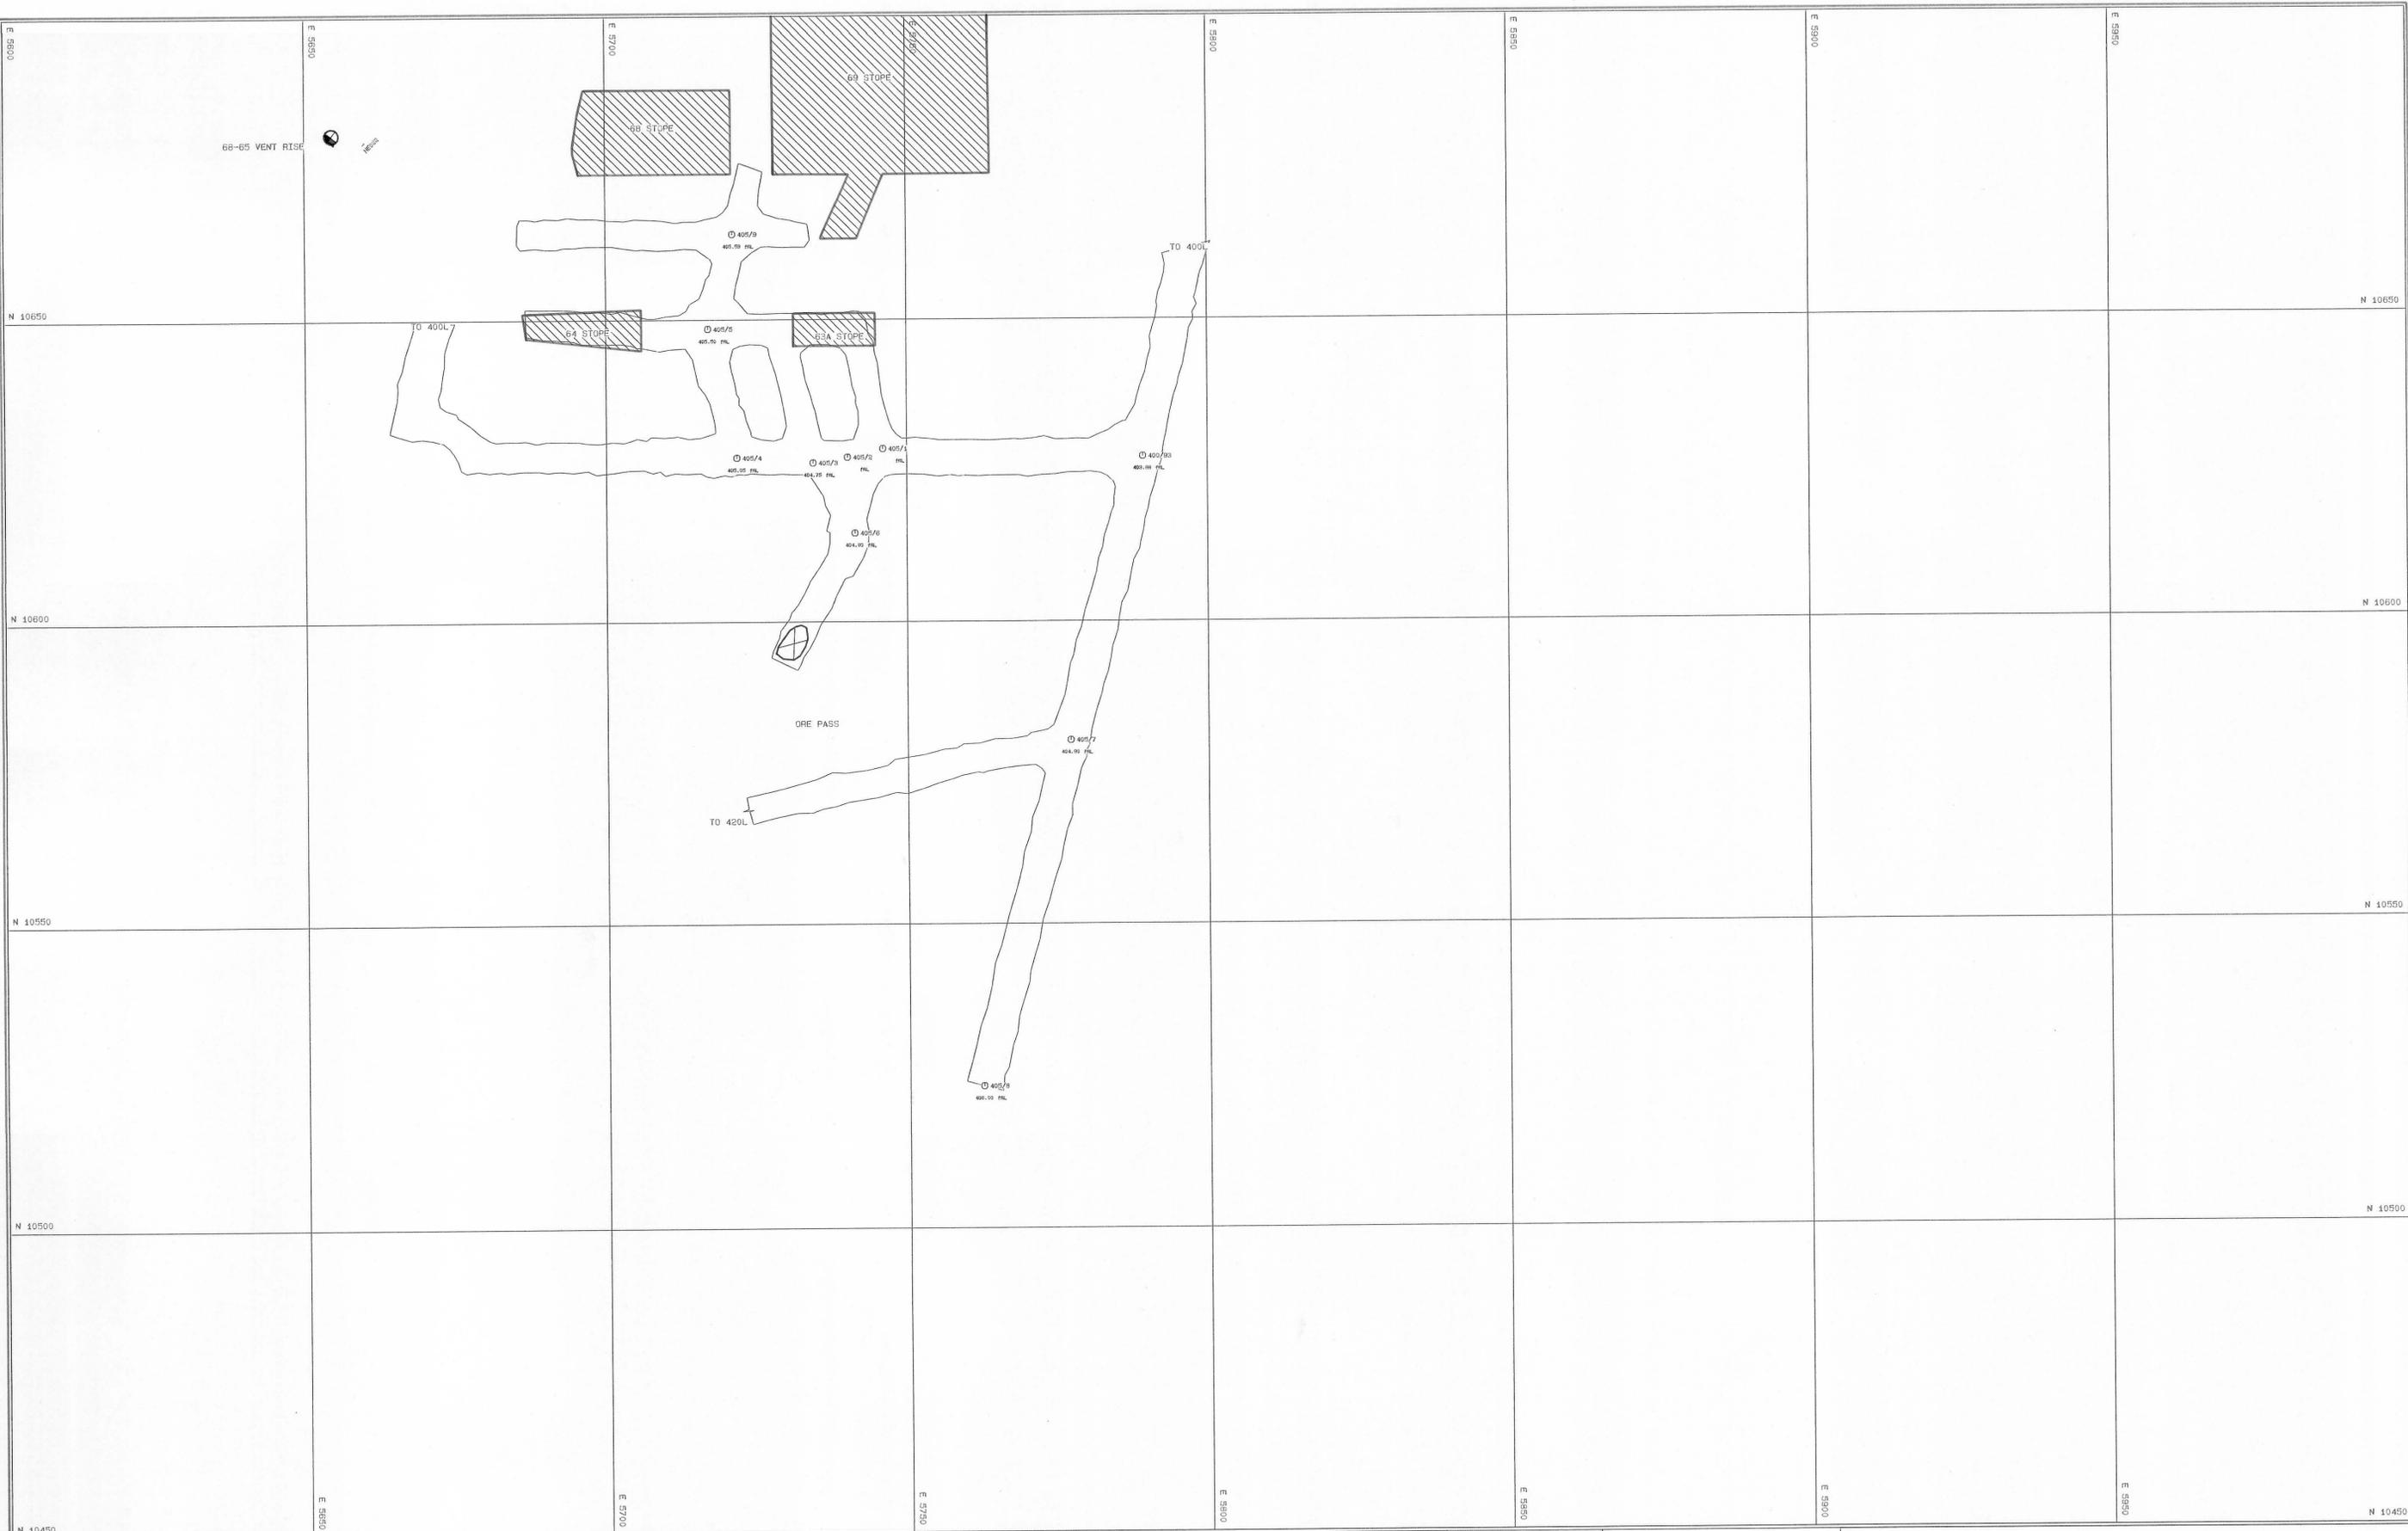

SCALE 1:500

DRAWN	ANS	5-MAR-93
CHECKED	<i>[Signature]</i>	5-5-93
DESIGNED		
DESIGN CKD.		
DESIGN APP.		
PROJECT APP.		

**ABERFOYLE RESOURCES LTD.**  
**HELLYER DIVISION**

HELLYER MINE  
LEVEL PLAN  
405m HORIZON

Drawing No.	HEL
REVISION	