


0406-076



KEY

- HP = PROBE HOLE
- HA = COMP. AIR HOLE
- HY = VENT HOLE
- HE = ELECTRICAL HOLE
- HW = WATER HOLE

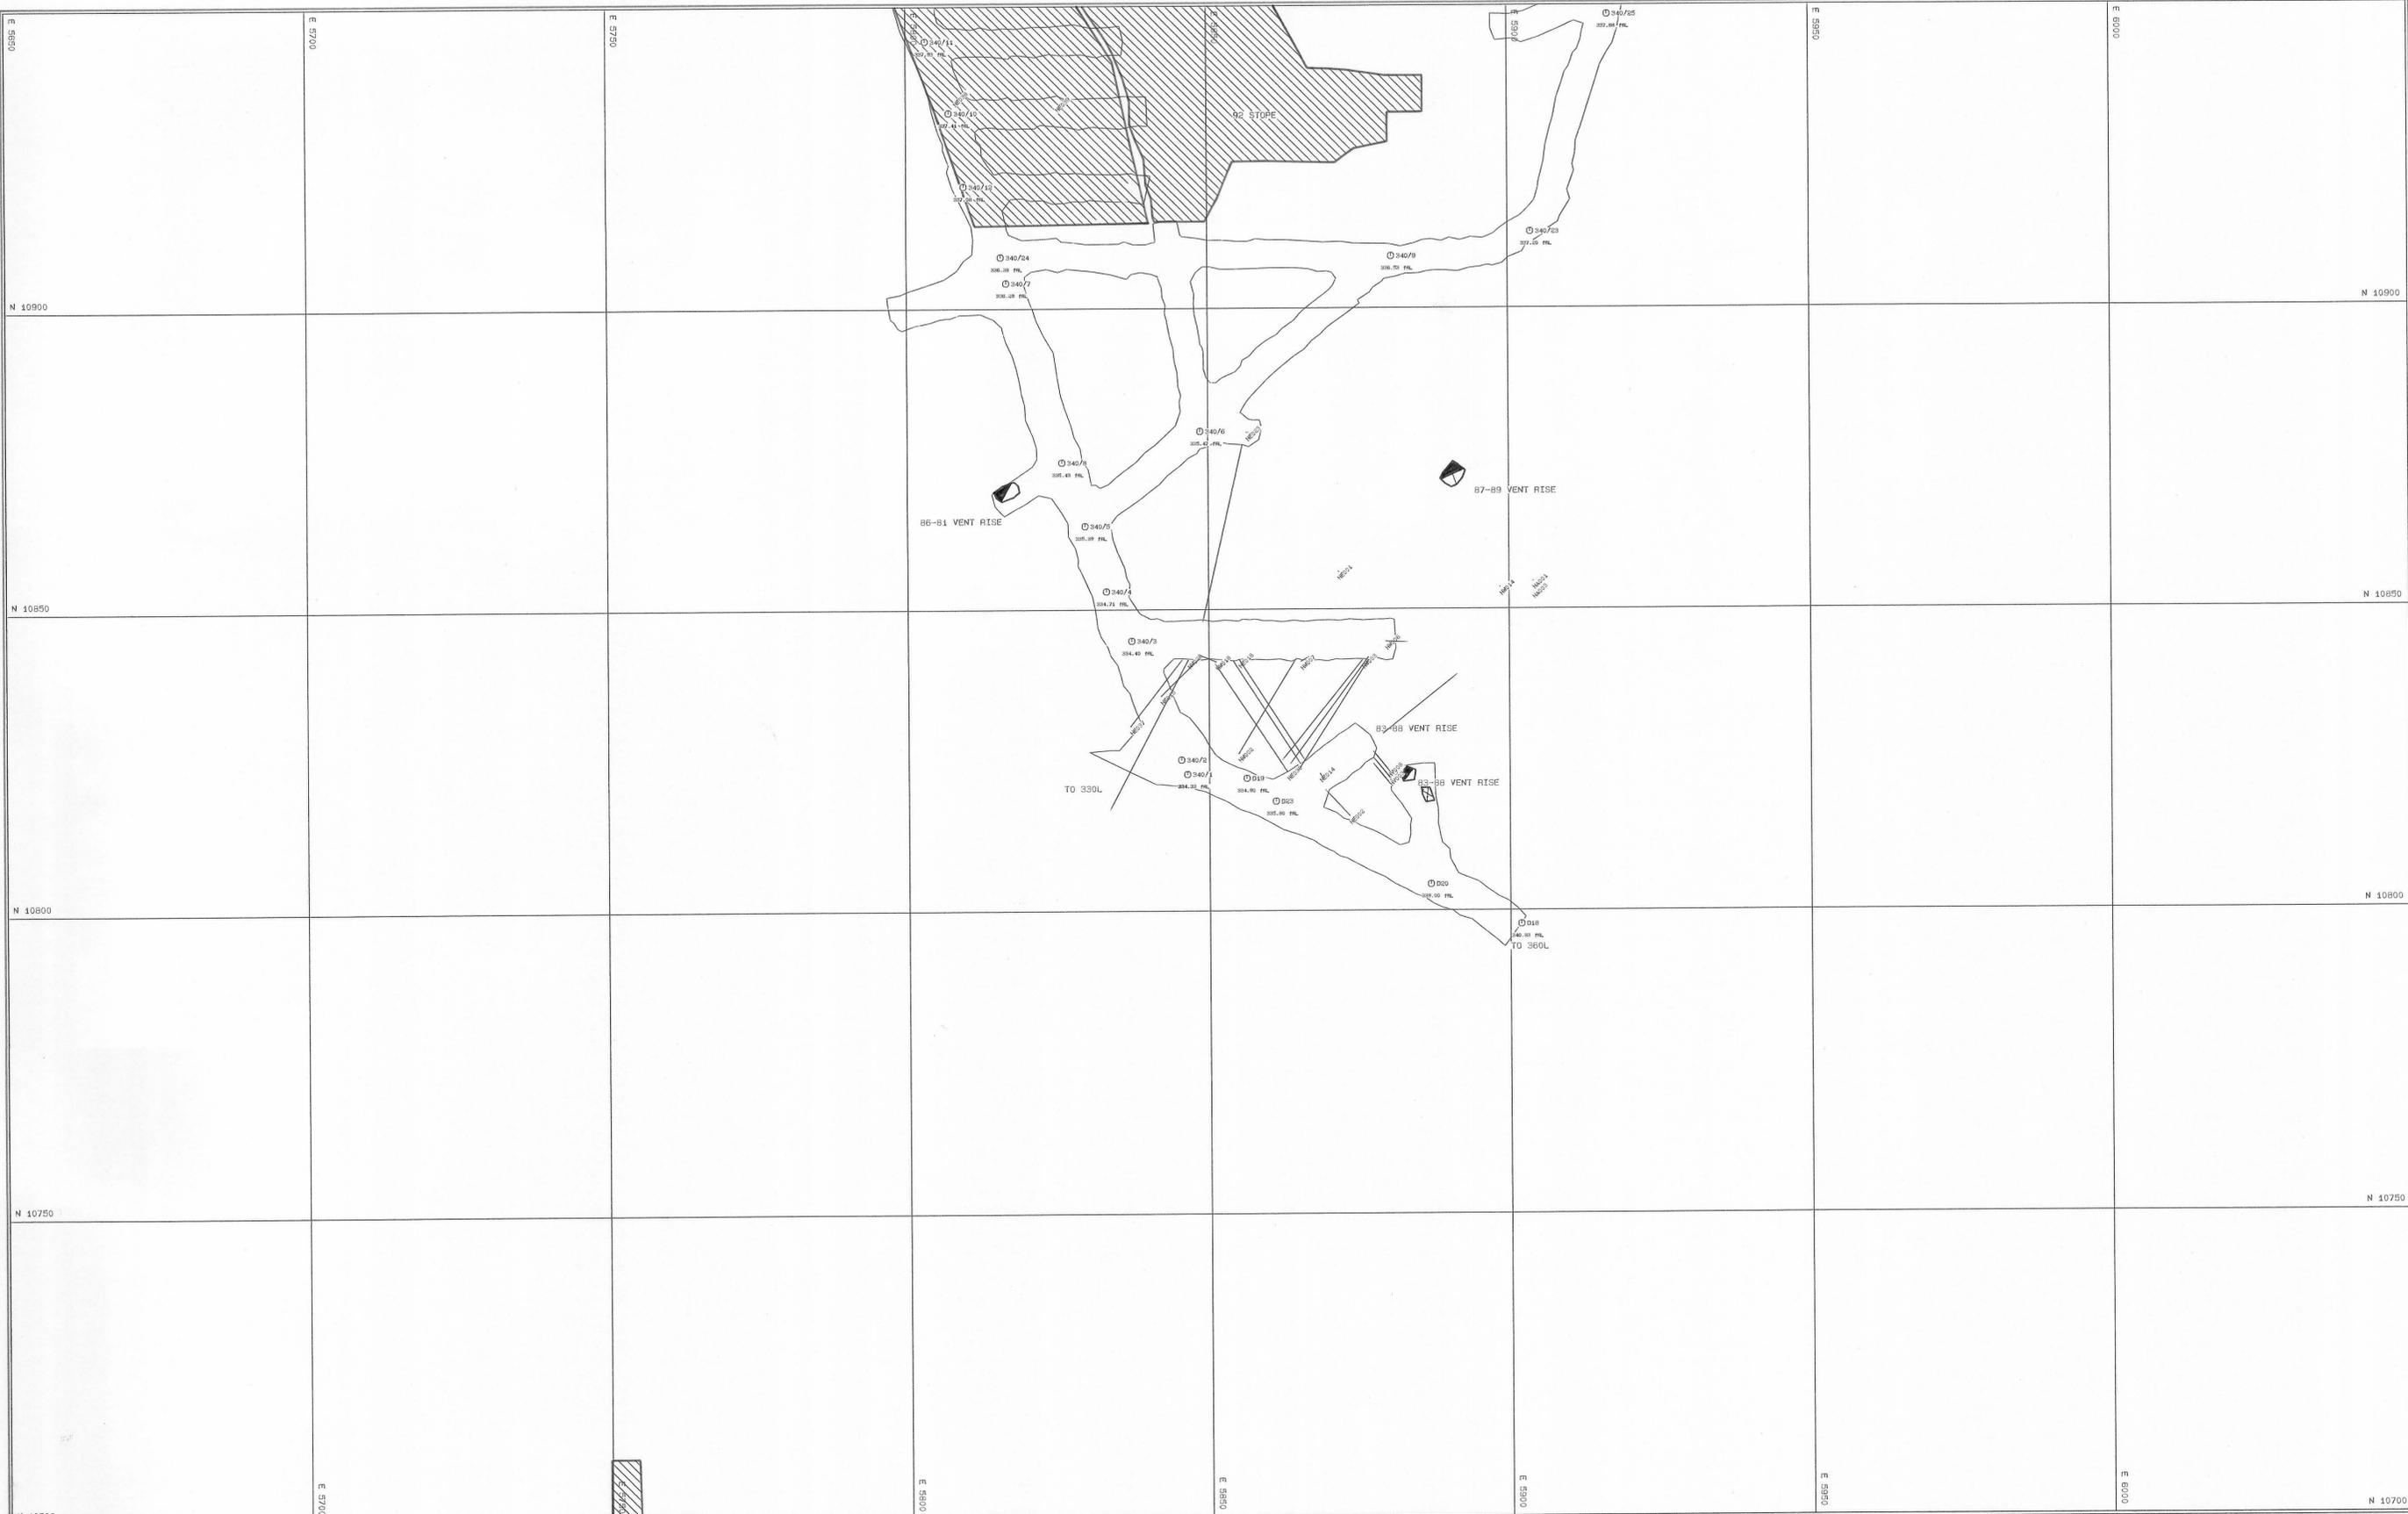

SCALE 1: 500

DRAWN	AMS	5-MAR-93
CHECKED	<i>RL</i>	5-3-93
DESIGNED		
DESIGN O.K.		
DESIGN APP.		

ABERFOYLE RESOURCES LTD.
HELLYER DIVISION

HELLYER MINE
 LEVEL PLAN
 340m HORIZON

Drawing No.	HEL
REVISION	