


0406 - 079

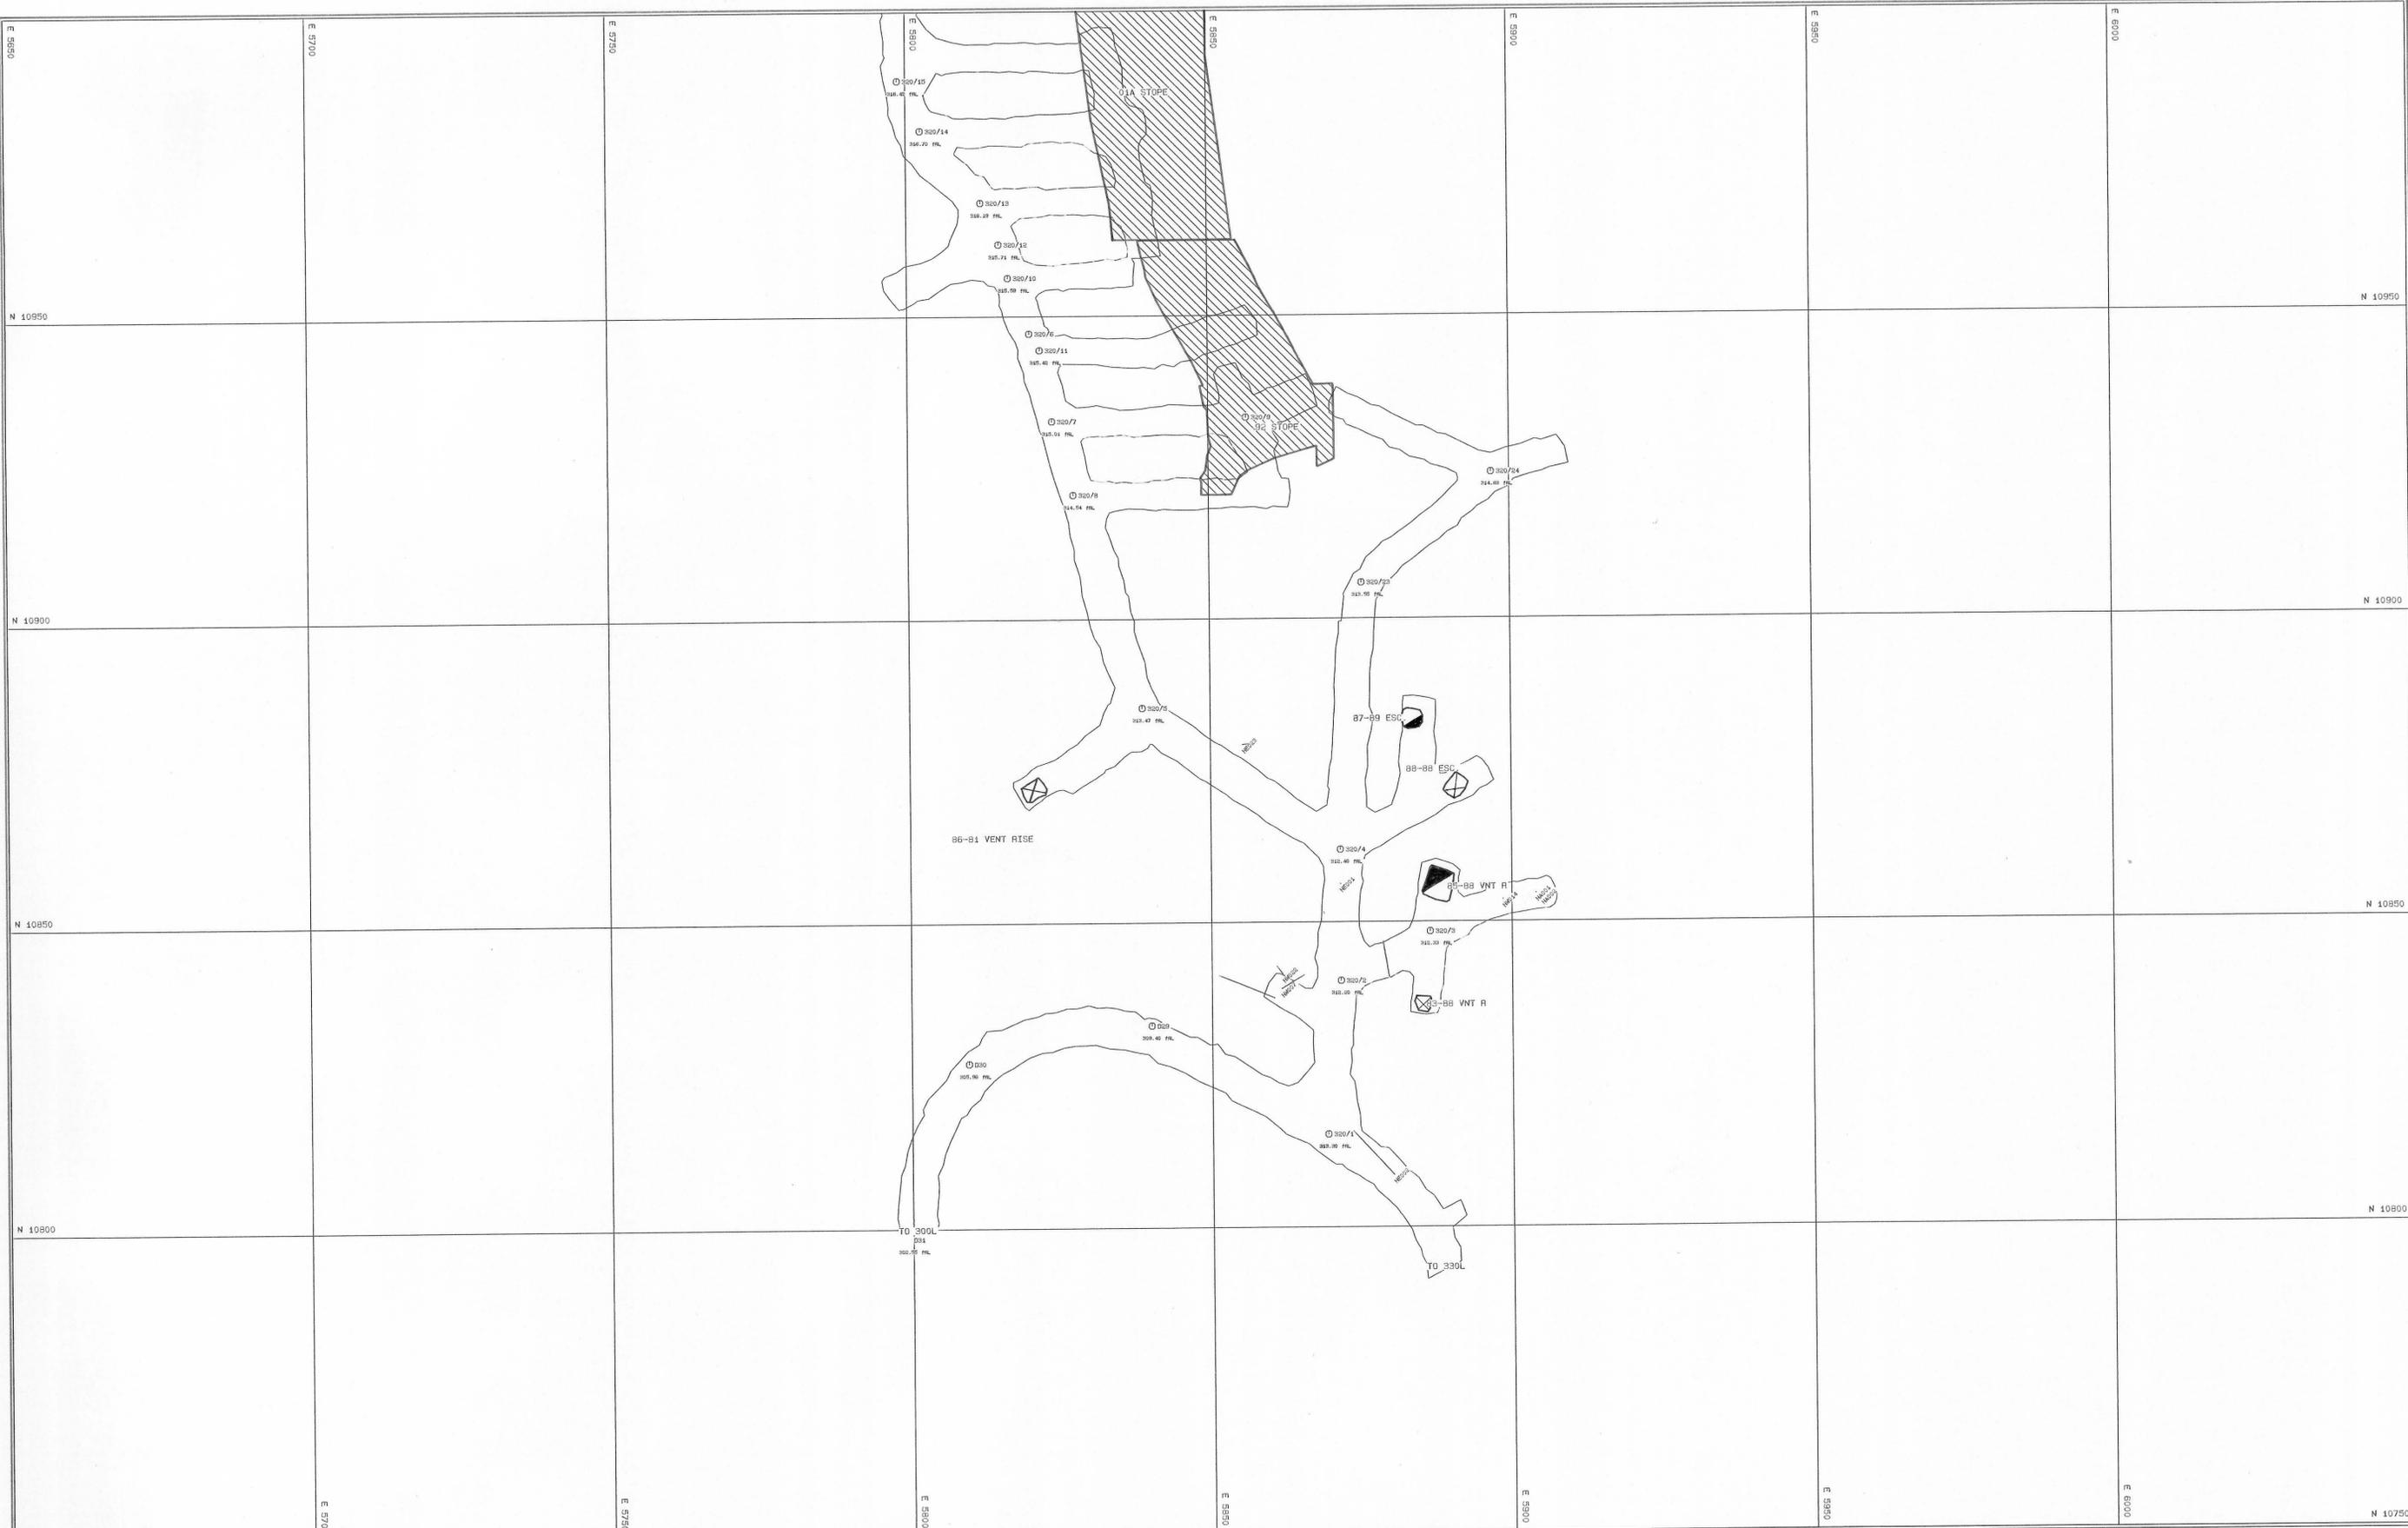

SCALE 1: 500

NORTH

DRAWN	ANS	5-MAR-93
CHECKED	JKY	5-3-93
DESIGNED		
DESIGN CKD.		
DESIGN APP.		
PROJECT APP.		

ABERFOYLE RESOURCES LTD.  
HELLYER DIVISION

HELLYER MINE  
LEVEL PLAN  
320m HORIZON

Drawing No. HEL  
REVISION

ZZZA.PE